


ZIMMERLY ST.  
 EAST KINK ST.  
 VILLAGE DR.  
 DR. (Underground Utilities)

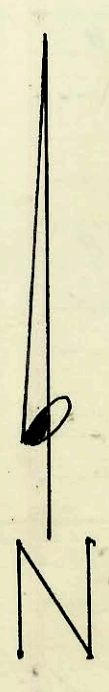

T=150

BOSTON

BARLOW

GRAND AVE.

ADDN. 5

APACHE

HARRY ST.

ST.

APACHE ST.

LAT. 40, W.I.S.  
 W.B. CARTER CONST. CO. 9-28-67  
 PROJ. NO. 027-36 I.H.-3 10-19-67

6655  
 Golf Course

6655  
 G. Hony  
 Golf Park Addition  
 determined to  
 be in BID for  
 Lat 36 with  
 with no further  
 fees due per G.L.M.  
 ASSIST City Engineer  
 3/24/68  
 W.K.

UNPLATTED

LAT 36 W.I.S.  
 Utility Contractors Inc.  
 Proj. C26-25 I.H.-62  
 Lot 9-12-67 Booked 10-4-67

27) map

3+690  
 Std A, M.H.

2000 Exist  
 Conc. M.H.

