


AVE.

FAIRLAWN ACRES
Vacated

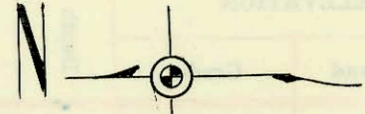

1" = 150'

LAT. 2, SOUTHWEST MAIN

MID-STATES CONST. CO. INC.

PROJ. NO. C27-15 BK. U.K. #6

NOV. 7, 1967

9-13-3-14

33+75.5 M.H.

631.3'

637.4'

287'

30+00.7 M.H.

365.05'

27+20.0 M.H.

405.44'

19+03.0 M.H.

631.5'

16+77.5 M.H.

8545

14+55.5 M.H.

444'

12+29.0 M.H.

431.5'

10+23.5 M.H.

474.9'

7+11.6 M.H.

1421

4+71.5 M.H.

100'

0+47.0 M.H.

121

121

8"

8"

8"

8"

8"

8"

8"

8"

8"

8"

8"

8"

8"

8"

8"

8"

8"

21"

21"

21"

21"

21"

21"

21"

21"

21"

21"

21"

21"

21"

21"

21"

21"

21"

83'

287'

365.05'

405.44'

631.5'

8545

444'

431.5'

474.9'

1421

100'

121

121

121

121

121

121

121






































































































































































































































