


876
 not in benefit district
 private sewer line
 801, 1-2-69
 46677
 Safety
 many things to be done

Confirmed by
 Dye test
 4344 S.
 Seneca
 is tied
 to MH 21491
 BK

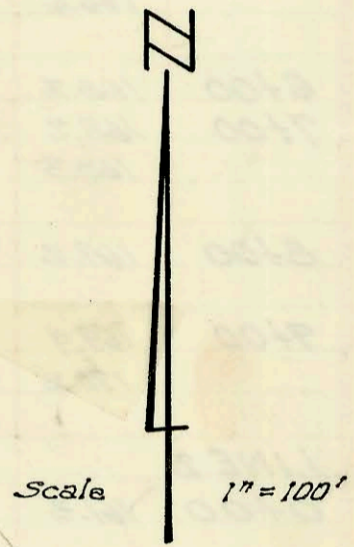

LAT. 4, GLENVILLE SEWER
 MID-STATES CONSTRUCTION CO. INC. 1967
 (PROJ. NO. C24-46) (BOOKED 11-27-67) (JK#3 SAN. SEWER)

2001-00497- 3/7/01- 1010W 41st ST. S. BY L- 4" SCH 40 - 2 TWINCO - Replaced upper 26' from north house stubout and upper 4' from south house stubout

2002-00795 3/20/02 4320 S. Seneca (PRIV. 6" LINE) OVERNIGHT SERV: REPAIR

CONSTRUCTION RECORD

SERVICE RECORD

STATION	ELEVATION		Depth	MANHOLE	4-INCH "Y" BRANCHES		No. of Permit		House Number		DATE OF PERMITS	
	Ground	Grade			North West	South East	North West	South East	North West	South East	North West	South East
Line #1	89.6	83.51	4.1	Exist. 2110°	Beg. Project.							
3+00	89.0	83.65	5.4			2184°		10477	4341 Handley			3-16-84
						3134°						
4+00	89.2	83.80	5.4			3192°		11176				
	89.2	83.81	5.4	4+09°	Top (4+58)			C7033	4332 So Seneca			2-26-68
		in 83.91	5.3		4+32°	4+56.0°		10476	4301 Handley			3-16-84
5+00	88.9	83.95	5.0		4+89°							
					5+01°			11114	4319 Handley			6-6-84
6+00	89.2	84.10	5.1		5+88°	5+76±		C13460	4301 Handley			4-8-69
	89.0	84.12	4.9	6+16±				C62136	4301 Handley			7-19-77
7+00	89.1	84.25	4.9			6+37°		C11911	4235 Handley			7-19-77
8+00	88.8	84.40	4.4			7+00°						12-10-68
						8+20°		C19131	4225 Handley			5-3-00
	89.6	84.52	5.1	8+78°		8+33.7		2000-01381	4055 Handley			6-8-00
						8+97°		C18176	4201 Bartlow Dr.			3-2-70
9+00	89.4	84.55	4.9			9+14°						
10+00	89.3	84.70	4.6			9+41.3°		C18175	4201 Bartlow Dr.			3-2-70
						10+26°			1005 W 41st So.			4-11-79
11+00	89.5	84.85	4.7									
	89.7	84.89	4.8					1200-00497	1010 W 41st St. So.			3-7-01
12+00	89.7	85.13	4.6	11+28°	4" Sub N.W.			C5982				12-4-67
13+00	89.7	85.33	4.4									
	89.5	85.43	4.1	13+50°	6" Sub N.			C6745	4200 S. Seneca			2-5-68
Line #2	0+00	89.6	84.62	5.0	8+78° Ln.#1	0+00°	Beg. Line #2					
1+00	88.9	84.82	4.1									
2+00	89.2	85.02	4.2			1+14°		C48818	1015 W 41st St. So.			3-26-75
						2+47°		2001-00795	1015 W 41st St. So.			4-6-01
								C7215	1015 W 41st St. So.			12-5-69
3+00	88.8	85.22	3.6			2+59°						
	88.6	85.25	3.4	3+14°	4" Sub N.							
Line #3	0+00	89.8	84.99	4.8	11+28° Ln.#1	0+00°	Beg. Ln.#3					
1+00	90.1	85.19	4.9			0+14°		C6479	920-22 W. 41st St. So.			1-19-68
						0+45°						
	90.1	85.25	4.8	1+29°		1+14°		C60104	850 W 41st St. So.			2-25-77
								C6677	816 W 41st St. So.			10-4-82
Line #4	0+00	89.2	83.91	5.3	4+09° Ln.#1	0+00°	Beg. Ln.#4					
1+00	88.8	84.11	4.7			0+29°						
						1+00°		C7032	4330 So Seneca			2-26-68
						1+63°						
2+00	88.8	84.31	4.5			1+89°						
	88.6	84.41	4.2	2+49°	4" Sub S.W.							
Line #5	0+00	88.9	84.22	4.7	6+16° Ln.#1	0+00°	Beg. Ln.#5					
1+00	88.6	84.41	4.2			0+53°						
	88.2	84.55	3.7	1+69°	4" Sub S.W.			C26348	4300 S Seneca			1-7-91
								53410				10-28-76

Periv. LINE

C13462-trailer #1	4320 S Seneca	4/8/69	1485
C13463-trailer #2	"	"	2+27
C13464-trailer #3	"	"	1+60
C13465-trailer #4	"	"	1+10
C13466-trailer #5	"	"	0+23
C13467-trailer #6	"	"	"

C13461 - Concrete Line 4320 S Seneca 4-8-69 - in N (2+62) Davis Trenching
 C53705 - 4330 S. Seneca (R) 1471.1 & 270 with 4" pipe
 99-10549-7 5-25-99 1015 W 41st St S. - storm damaged house - sewer line to be capped under Bldg foundation - K's DHW line 4" clay slo 56.5' E of WPC and 107' N of SR