L 140A

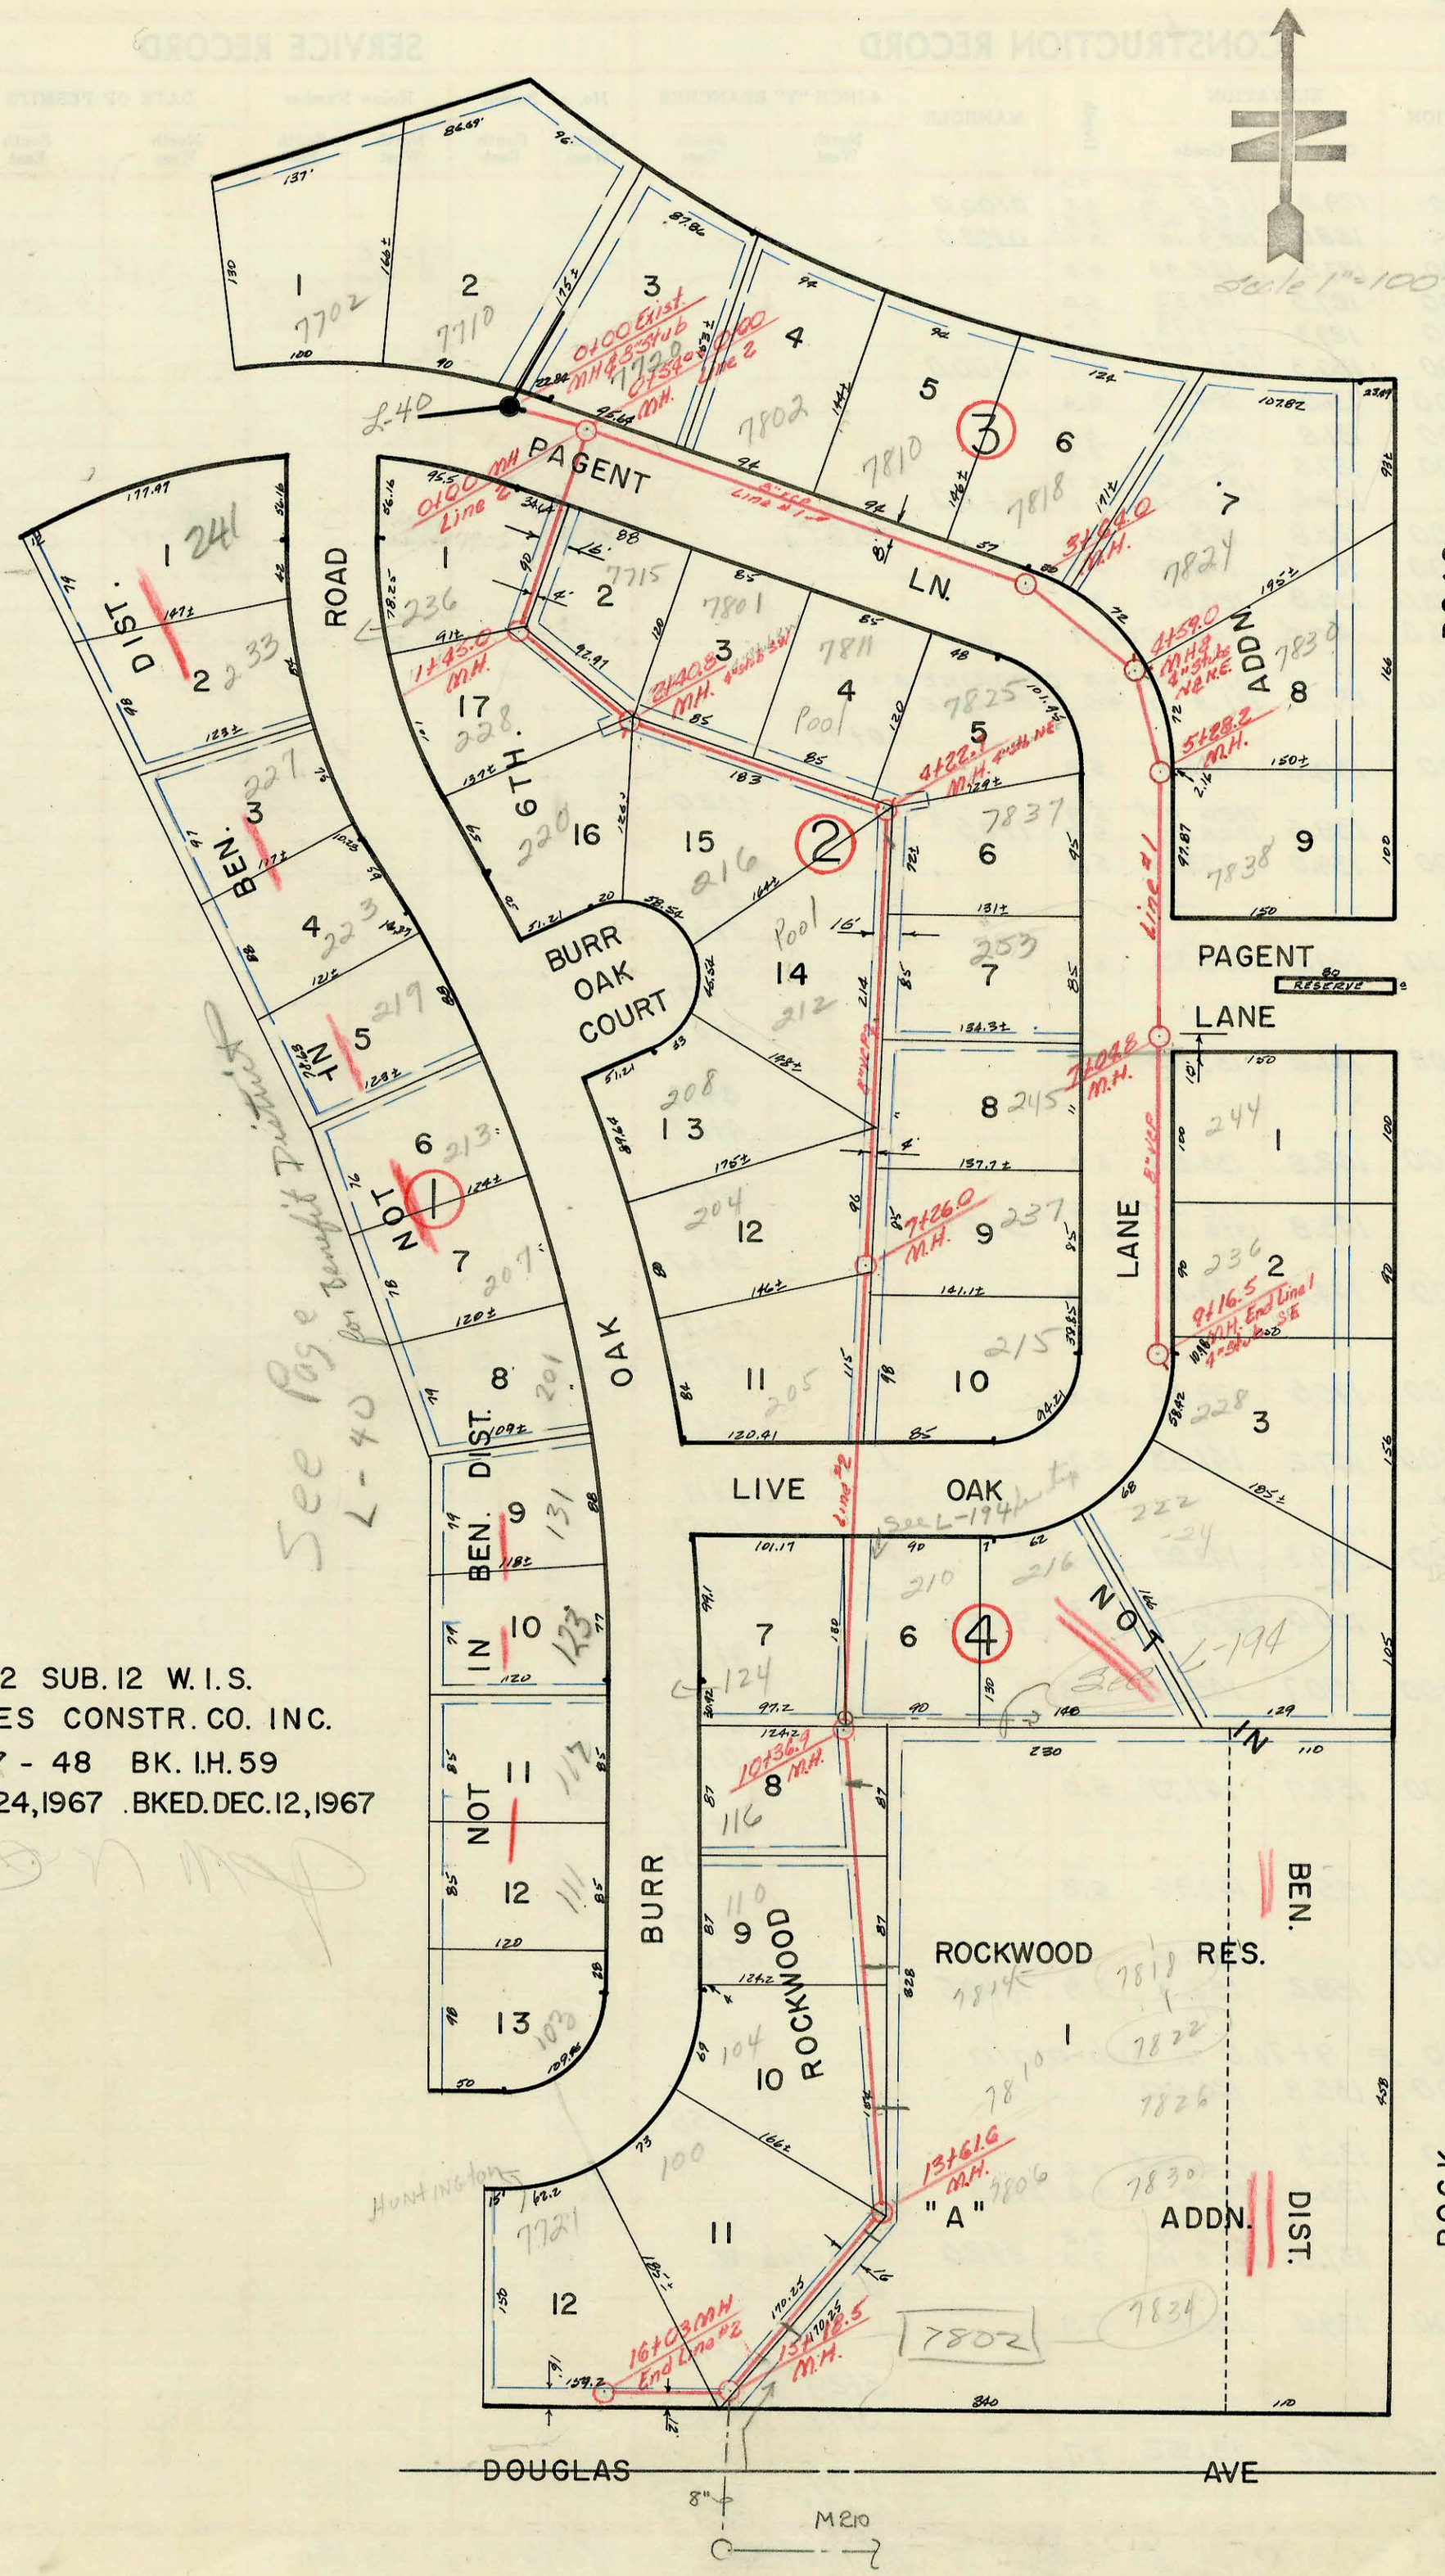

LAT. 12 SUB. 12 W.I.S.
MID STATES CONSTR. CO. INC.
PROJ. C 27 - 48 BK. I.H. 59
LET OCT. 24, 1967 . BKED. DEC. 12, 1967

140

Form 42-020

CONSTRUCTION RECORD							SERVICE RECORD					
STATION	ELEVATION		Depth	MANHOLE	4-INCH "Y" BRANCHES		No. of Permit		House Number		DATE OF PERMITS	
	Ground	Grade			North West	South East	North West	South East	North West	South East	North West	South East
LINE 1												
0+00	160.0	151.13	8.9	Existing Manhole & 8" Stub								
+05				Beg. Project								
	161.3	151.94	9.4	0+54.0 = 0+00 Line #2								
					0+56.6							
1+00	162.6	152.63	10.0		Top 1+04		C29421		7720 present house		12-13-71	
					1+46.6							
2+00	164.3	154.13	10.2		Top 1+71		C33912		7802 Pagent		7-27-72	
					Top 2+39.0							
3+00	165.1	155.63	9.5		2+87		C24680		7810 Pagent		6-2-71	
					3+35.9 top 2+35.8		3506		7818 Pagent		6-16-81	
	165.8	156.61 Out 156.71 In	9.2	3+64.0								
4+00	165.9	157.02	8.9									
	165.8	157.58 Out 157.68 In	8.2	4+59.0	4" Stub N	4" Stub E	C43983	C35459	7824 Pagent	7830 Pagent	3-15-74	10-17-72
5+00	166.1	158.02	8.1									
	166.4	158.34 Out 158.44 In	8.1	5+28.2								
						5+45.7						
6+00	168.2	159.02	9.2			5+79		C10057		7838 Pagent Dr.		8-15-68
7+00	168.2	159.92	8.3									
	168.3	160.04	8.3	7+04.8								
						7+38.0		C9498		244 Live Oak		7-8-68
8+00	169.2	160.82	8.4									
						8+40.1						
9+00	169.9	161.72	8.2			8+55		C8313		236 Live Oak		5-16-68
	170.5	161.85	8.7	9+16.5 End Line #1		4" Stub S E		C38841		228 Live Oak		5-8-73
LINE 2												
0+00	161.3	151.94 Out 152.04 In	9.4	Exist. Manhole 0+54 Line #1								
					0+75.4	0+77.4						
1+00	160.7	152.94	7.8		1+06	Top	C23967		236 Burr Oak		4-27-71	
	161.8	153.34 Out 153.44 In	8.5	1+45.0								
					1+72.8	Top 1+99 1+74.8	C23968	C39497	228 Burr Oak	7815 Pagent	4-27-71	6-13-73
2+00	162.0	153.94	8.1									
	162.6	154.30 Out 154.40 In	8.3	2+40.8	4" Stub S.W.		C29598		220 Burr Oak		12-21-71	
					2+69.0	2+71.0						
3+00	164.7	154.94	9.8		Top 2+87	3+03	C34697	C6335	7801 Pagent	216 Burr Oak	9-5-72	1-5-68
					3+59.7	3+57.7	C7392		7811 Pagent Dr.		3-20-68	
4+00	166.2	155.84	10.4									
	166.6	156.03 Out 157.26 In	10.6	4+22.7	4" Stub N.E.							
					4+48.3	4+46.3		C37905		7837 Pagent Dr.		3-26-73
5+00	167.4	157.81	9.6									
					5+17.9	5+15.9		C41405		253 Live Oak		9-25-73
6+00	168.5	158.51	10.0		Top 5+62		C6715		212 Burr Oak Ct		2-1-68	
						6+08.6						
					Top 6+35 6+32.0	6+41.0	C33367		208 Burr Oak		7/5/72	
					6+58.0							
						6+95.2		C8092		237 Live Oak		5-1-68
7+00	169.4	159.21	10.2		7+08.0		Top 27876		204 Burr Oak		9-13-71	
	170.0	159.39 Out 159.50 In	10.6	7+26.0								
					7+80.5	7+78.5	C8305	C28748	205 Live Oak	215 Live Oak	5-15-68	10-27-71
8+00	170.5	159.80	10.7									
9+00	171.6	160.20	11.4									
					9+45.1	9+43.1						
10+00	172.1	160.60	11.5		Top 9+88		C6827		124 Burr Oak		2-12-68	
	172.2	160.75	11.4	10+36.9								
					10+73.7	10+71.7	C8084		116 Burr Oak		5-1-68	
11+00	172.4	161.00	11.4									
					Top 11+75.3 11+45.3		C37904		110 Burr Oak		3-26-73	
12+00	172.7	161.40	11.3									
					Top (wye not here) 12+49.7	12+47.7	C37903		104 Burr Oak		3-27-73	
13+00	172.8	161.80	11.0									
					13+11.0							
	173.0	162.04 162.13	11.3	13+61.6								
					13+99.0	13+95.0	C45348		100 Burr Oak		6-14-74	
14+00	172.7	162.30	10.4									
					14+64.0							
15+00	172.7	162.70	10.0									
	172.8	162.77 Out 162.85 In	10.0	15+18.5	Top 15+93.0 15+96.5		C37901		7721 Huntington		3-27-73	
16+00												
	172.6	163.20	9.4	16+03.0	End Line #2							

#C10399 - 7806 E. Douglas - Joe Spaulding - 9-9-68 (Top 14+61.6)
#C10400 - 7806 E. Douglas " " " (Top 13+77.6)
#C10401 - 7810 E. Douglas " " " (Top 12+93.6)
#C10402 - 7818 E. Douglas " " " (Top 11+99.6)
#C10403 - 7826 E. Douglas " " " (Top 10+75.6)