L-165 A

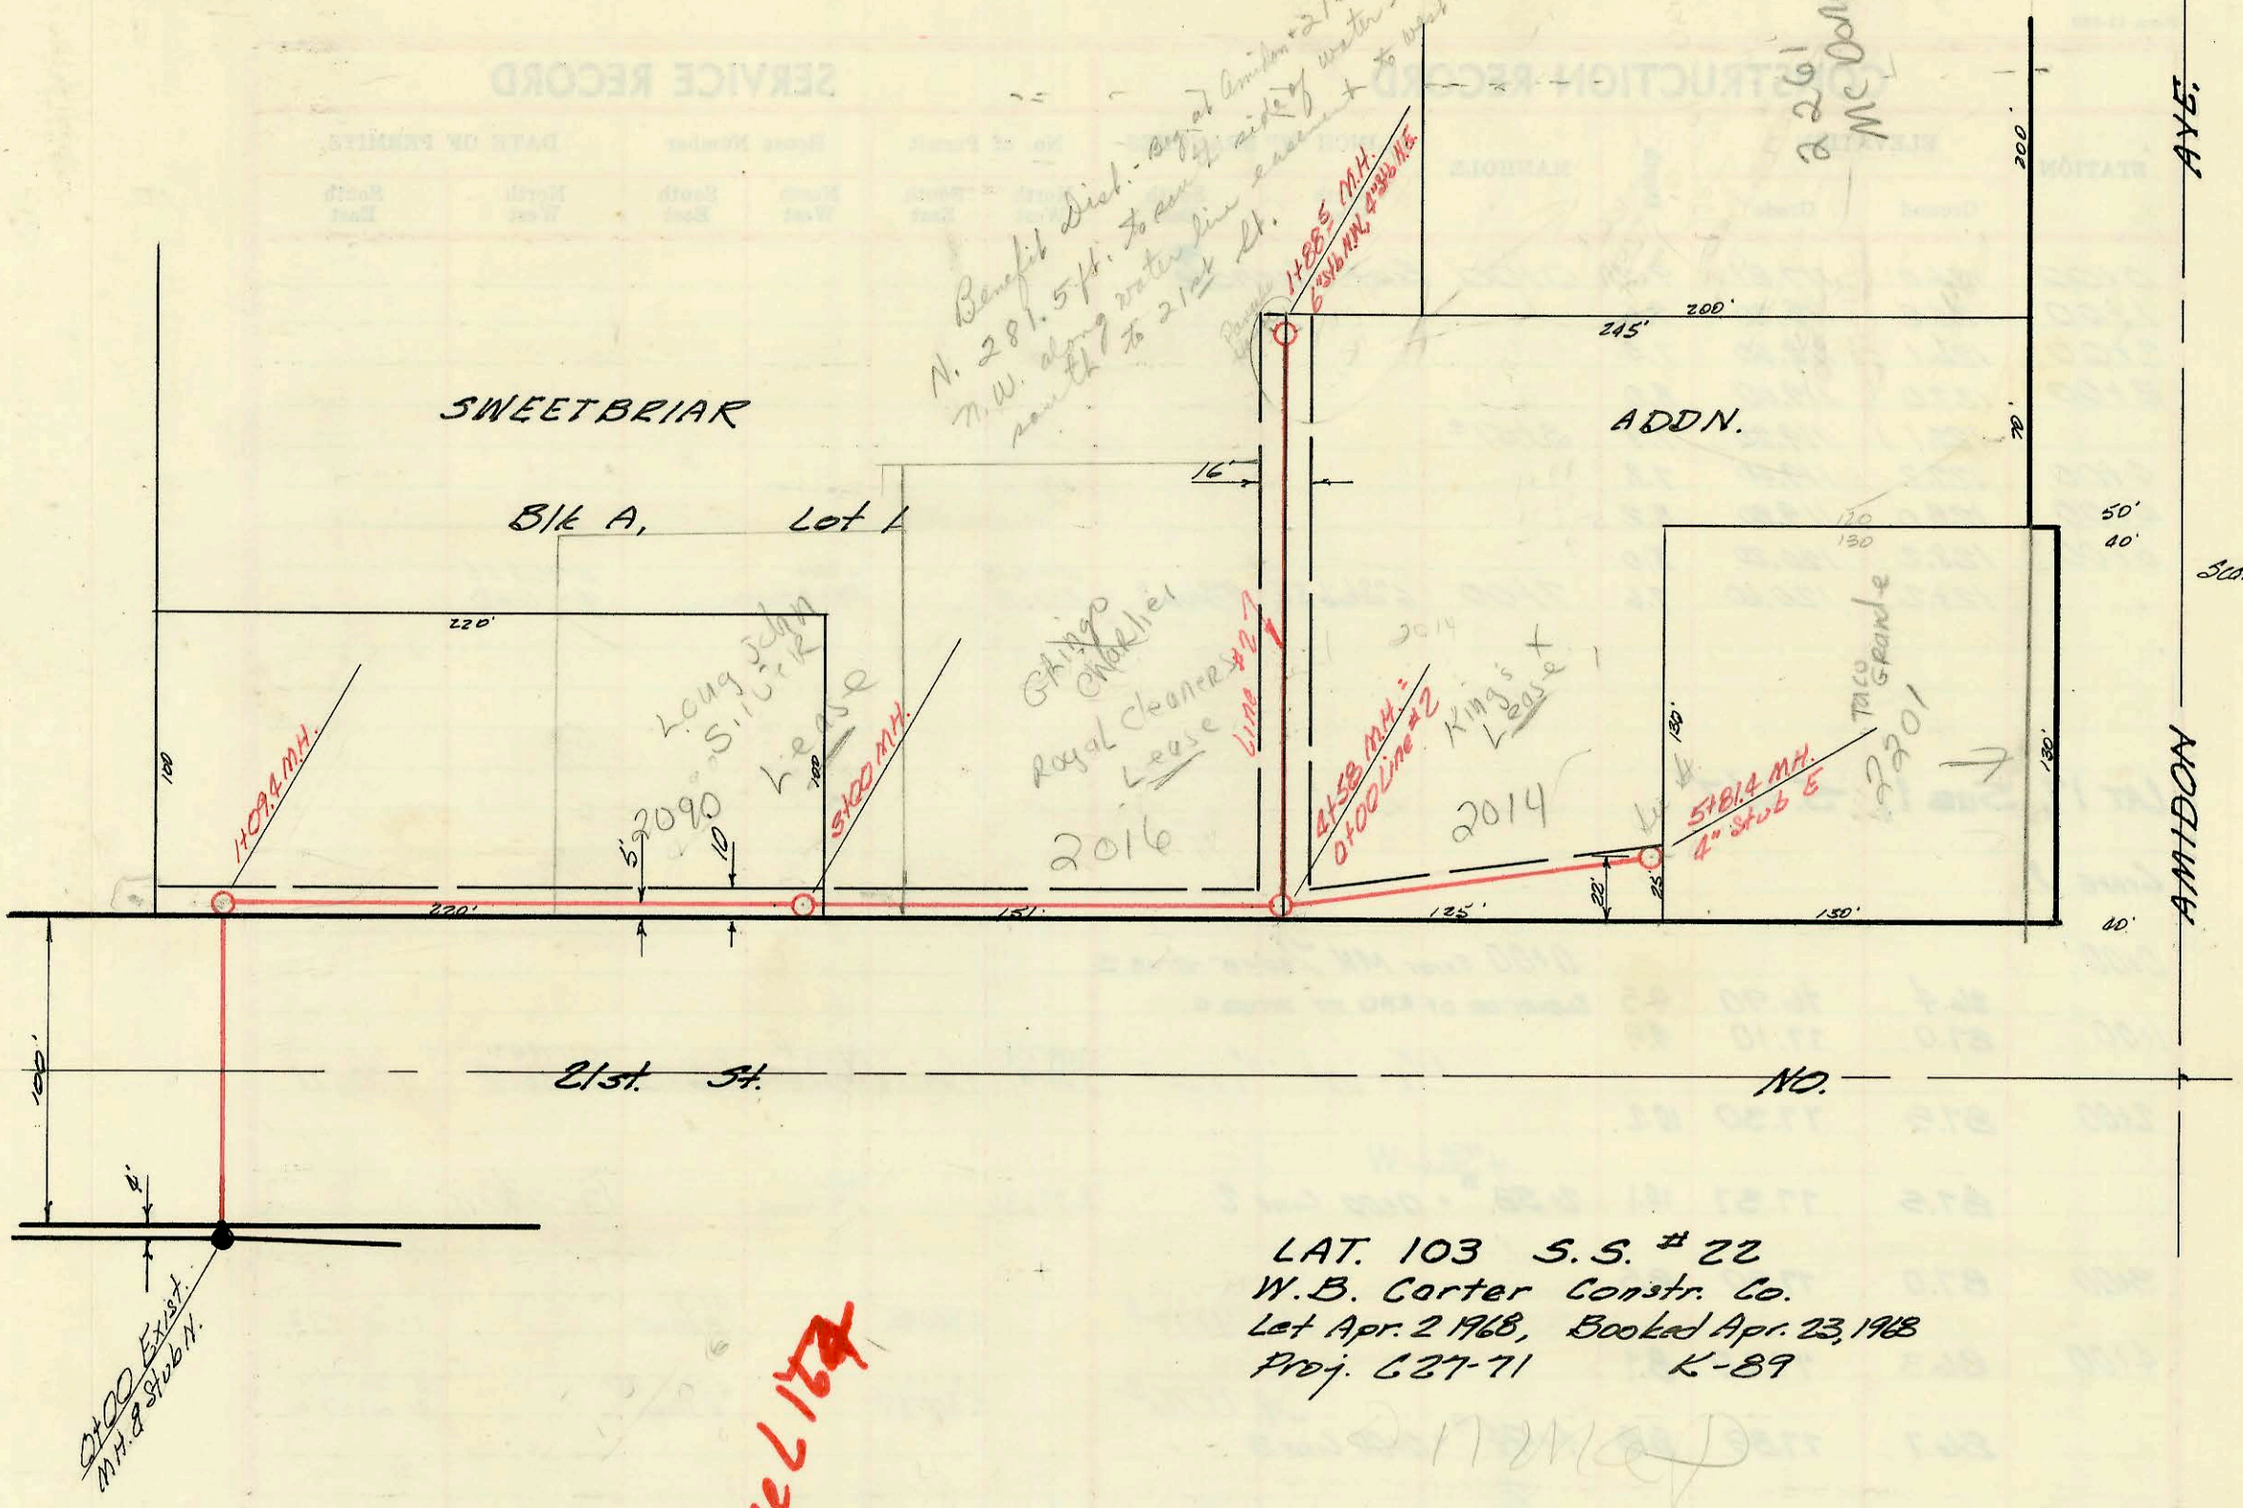

LAT. 103 S.S. # 22
W.B. Carter Constr. Co.
Let Apr. 2 1968, Booked Apr. 23, 1968
Proj. C27-71 K-89

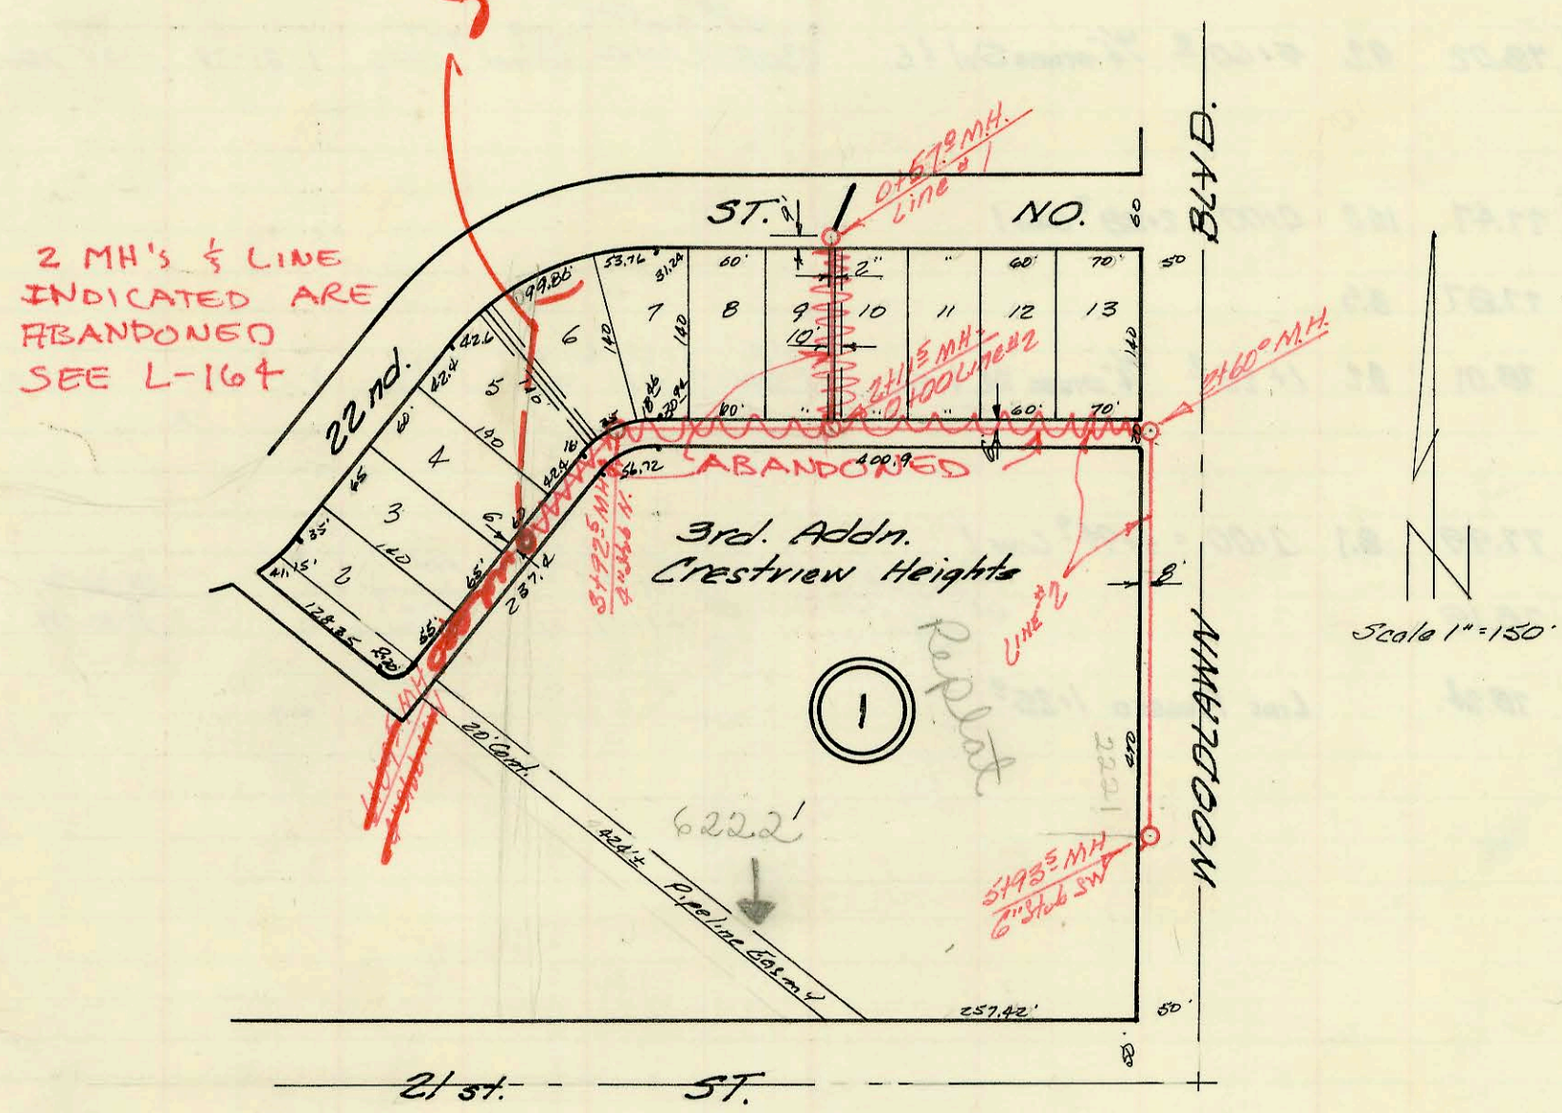

LAT. 22 SUB 5, S.S. # 23
Mid-States Constr. Co Inc.
Let. Mar. 12, 1968 Booked Apr. 23, 1968
Proj C26-51 K-87

165

Form 42-020

CONSTRUCTION RECORD							SERVICE RECORD					
STATION	ELEVATION		Depth	MANHOLE	4-INCH "Y" BRANCHES		No. of Permit		House Number		DATE OF PERMITS	
	Ground	Grade			North West	South East	North West	South East	North West	South East	North West	South East
LAT. 103. S.S. #22												
	127.0	118.20	9.8	0+00	Exist MH & Stub N							
1+00												
	126.9	118.42 out 118.52 In	8.5	1+09.4								
2+00	127.4	118.70	8.7									
	127.3	118.90	8.4	3+00°	2+85 Tap	Maybe tapped in MH. 3+00 instead 9-17-96	C44659		2090 W 21ST	Long Johns	5-13-74	
4+00	127.3	119.10	8.2									
	127.6	119.22	8.4	4+58°	= 0+00 LINE #2							
5+00	127.3	119.30	8.0									
	127.9	119.56	8.3	5+81⁴		4" Stub E		#C37584		2201 N Amidon		3-6-73
LINE #2												
	127.6	119.31	8	0+00 =	4+58° LINE #1							
1+00	127.6	119.52			0+92.6 tap		2004-2485 C53227		2016 S.W. 21st N.	Grand Chariot	9-15-04 1-14-96	
						1+74°		C7875	David	2014 W 21st		4-16-68
	125.8	119.70	6.1	1+88⁵	6" Stub NW	4" Stub N.E.	C9183	C7828	2263 Amidon	2261 N Amidon	8-8-68	4-11-68
							96-202-7			2261 N Amidon McDonald		1-8-96
LAT. 22, Sub 5, S.S. #23												
	194.5	182.90	11.6	0+57°	New M.H.							
1+00	194.5	183.03	11.5									
2+00	194.6	183.33	11.3									
	194.6	183.37 out 186.40 In	11.2	2+11⁵	= 0+00 Line #2							
					2+30⁵							
					2+89°							
3+00	196.3	187.81	8.5									
					3+44⁵							
	197.9	189.30 out 189.40 In	8.6	3+92⁵	4" Stub N							
4+00												
					4+30⁵							
					4+88⁵							
5+00	199.0	190.15	8.8									
					5+50							
6+00	200.3	190.85	9.4									
	200.4	190.92	9.5	6+09⁵	4" Stub NW							
LINE #2												
	192.3	183.45	8.8	0+00 =	2+11⁵ LINE #1							
					0+22°							
					0+79°							
1+00	192.2	183.77	8.4									
					1+40⁵							
2+00	193.8	184.07	9.7									
					2+02⁵							
	194.0	184.25 out 184.34 In	10.7	2+60°								
3+00	195.1	185.10	10.0									
4+00	197.0	187.00	10.0		4+67.3 tap		9236		2221 N Woodlawn		11-29-83	
5+00	198.6	188.90	9.7									
	200.0	190.69	9.3	5+95⁵	6" Stub S.W.		C75066 C7920		6330 E 21st		10-26-78 4-18-63	

C73843-6330 E. 21st. - New Conn. 8-23-79 - 6" Stub in M.H. (5+93.5)

96-000202-7 1-8-96 2261 N Amidon - N/C - McDonald's Rest -