L 169 A

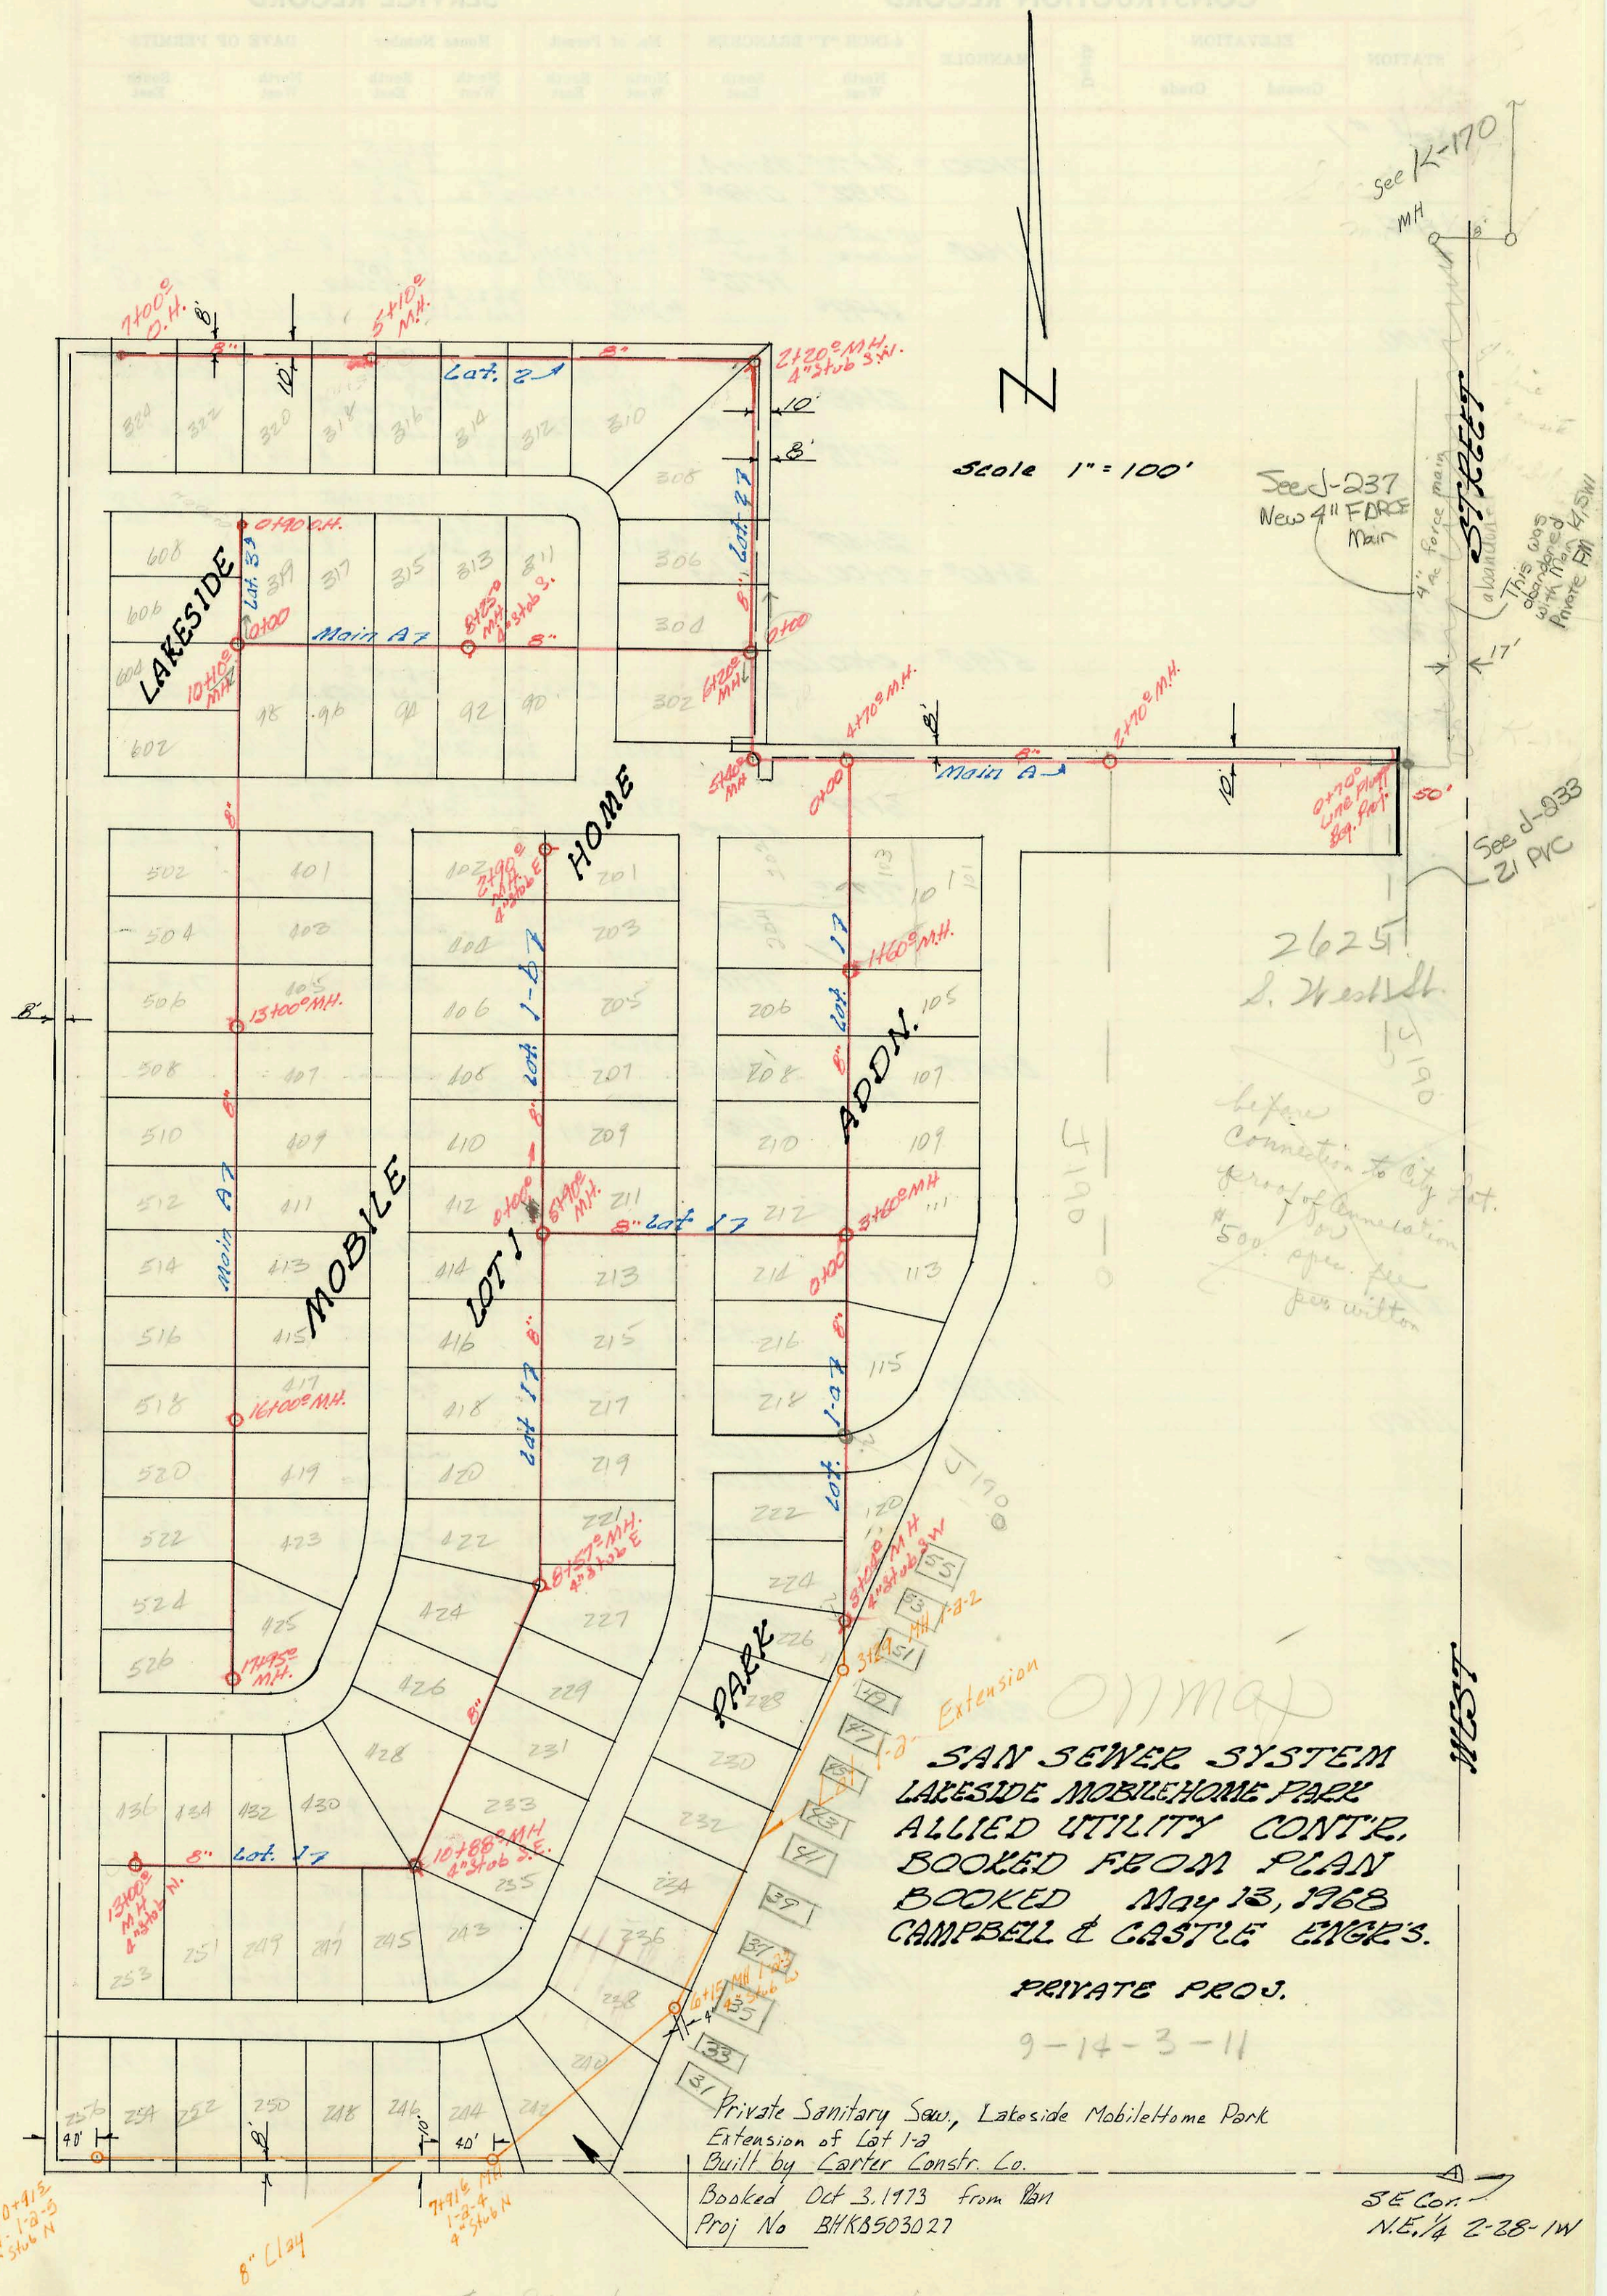
Scale 1" = 100'
N
See K-170
MH
See J-237
New 4" FORCE Main
4" Ac force main
abandoned
This was abandoned with Main 4/5/71
STATE
17'
See J-233
21 PVC
2625
S. West St.
LAKESIDE
HOME
ADDN.
MOBILE
LOT 1
PARK
Main A
Lot. 1-A
Lot. 1-B
Lot. 17
Lot. 33
Lot. 27
7+00 O.H.
5+10 M.H.
2+20 MH 4" Stub S.W.
0+90 O.H.
8+25 MH 4" Stub S.
10+10 MH
4+70 M.H.
2+70 M.H.
5+40 MH
0+00
0+70 Line Plug Sq. Fot.
50'
2+90 MH 4" Stub E
13+00 MH.
1+60 M.H.
6+90 MH
3+60 MH
16+00 MH.
8+57 MH 4" Stub E
17+95 MH.
10+88 MH 4" Stub S.E.
13+00 MH 4" Stub N.
6+15 MH 1-A-2 4" Stub W
3+29 MH 4" Stub SW
1-A Extension
10+91 MH 1-A-5 4" Stub N
7+91 MH 1-A-4 4" Stub N
8" CI 34
40'
WEST
SAN SEWER SYSTEM
LAKESIDE MOBILEHOME PARK
ALLIED UTILITY CONT'R.
BOOKED FROM PLAN
BOOKED May 13, 1968
CAMPBELL & CASTLE ENGR'S.
PRIVATE PROJ.
9-14-3-11
Private Sanitary Sew., Lakeside Mobilehome Park
Extension of Lat 1-a
Built by Carter Constr. Co.
Booked Oct 3, 1973 from Plan
Proj No BHKB503027
SE Cor. N.E. 1/4 2-28-1W
See Sheets 170 & 171

C-169

Form 42-020

CONSTRUCTION RECORD							SERVICE RECORD					
STATION	ELEVATION		Depth	MANHOLE	4-INCH "Y" BRANCHES		No. of Permit		House Number		DATE OF PERMITS	
	Ground	Grade			North West	South East	North West	South East	North West	South East	North West	South East
Main A												
0+70					Beg. Proj.							
1+00												
2+00												
				2+70.0								
3+00												
4+00												
				4+70.0	= 0+00 Lot #1							
5+00												
				5+40.0								
					5+57.0		C9294		2625 S. West Lot 302		6-26-68	
6+00												
				6+20.0	= 0+00 Lot. #2							
7+00						7+64.0		C9295		2625 S. West Lot 90		6-26-68
					7+96.0		#C9315		2625 S. West Lot 311		6-27-68	
8+00												
				8+25.0		4" Stub S.		C9296		2625 S. West Lot 92		6-26-68
					8+48.0		#C9316		2625 S. West Lot 313		6-27-68	
						8+70.5		C9297		2625 S. West Lot 94		6-26-68
					8+97.0		#C9317		2625 S. West Lot 315		6-27-68	
9+00												
						9+18.5		C9298		2625 S. West Lot 96		6-26-68
					9+56.0		#C9318		2625 S. West Lot 317		6-27-68	
						9+68.0		C9299		2625 S. West Lot 98		6-26-68
					9+99.0		#C9319		2625 S. West Lot 319		6-27-68	
10+00												
				10+10.0	0+00 Lot. #3							
					10+49.0		#C9312		2625 S. West Lot 604		6-27-68	
11+00					11+00		#C9311		2625 S. West Lot 602		6-27-68	
						11+62.0		C9351		2625 S. West Lot 401		6-28-68
					11+90.0		C9359		2625 S. West Lot 502		6-28-68	
12+00												
						12+11.0		C9352		2625 S. West Lot 403		6-28-68
					12+37.0		C9360		2625 S. West Lot 504		6-28-68	
						12+64.0		C9353		2625 S. West Lot 405		6-28-68
					12+81.0		C9361		2625 S. West Lot 506		6-28-68	
				13+00.0								
						13+09.0		C9354		2625 S. West Lot 407		6-28-68
					13+41.0		C9362		2625 S. West Lot 508		6-28-68	
						13+58.0		C9355		2625 S. West Lot 409		6-28-68
					13+88.0		C9363		2625 S. West Lot 510		6-28-68	
14+00												
						14+17.0		C9356		2625 S. West Lot 411		6-28-68
					14+49.0		C9364		2625 S. West Lot 512		6-28-68	
						14+66.0		C9357		2625 S. West Lot 413		6-28-68
					14+98.0		C9365		2625 S. West Lot 514		6-28-68	
15+00												
						15+06.0		C9358		2625 S. West Lot 415		6-28-68
					15+41.0		C9366		2625 S. West Lot 516		6-28-68	
						15+60.0		C9386		2625 S. West Lot 417		7-1-68
					15+90.0		C9390		2625 S. West Lot 518		7-1-68	
				16+00.0								
						16+07.0		C9387		2625 S. West Lot 419		7-1-68
					16+45.0		C9391		2625 S. West Lot 520		7-1-68	
						16+62.0		C9388		2625 S. West Lot 423		7-1-68
					16+90.0		C9392		2625 S. West Lot 522		7-1-68	
17+00												
						17+10.0		C9389		2625 S. West Lot 425		7-1-68
					17+43.0		C9393		2625 S. West Lot 524		7-1-68	
					17+80.0		C9394		2625 S. West Lot 526		7-1-68	
				17+95.0	End Main A.							