L172A

FROM Geo. Wilton Public Works Department City Of Wichita	TO Sayler Construction Co., Inc. 447 WESTFIELD CT. WICHITA, KANSAS 67212

SUBJECT: Lot 1, Block 1, Western Garden's Additon
1002 Waddington Ave.

DATE: 3/19/71

FOLD ↑

Mr. Wilton.

This letter is for your records and for the understanding that additional sewer tax's will be added to this lot when the sewer is extended in this area.

Earl M Sayler

Earl M. Sayler, Sec.

George Justice
Permit #23181 - 3/30/71

L172

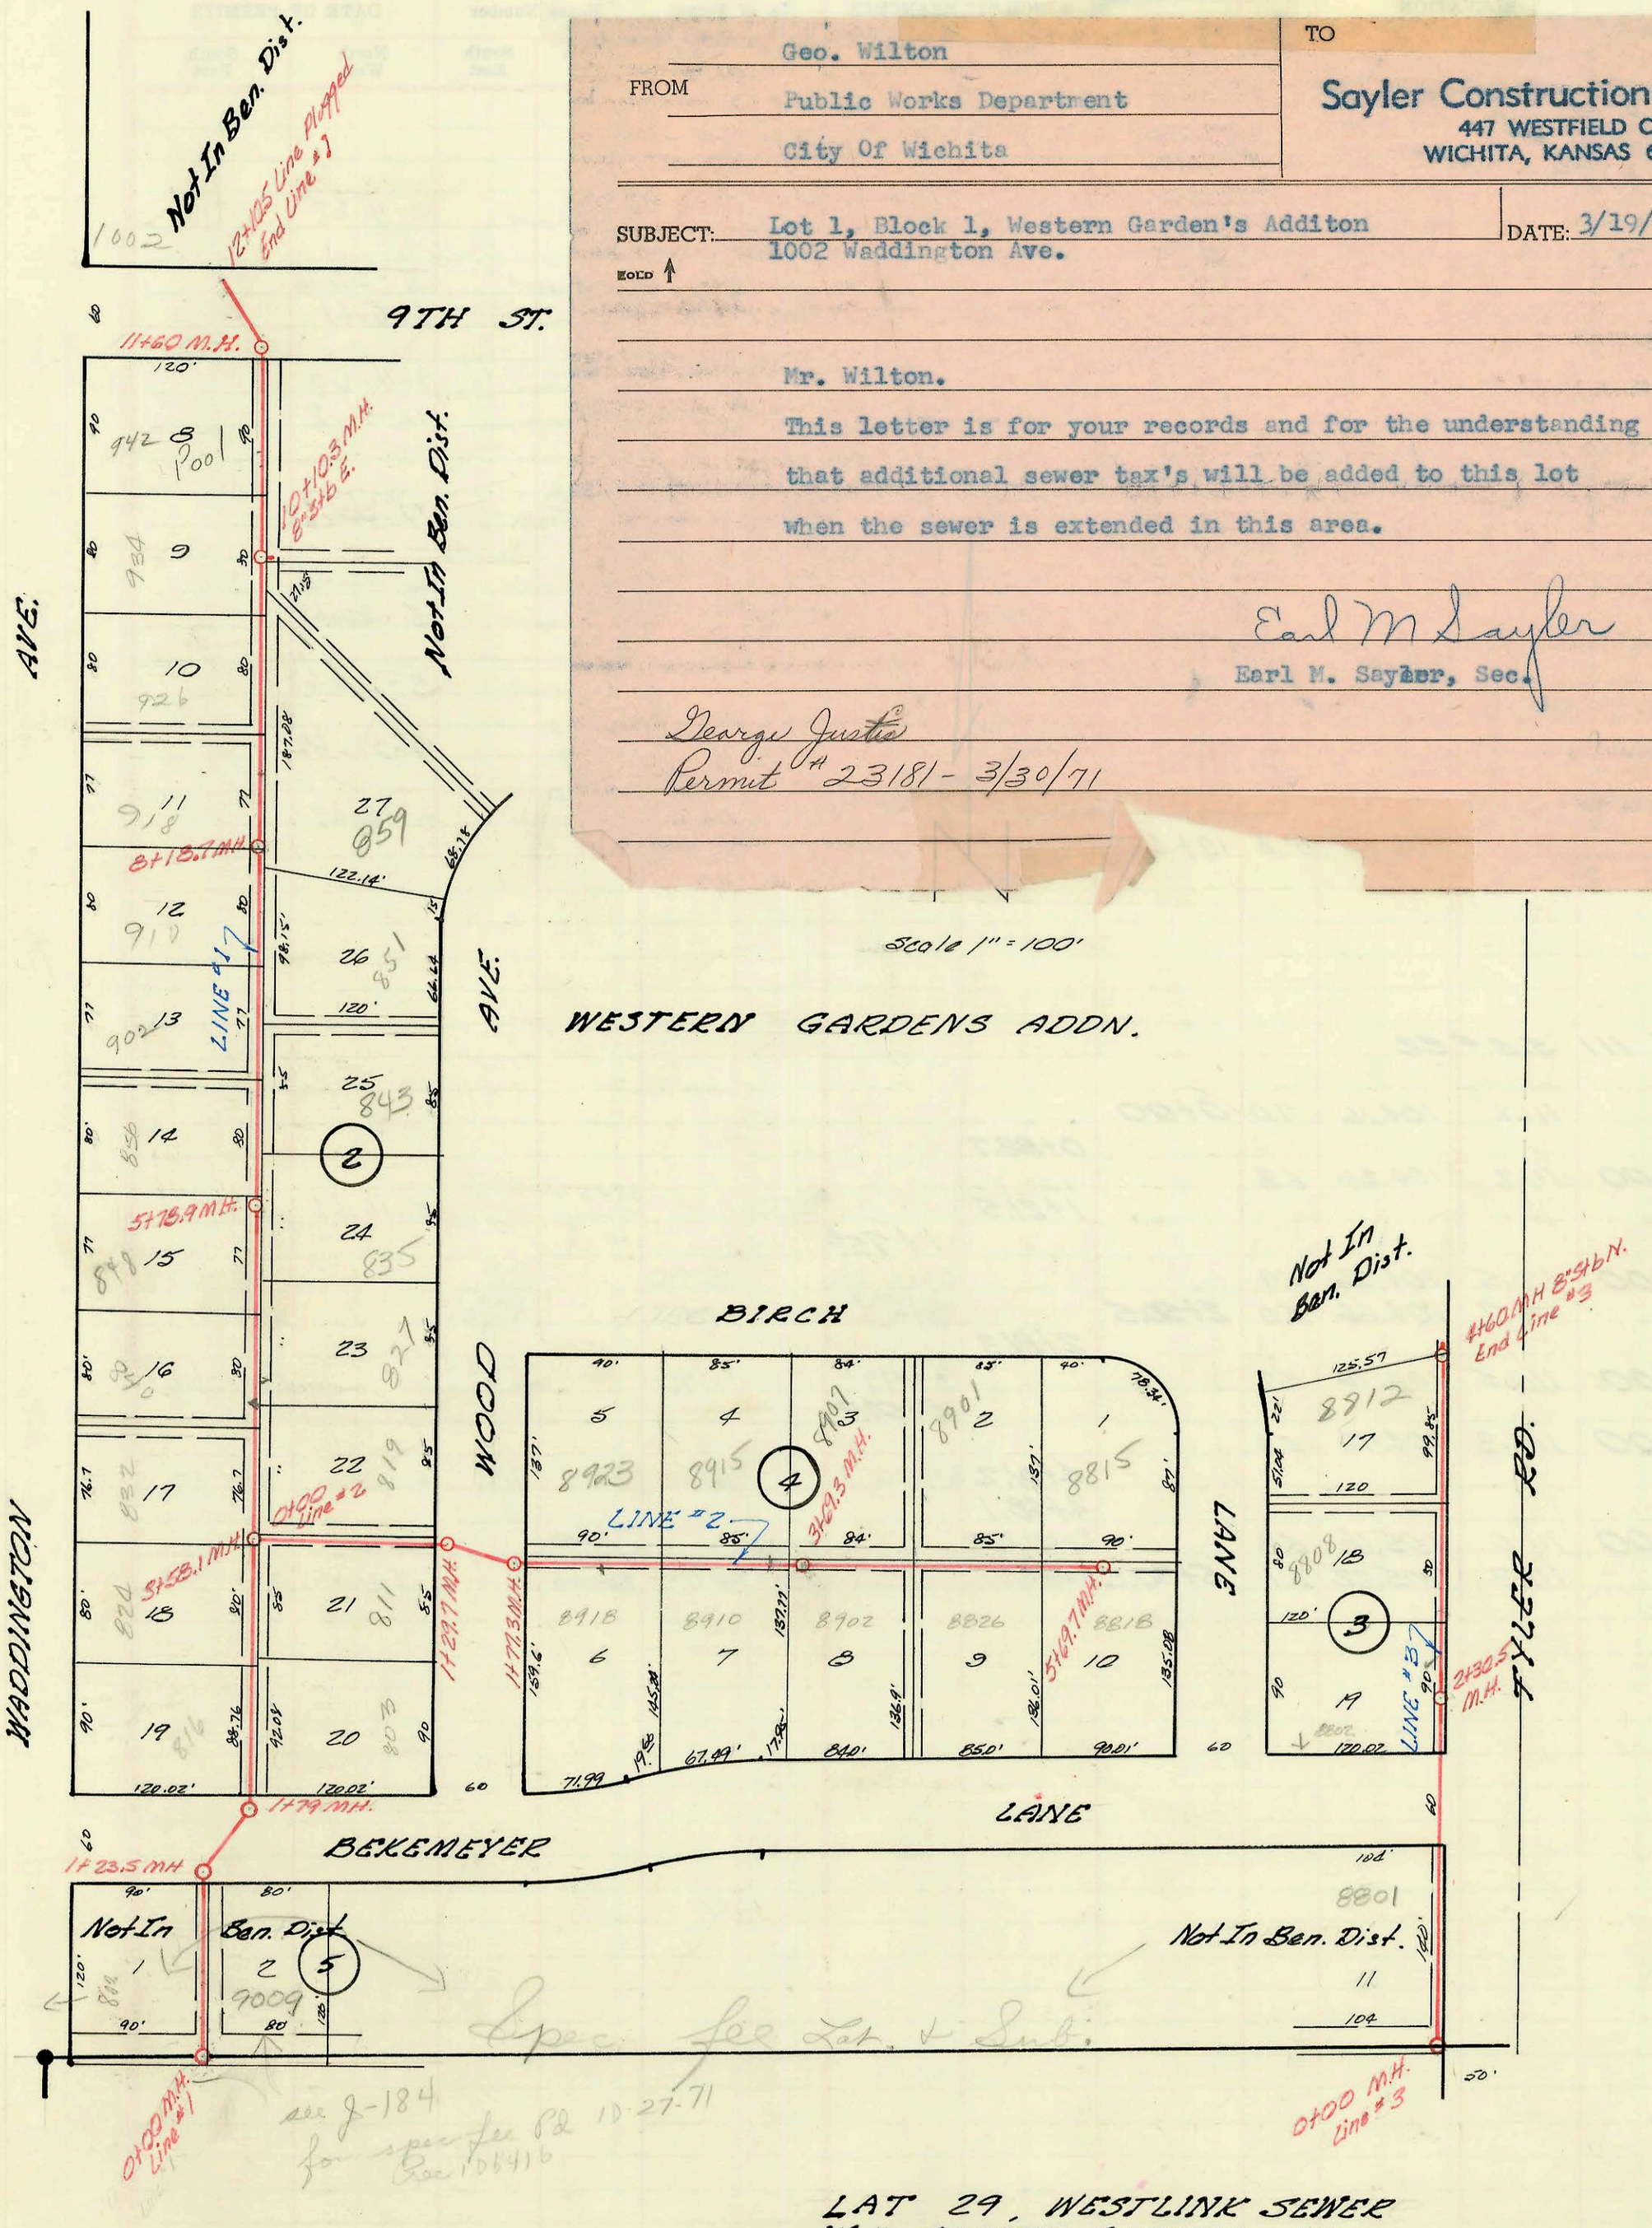

SCALE 1" = 100'

WESTERN GARDENS ADDN.

LAT 29, WESTLINK SEWER
W.B. CARTER CONSTR. CO.
CET 3-16-68 BOOKED 5-18-68
PROJ. NO. C27-52 S.S. J.A.K. #9.

on map

C-172

Form 42-020

CONSTRUCTION RECORD							SERVICE RECORD					
STATION	ELEVATION		Depth	MANHOLE	4-INCH "Y" BRANCHES		No. of Permit		House Number		DATE OF PERMITS	
	Ground	Grade			North West	South East	North West	South East	North West	South East	North West	South East
LINE #1												
0+00	144.0	135.04	9.0	0+00	Begin							
1+00	143.7	135.29	8.4		top (0+41)		#C32509		802 Waddington		2-28-73	
	144.1	135.35 out 135.45 In	8.7	1+23.5								
	144.3	135.58 out 135.68 In	8.7	1+79.0								
2+00	144.3	135.74	8.6									
					2+15	2+13	C18403	C8339	816 Waddington	803 Wood	3-18-70	5-17-68
					2+98	2+96	C8302	C39824	824 Waddington	811 Wood	5-15-68	7-2-73
3+00	145.0	135.99	9.0									
	145.1	136.14	9.0	3+58.1								
					3+82	3+80	C8303	C37067	832 Waddington	819 Wood	5-15-68	2-6-73
4+00	145.7	136.24	9.5									
					4+49	top 4+60.1 4+61	C9369	C38832	840 Waddington	821 Wood	6-28-68	5-8-73
5+00	145.7	136.49	9.2									
					5+20.7		#C10688		848 Waddington		9-26-68	
						5+42.7		C32709		835 Wood		6/7/72
	146.1	136.69	9.4	5+78.9								
6+00	146.2	136.74	9.5									
					6+05		C8338		856 Waddington		5-17-68	
						6+27		C35456		843 Wood		10-18-72
					6+83							
7+00	146.9	136.99	9.9		top 7+11.9		C16430		902 Waddington		10-22-69	
						7+16		C36759		851 Wood		1-17-73
					7+56.5		C21886		910 Waddington		11-20-70	
8+00	147.4	137.24	10.2									
	147.5	137.29	10.2	8+18.7								
						8+30.5		C39825		859 Wood		7-2-73
					8+41		C17433		918 Waddington		12-22-69	
9+00	148.0	137.49	10.5			8+69.7		C39825		859 Wood		7-2-73
					9+18		C22968		926 Waddington		2-17-71	
					9+94.6		C8304		934 Waddington		5-15-68	
10+00												
	148.1	137.77 out 137.87 In	10.3	10+10.3		8" Stub E						
					10+81		C24206		942 Waddington		5-7-71	
11+00	148.5	138.48	10.0									
	148.9	138.96 out 139.06 In	9.9	11+60								
12+00												
12+10.5	149.0	139.48	9.5	End Line #1	Plugged		C23181		1002 Waddington		3-30-71	
LINE #2												
	145.1	136.14 out 136.24 In	9.0	0+00 = 3+58.1 Line #1								
1+00	144.8	136.49	8.3									
	145.1	136.57 out 136.67 In	8.5	1+29.7								
	144.9	136.79 out 136.89 In	8.1	1+77.3								
2+00	145.0	136.94	8.1									
					2+09		C35457		8923 Birch		10-18-72	
						2+36.2		C8342		8918 Bekemeyer		5-17-68
					2+88.2							
3+00	144.8	137.19	7.6									
				Top	3+46.4	3+10	C32710	C8341	8915 Birch	8910 Bekemeyer	6-7-72	5-17-68
	145.0	137.37	7.6	3+69.3								
					3+77							
						3+89.8		C8340		8902 Bekemeyer		5-17-68
4+00	145.1	137.46	7.6		top 4+42.3		C36760		8907 Birch		1-17-73	
					4+66.4		C37512		8901 Birch		2-28-73	
						4+87.9		C8343		8826 Bekemeyer		5-17-68
5+00	145.3	137.76	7.5		top 5+05.2							
					5+46		#C32870		8815 Birch		6/12/72	
						5+58.5		C8344		8810 Bekemeyer		5-17-68
	145.7	137.97	7.7	5+69.7	End Line #2							
LINE #3												
	147.7	136.04	11.7	0+00	Begin.							
1+00	146.5	136.24	10.3									
2+00	146.6	136.44	10.2									
	146.7	136.50	10.2	2+30.5								
					2+43.5		#C19548		8802 Bekemeyer		6-2-70	
3+00	147.0	136.64	10.4									
					3+17.0		C37515		8808 Birch		2-28-73	
					3+98		C39379		8812 Birch		6-6-73	
4+00	147.6	136.84	10.8									
	147.9	136.96	10.9	4+60	8" Stub N	End Line #3						

Rec. #156048 - Spec. Lat fee 250.00 - 2-28-73 - Joe Matthews - 802 Waddington