L-182A

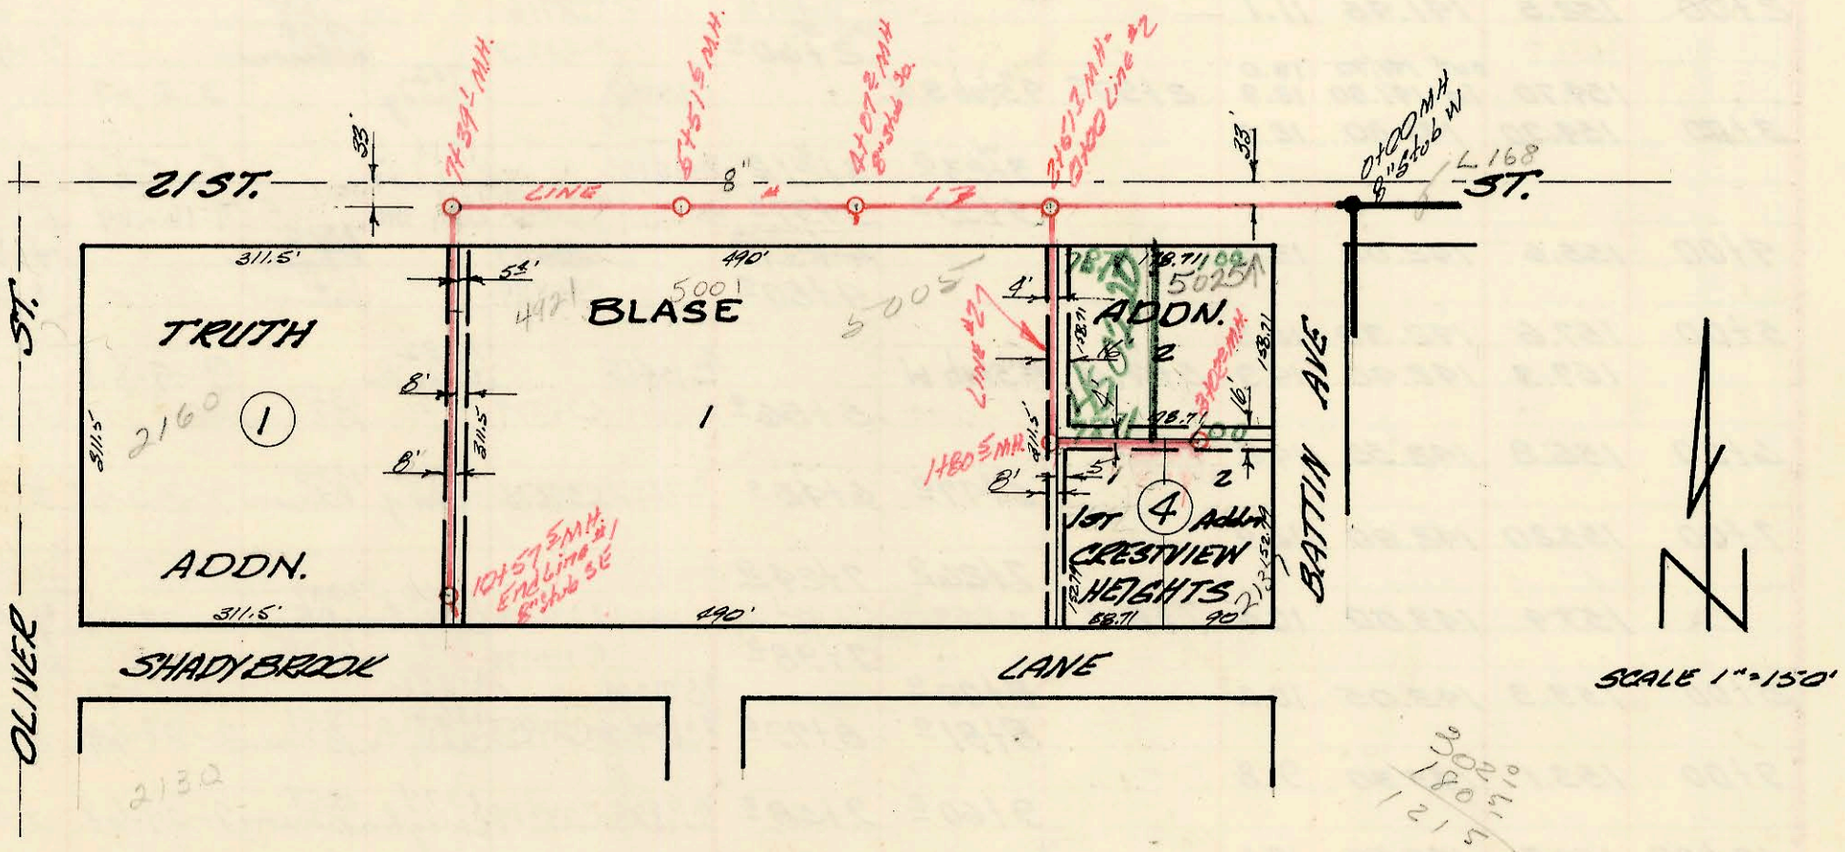

LAT. 25 SUB 5 SS #23
UTILITY CONTR'S INC.
LET 4-16-68 BOOKED 6-6-68
PROJ. C 28-24 K-79481

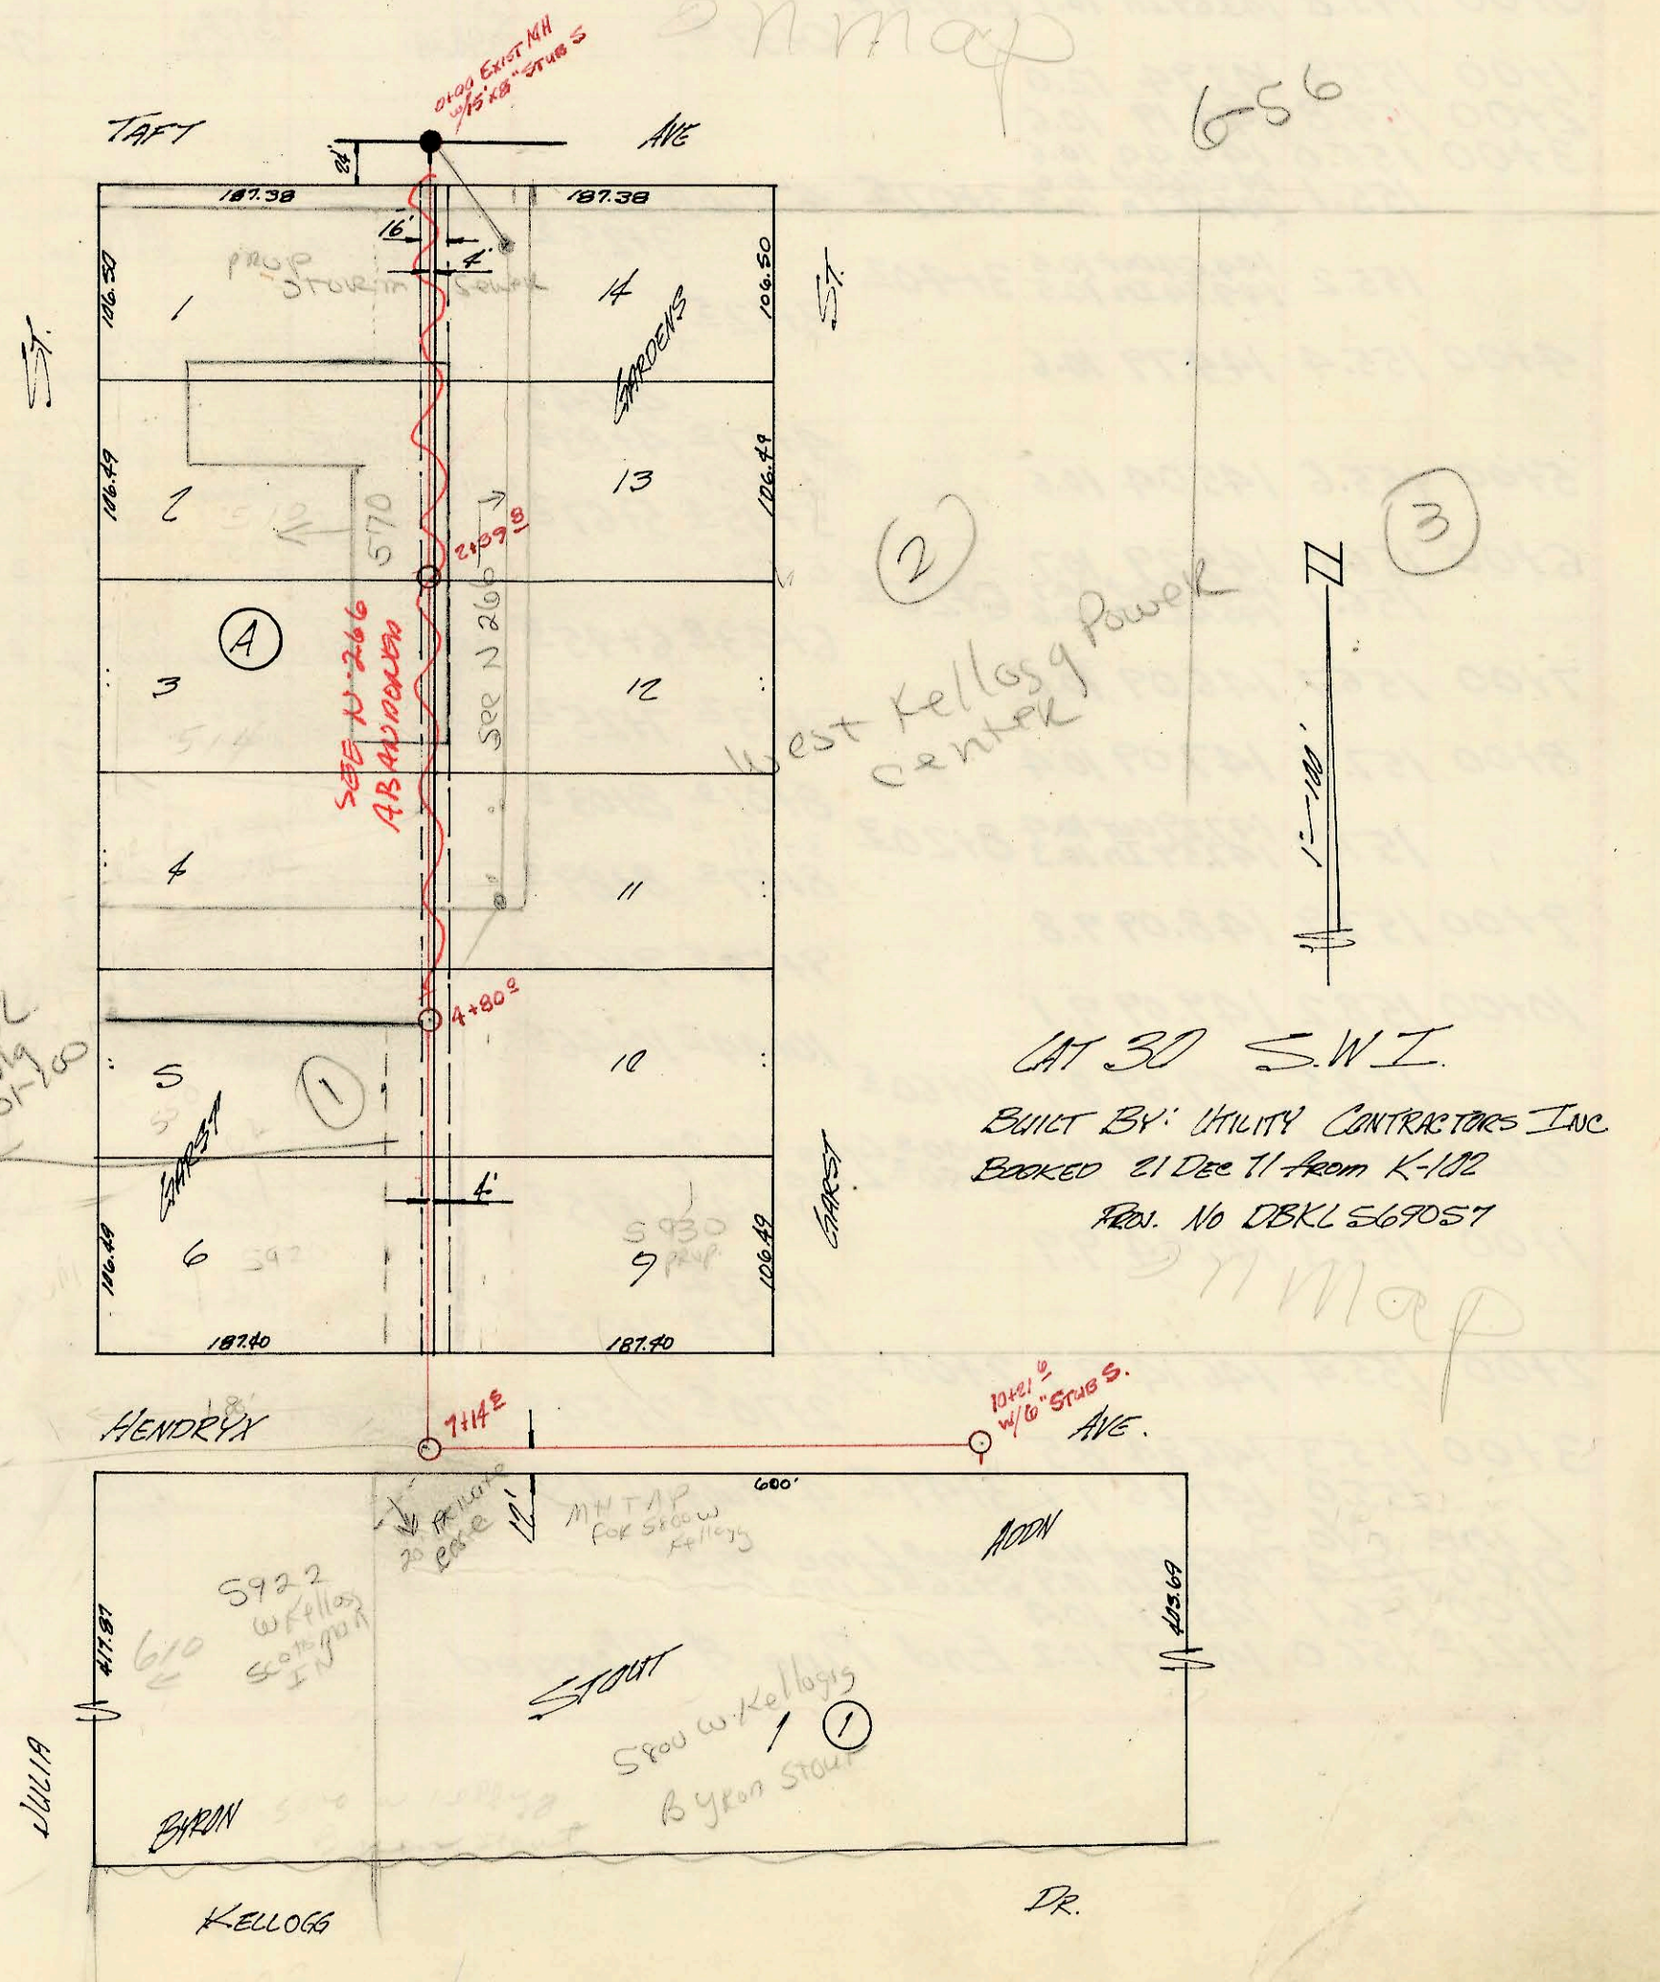

L-182

Form 42-020

CONSTRUCTION RECORD							SERVICE RECORD					
STATION	ELEVATION		Depth	MANHOLE	4-INCH "Y" BRANCHES		No. of Permit		House Number		DATE OF PERMITS	
	Ground	Grade			North West	South East	North West	South East	North West	South East	North West	South East
	215.9	207.64	8.3	0+00	Exist. MH & 8" Stub W.							
1+00	215.3	207.93	7.4									
2+00	214.5	208.25	6.2									
	214.4	208.40	6.0	2+51.7	= 0+00 Line #2							
3+00	215.2	208.53	6.7									
4+00	216.3	208.83	7.5									
	216.4	208.85 out 208.95 In	7.5	4+07.2	8" Stub So.							
5+00								2.399 R 15451	5001 E 21st	R	10-7-89 1-17-86	
	218.9	209.86	7.0	5+51.6		5+57.6		12575	5005 E. 21st		11-13-84	
6+00	220.2	210.21	10.0									
7+00	222.7	210.91	11.8									
	223.2	211.17	12.0	7+39.1	Top 7+86 ~~7+75.4~~		1330 C66402		2160 N. Oliver	R	9-23-80 5-25-78	
8+00	224.6	211.46	13.1			Top 8+24 ~~8+17.1~~		C41836	4921 E. 21st		10-24-73	
9+00	224.5	211.76	12.7									
					9+19.4							
10+00	224.4	212.06	12.3									
	224.3	212.22	12.1	10+57.5	8" Stub SE							
LINE #2												
	214.4	208.40 out 210.20 In	6.0	0+00	= 2+51.7 LINE #1							
						0+40.0						
1+00	221.1	210.60	10.5									
					4" PVC 40 1+87.5 top	1+02.5	21389		5005 E 21st		8-29-88	
	220.0	210.92	9.1	1+80.5								
2+00	218.2	211.10	7.1									
					2+05	2+02.5 2+03		2000-01364 821	2137 R Bettin		4" SCH 40 ABS CO only	6-5-00 7-22-80
					2+89.5	2+87.5	C50654		5017 E 21st		8-4-75	
	219.3	211.52	7.8	3+02	M.H. Tap		C38848		5025 E R 21st		5-8-73	apparently changed to 5009 E. 21st (2nd Top)
LAT 30, S. W. I.												
0+00	119.3	108.20	11.1	0+00	Exist MH w/ 15'-8" STUBS.							
1+00	117.6	108.40	9.2									
2+00	117.0	108.60	8.4		1+85		97-36727 C55047		511 SO Julia		3-13-97 4-30-76	
	117.2	108.68	8.5	2+39	2+94.3		97-36727 C55103		514 SO Julia		3-13-97 5-6-76	
3+00	117.0	108.80	8.2									
4+00	116.9	109.00	7.9									
	116.5	109.16	7.4	4+60								
5+00	116.5	109.20	7.3									
6+00	116.8	109.40	7.4									
					5+73.5 SO ~~6+02.9~~		120967 01299		532 Julia SO		7-25-96 9-18-80	
	117.5	109.63	7.9	7+14		MH Tap made below 1st TAP		C30357 20575		5800 W Kellogg - Main Bldg 5900 W Kellogg		2-8-72 4-29-88
8+00	116.3	109.9	6.4									
9+00	116.9	110.10	6.8									
10+00	115.9	110.30	5.6									
	115.7	110.34	5.4	10+21	4"/6" STUB S.			C30356 C30355		5800 W Kellogg - Main Bldg 5800 W Kellogg - Bldg Shop		2-8-72 2-8-72