


See 2/1/84

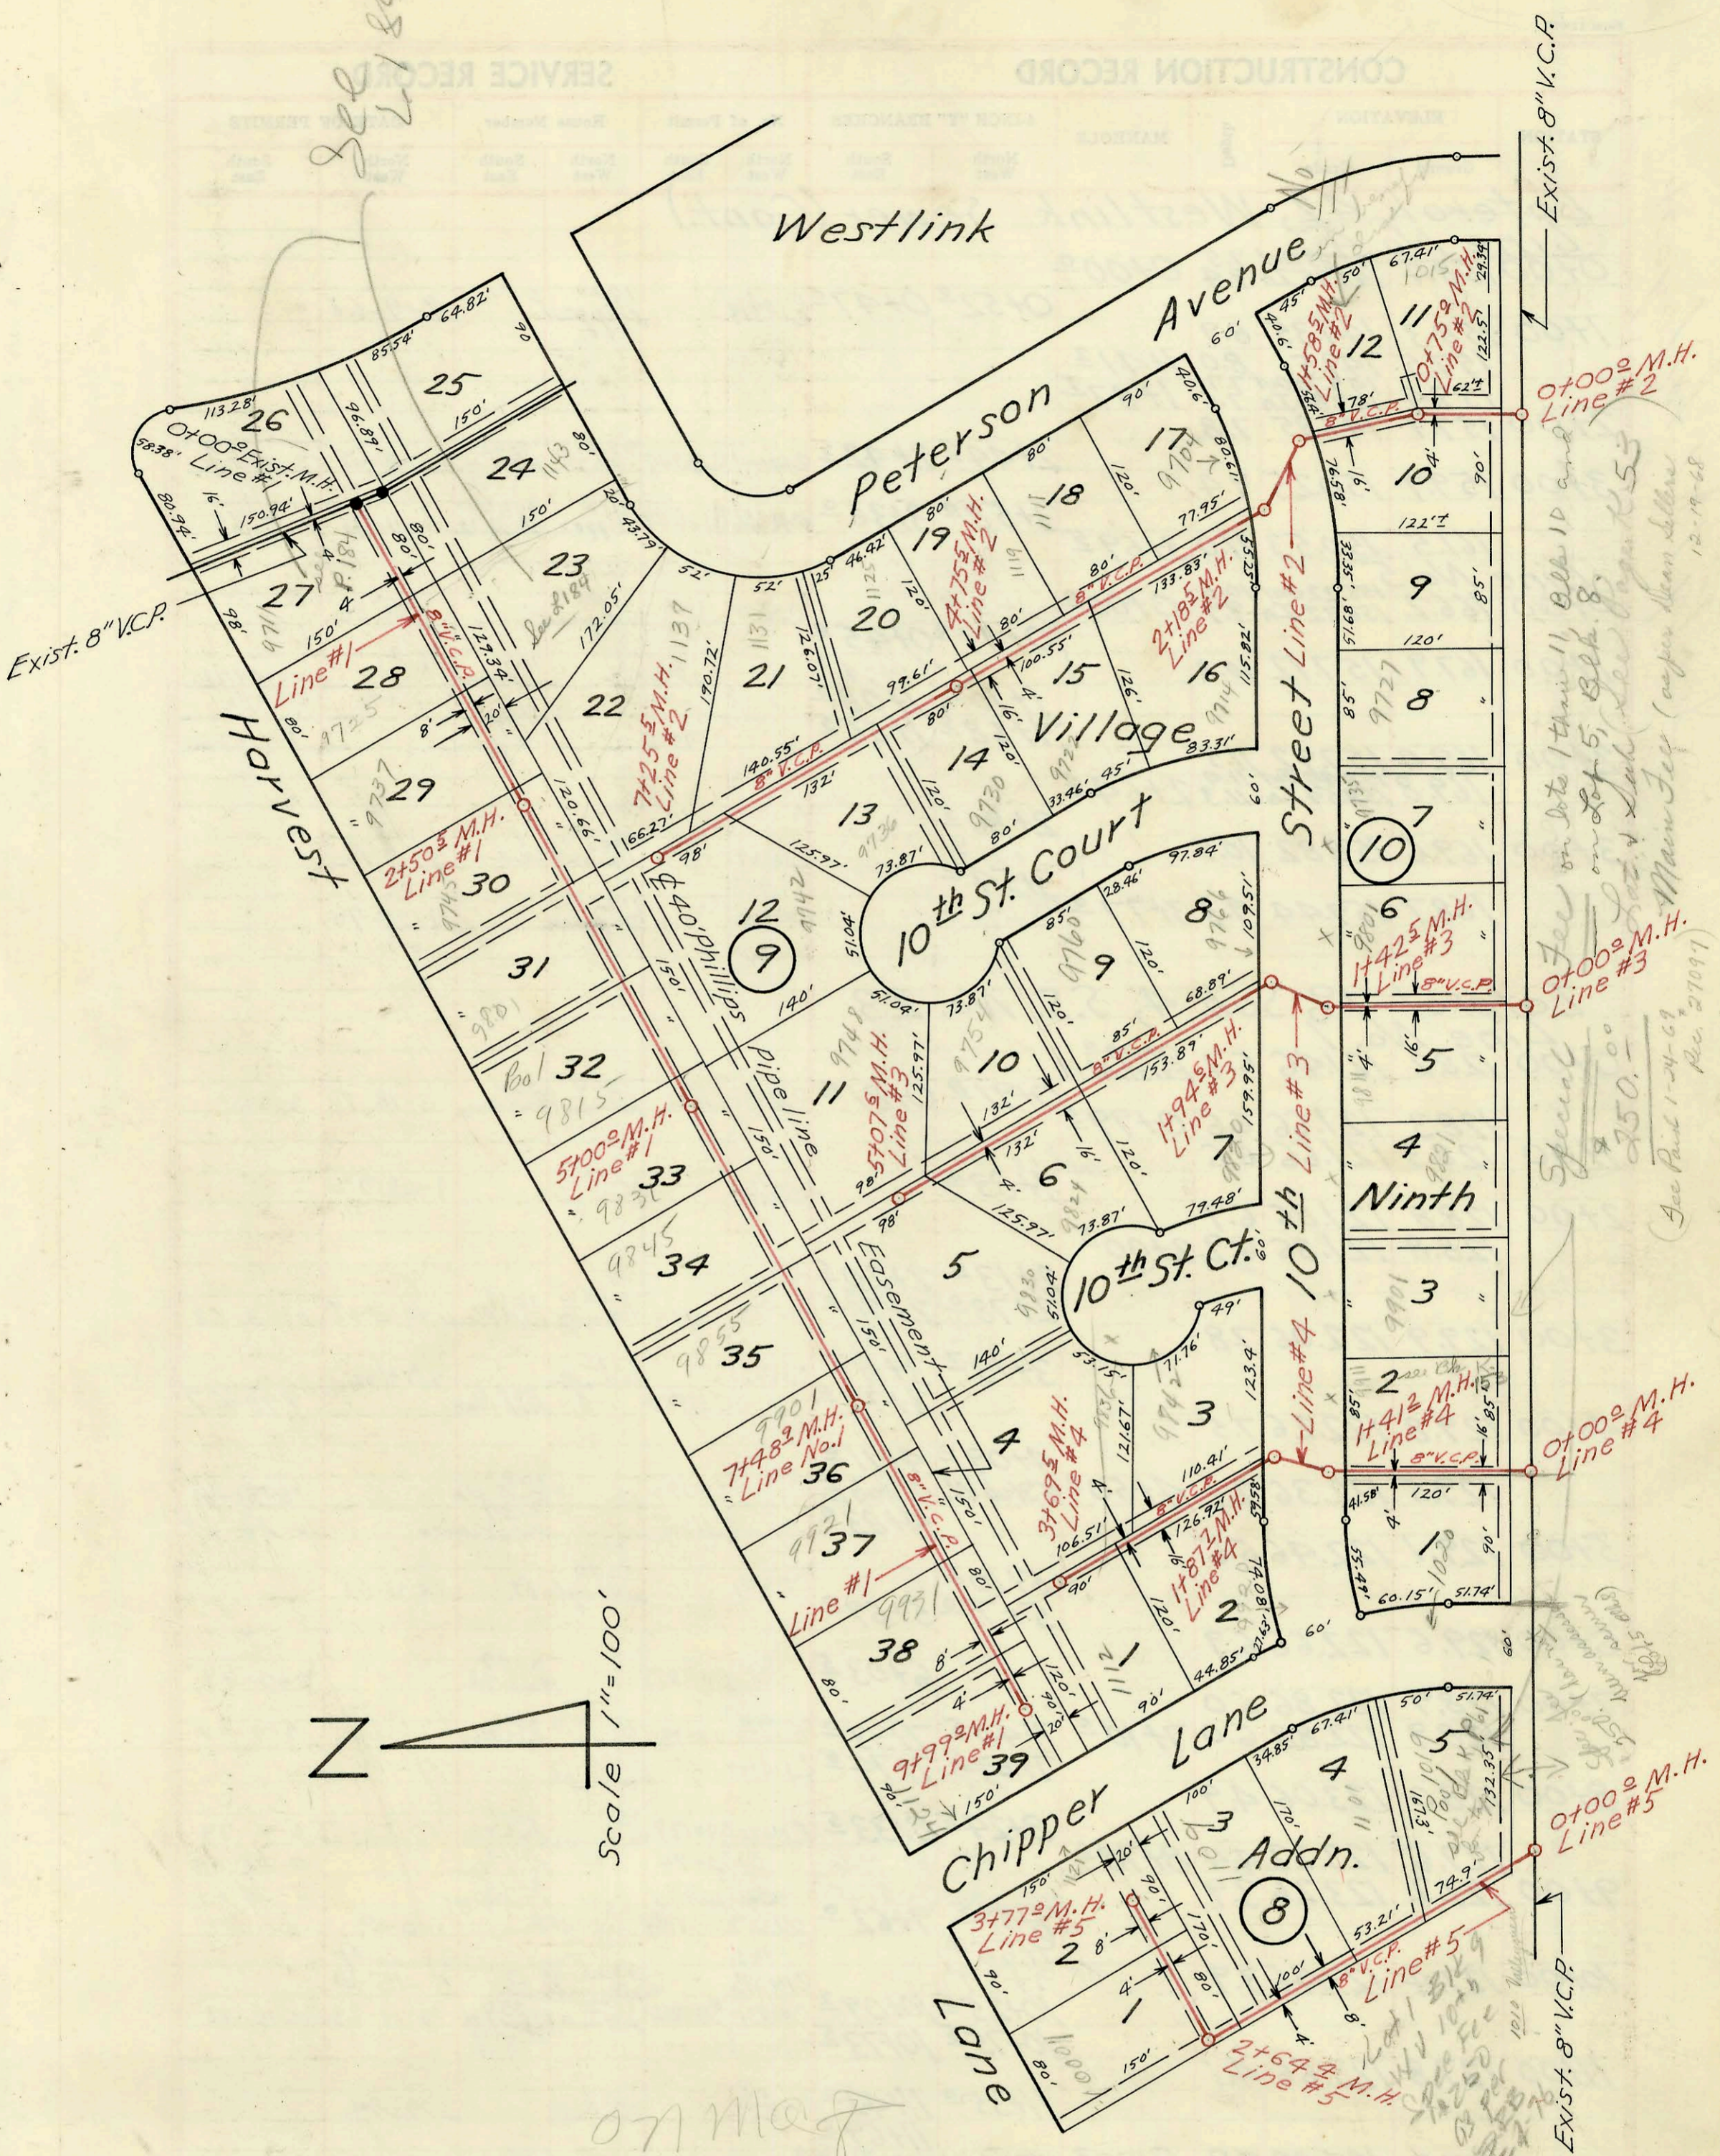

07 May  
 Lateral 42, Westlink Sewer  
 Mid-States Const. Co., Inc. August 1968  
 Proj. No. C28-29 Bk. JK#3 8-26-68

See Bk. K p. 53 for spec. payment on lots 2, 3, 5, 6, 7 & 8 Blk 10, with Village 9th.  
 Rec. 99422 - 1015 Peterson - 250<sup>00</sup> - Lot & Sub. Fee - Lot 11 - Blk 10 - 7-19-71  
 Rec. 295672 - 6-24-76 spec. fee paid 250<sup>00</sup> 1010 Valleyview

EXIST. 8" V.C.P.  
 Special Fee on Lots 1 thru 11, Blk 10 and on Lot 5, Blk 8.  
 250.00  
 (See Plan 1-24-69 Rec. 21019)

EXIST. 8" V.C.P.  
 01002 M.H. Line #2  
 01002 M.H. Line #3  
 01002 M.H. Line #4  
 01002 M.H. Line #5

CONSTRUCTION RECORD						SERVICE RECORD						
STATION	ELEVATION		Depth	MANHOLE	4-INCH "Y" BRANCHES		No. of Permit		House Number		DATE OF PERMITS	
	Ground	Grade			North West	South East	North West	South East	North West	South East	North West	South East
Lateral 42, Westlink Sewer												
Line No. 1												
0+00	151.0	139.07out 139.17In	11.9 11.8	Exist. M.H. 0+00								
1+00	150.7	140.07	10.6		0+233							
					1+00.5 1+01		2452 C26913		9725 R Harvest		1-21-71 8-31-71	
					1+773		C26373		9734 Harvest		8-11-71	
2+00	150.4	140.97	9.4		2+50							
	150.3	141.42	8.9	2+50								
3+00	150.2	141.87	8.3		2+59		C26229		9745 Harvest		8-6-71	
4+00	150.8	142.77	8.0		3+36 3+45		C25871		9831 Harvest		7-26-71	
5+00	151.5	143.67	7.8	5700	4+18 4+22		L33359 C31210		9815 Harvest 9831 Harvest		7-5-72 3-28-72	
					5+10 5+82		C38491		9845 Harvest		4/25/73	
6+00	152.8	145.17	7.6		6+59		C32417		9855 Harvest		5-24-72	
7+00	154.7	146.67	8.0		7+35		C33853		9901 Harvest		7-25-72	
	156.3	147.41	8.9	7+48								
8+00	157.9	149.20	8.7		8+18 8+99		C35431 C35438		9921 Harvest 9931 Harvest		10-17-72 10-17-72	
9+00	161.7	152.70	9.0		9+87		C14914		1124 Chippewagon		7-15-69	
	165.5	156.16	9.3	9+99								
Line No. 2												
0+00	148.6	139.10out 139.20In	9.5 9.4	0+00	0+45	0+43	C25675		1015 Chippewagon		7-14-71	
	147.4	139.50	7.9	0+75	0+85 0+98		C22970		9703 W 10th		2-17-71	See Fee tbl - see below
1+00	147.5	139.60	7.9									
	147.8	139.84	8.0	1+58								
2+00	147.5	140.00	7.5		2+79	2+57	C14100		9704 W. 10th		5-15-69	
	148.2	140.07	8.1	2+18								
3+00	148.5	140.40	8.1		3+93	3+37	C12761	C1241	9722 W. 10th St. Ct.	1111 Peterson	2-12-69	12-9-69
4+00	149.0	140.80	8.2		4+12		C21440		1119 Peterson		10-21-70	
	149.0	141.10	7.9	4+75								
5+00	149.0	141.20	7.8		4+98	5+00	C12762	C21441	9730 W. 10th St. Ct.	1125 Peterson	2-12-69	10-21-70
					5+73		C13364		9736 W. 10th St. Ct.		4-1-69	
6+00	149.5	141.60	7.9		6+93	6+01	C14708	C21442	9742 W. 10th St. Ct.	1131 Peterson	6-30-69	10-21-70
7+00	149.7	142.00	7.7		7+20							
	150.0	142.10	7.9	7+25								
Line No. 3												
0+00	151.2	142.62out 142.72In	8.6 8.5	0+00	0+46	0+44	C13032	C12644	9811 W. 10th St.	9801 W. 10th St.	3-5-69	2-5-69
1+00	151.2	143.12	8.1									
	150.8	143.29out 143.39In	7.5 7.4	1+42								
	150.6	143.60out 143.70In	7.0 6.9	1+94								
2+00	150.6	143.72	6.9		2+37	2+21	C13031	C12635	9820 W. 10th St.	9760 10th St.	3-5-69	2-5-69
3+00	150.7	144.12	6.6		3+75	3+73	C12763		9824 W. 10th St.		2-12-69	
4+00	151.3	144.52	6.8		4+95	4+93	C12764	C13979	9830 W. 10th St.	9748 W. 10th St.	2-12-69	5-7-69
5+00	152.1	144.92	7.2									
	152.3	144.95	7.3	5+07								

See next page for Lines 4 & 5

See Pg 188 for Line 4

Top C12637-9766 W 10th St - Donald Thompson - 2-5-69 (2+56.6)