

33<sup>rd</sup> St. North

Sta 13+76.6 M.H. with 8" Stub North.

126.8'	1	27	126.8'
25'	2	28	25'
"	3	29	"
"	4	30	"
"	5	31	"
"	6	32	"
"	7	33	"
"	8	34	"
"	9	35	"
"	10	36	"
"	11	37	"
"	12	38	"
"	13	39	"
"	14	40	"
"	15	41	"
"	16	42	"
"	17	43	"
"	18	44	"
"	19	45	"
"	20	46	"
"	21	47	"
"	22	48	"
"	23	49	"
"	24	50	"
"	25	51	"
126.8'	26	52	126.8'

Sta 11+79.2 M.H. Line No. 1.

3351 10/20/64

Place

Place

Sta 8+78.0 M.H. Line No. 1.

Sta 0+90.6 Line No. 2 M.H. with 4" Stub N.W.

Sta 7+10.0 Line No. 1 equals Sta 0+00.0 Line No. 2. M.H.

32<sup>nd</sup> St. North

126.8'	1	25	126.8'
"	2	26	"
"	3	27	"
"	4	28	"
"	5	29	"
"	6	30	"
"	7	31	"
"	8	32	"
"	9	33	"
"	10	34	"
"	11	35	"
"	12	36	"
"	13	37	"
"	14	38	"
"	15	39	"
"	16	40	"
"	17	41	"
"	18	42	"
"	19	43	"
"	20	44	"
"	21	45	"
"	22	46	"
"	23	47	"
126.8'	24	48	126.8'

Westbrook Rental

Sta 4+50.0 M.H. Line No. 1.

Wellington


Park

Sta 2+00.0 M.H. Line No. 1.

Sta 0+99.5 M.H. Line No. 1.

31<sup>st</sup> St. North

Sta 0+00.0 Exist. M.H. Line No. 1.

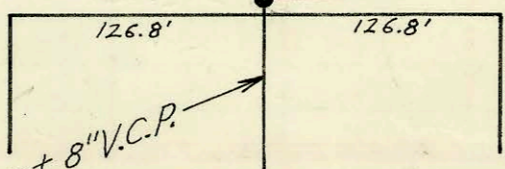

Lat. 19, Sub. 4, S.S. No. 23  
 Utility Contractors, Inc. Sept. 1968  
 Proj. No. C 23-71 Bk. K-78 8-23-68

CONSTRUCTION RECORD

SERVICE RECORD

STATION	ELEVATION		Depth	MANHOLE	4-INCH "Y" BRANCHES		No. of Permit		House Number		DATE OF PERMITS	
	Ground	Grade			North West	South East	North West	South East	North West	South East	North West	South East
Lateral 42, Westlink Sewer (Cont.)												
Line No. 4												
0+00	158.4	148.95 <sup>Out</sup> 148.95 <sup>In</sup>	9.5 9.4	0+00°								
1+00	158.3	149.35	8.9				0+52°	0+47°	#10414	1020 chipperm		9-9-68
	157.5	149.51	8.0	H412								
	157.4	148.70 <sup>Out</sup> 147.80 <sup>In</sup>	7.7 7.6	1+87°								
2+00	157.7	149.85	7.8									
3+00	159.7	150.25	9.4				2+44°	2+42°	C12004 C13249	9920 W 1012 9842 W 1012		12-18-68 3-24-69
	161.5	150.53	11.0	3+69°			3+58°	3+36°	#19666 C12648	1112 chipper 1012		6-11-70 2-5-69
Line No. 5												
0+00	166.2	156.22 <sup>Out</sup> 156.32 <sup>In</sup>	10.0 9.9	0+00°								
1+00	167.9	157.12	10.8				0+47°	0+45°	C56117	1010 Valliqued		6/24/76
							1+10°	1+08°	C28788	110 chipper		10-29-71
							1+68°	1+66°	C29935	1101 chipper		1-11-72
2+00	169.4	157.92 158.42 <sup>Out</sup> 158.54 <sup>In</sup>	11.5 11.4 11.3	2+64°								
3+00	169.6	158.82	10.8	top			2+86°	3+22°	C32369	10001 Harriet Lane		5-17-72
	168.7	159.44	9.3	3+77°			3+54°	3+72°	C21926	1121 chipper		11-25-70
Lateral 19, Sub. 4, S.S. No. 23												
Line No. 1												
0+00	128.2	121.46	6.7	0+00° Exist. M.H.								
							0+91°	0+81°	C18408 2854	3200 Wellington 3201 Park Place		3-18-70 3-13-81
1+00	128.3	121.66	6.6	0+99°								
							1+83°		C59660	3210 Wellington		1-28-77
2+00	128.8	121.86	6.9	2+00°								
							2+13°	2+20°	C10803 C10804	3222 Wellington 3219 Park Place		10-3-68 10-3-68
3+00	129.9	122.06	7.8				2+78°	2+76°	C31731	3226 Wellington		4/19/72
							3+13°	3+77°	C10567	3227 Park Place		9-18-67
4+00	129.8	122.26	7.5									
	129.5	122.36	7.1	4+50°			4+09°	4+11°	C11190	3233 Park Place		10-30-68
5+00	129.1	122.46	6.6	4 <sup>5</sup> Stub W.			4 <sup>5</sup> Stub E.	4+83°	C11018	3237 Park Place		10-22-68
							5+10°	5+71°	C11791	3240 Wellington Pl.		12-3-68
6+00	129.6	122.66	6.9				5+71°	5+69°				
							6+03°		C43885	3247 Park Pl.		3-7-74
7+00	128.9	122.86	6.0	7+10°			7+40°	7+33°	C11639 C39930	3301 Park Place		7-11-68 7-9-73
	128.9	122.88	6.0				7+67°	7+74°	C11415	3306 Wellington		11-13-68
8+00	128.0	123.06	4.9									
							8+24°	8+33°	C11622 C45179	3312 Wellington		10-22-68 6-5-74
	127.6	123.22	4.4	8+78°			8+99.6		C12974	3313 Park Place		2-28-69
9+00	127.2	123.26	3.9				9+07°	9+62°	C12975	3320 Park Place		2-28-69
							9+66°		C22377	3324 Wellington		1-12-69
10+00	127.4	123.46	3.9									
							10+25°	10+09°	C14096 C42831	3328 Wellington		7-20-87 5-15-69
							10+75°	10+73°	C60155	3332 Wellington		12-19-73 6-16-81
11+00	127.8	123.66	4.1									
							11+35°	11+42°	C12689	3338 Wellington		2-7-69
							11+69°					
12+00	127.7	123.82	3.9	11+79°			4 <sup>5</sup> Stub W.	4 <sup>5</sup> Stub E.	C00428 C245097	3340 Wellington		6-3-80 12-18-92
	127.7	123.86	3.8									
							12+20°	12+33°	C15096 C40684	3344 Wellington		7-24-69 8-16-73
							12+75°	12+70°				
13+00	128.4	124.06	4.3									
							13+30°	13+02°	C66326 C60908	119 W. 3359 Park Place		5-23-78 5-3-77
	129.3	124.21	5.1	13+76°			8 <sup>5</sup> Stub N.					
Line No. 2												
0+00	128.9	122.88 <sup>Out</sup> 122.89 <sup>In</sup>	6.0 6.9	0+00°								
	127.9	123.25	4.6	0+90°								

See Pg 187 for layout

25101028 - tap # C60910 - 111 West 33rd St North - 4-28-77 (13+01.9) C19032 4129/10 3343 N Park Pl  
 tap # C60909 - 101 West 33rd St North - 4-28-77 (13+12.0)  
 # 17546 3328 N. Wellington Pl - 12-30-66 NK Ann Davis (9+87) Move in House  
 # 21578-92188 3326 N. Wellington Pl (Move in) NK - Jerry Farlee (9+59.0 top 4<sup>5</sup> Stub)