


66' Cities Service Pipeline Easement

Sta 10+03<sup>00</sup> Line #1 equals 0+00<sup>00</sup> Line #2 M.H. End Syphon.

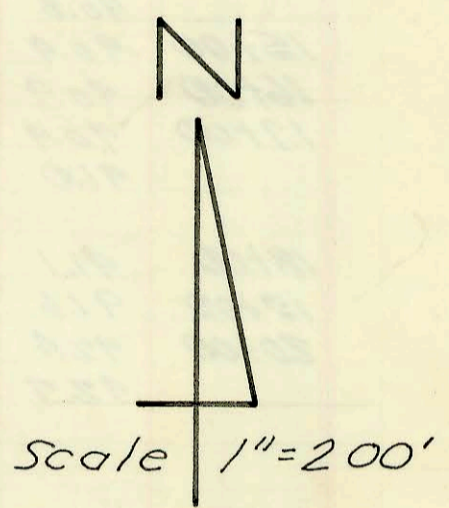

Lateral 6, Glenville Sewer  
 W.B. Carter Const. Co., Inc. Oct. 1968  
 Proj. No. C 28-2 Bk. J.K.#8 10-30-68

*original map*

CONSTRUCTION RECORD

SERVICE RECORD

STATION	ELEVATION		Depth	MANHOLE	4-INCH "Y" BRANCHES		No. of Permit		House Number		DATE OF PERMITS	
	Ground	Grade			North West	South East	North West	South East	North West	South East	North West	South East
Lateral 6, Glenville Sewer Line No. 1												
0+00	88.5	79.11 <sup>out</sup> 79.69 <sup>In</sup>	8.8	0+00°								
1+00	86.3	79.84	6.5									
2+00	86.7	79.99	6.7									
3+00	86.7	80.00	6.7	2+06°								
	85.6	80.14	5.5									
	86.5	80.29	6.2	3+98°								
4+00	86.5	80.29	6.2									
5+00	84.7	80.44	4.3									
	85.0	80.48	4.5	5+27°								
6+00	85.4	80.59	4.8									
7+00	85.2	80.74	4.5									
					4" SCH 40 8+37.1			990114	4525 Palisade		11-3-99	
8+00	85.4	80.89	4.5									
	85.6	80.95	4.6	8+43°								
9+00	85.3	81.04	4.3									
9+35	85.2	81.09	4.1									
9+40	85.2	80.22	5.0									
9+98	85.2	80.31	4.9									
10+00												
	85.2	81.51	4.7	10+03°								
11+00	86.2	81.66	4.5		10+11.7			269897	4545 Palisade		12-18-78	
12+00	88.4	81.81	6.6									
	88.4	81.81	6.6	12+03°								
13+00	86.8	81.96	4.8		12+64.9			269234	4501 Palisade		11-2-78	
14+00	86.7	82.11	4.6									
	87.1	82.19	4.9	14+52°								
15+00	87.6	82.26	5.3		16+03.4			269912	4631 Palisade		11-8-77	
16+00	87.2	82.41	4.8		17+14.1			269277 269311	4645 Palisade		11-8-77	
17+00	86.7	82.56	4.1									
	86.2	82.64	3.6	17+51°								
18+00	85.4	82.71	2.7									
19+00	85.6	82.86	2.7									
20+00	85.2	83.01	2.2									
	85.7	83.09	2.6	20+52°								
21+00	86.7	83.24	3.5		21+14.0			9908	4729 Palisade		12-19-83	
					21+72.5			210934	4729 Palisade		10-15-68	
22+00	86.5	83.54	3.0									
23+00	86.3	83.84	2.5		6" PVC 23+52			1099	4729 Palisade		9-24-99	
	86.2	84.00	2.2	23+57°				00771				
Line No. 2												
0+00	85.2	81.51 <sup>In</sup>	4.7	0+00° Line #2 =								
		81.41 <sup>Out</sup>	4.8	10+03° Line #1								
0+69	84.9	81.15	3.7	End Pipe & Plug.								
97-176267 10997 4729 s Palisade												

Siphon