L-203A

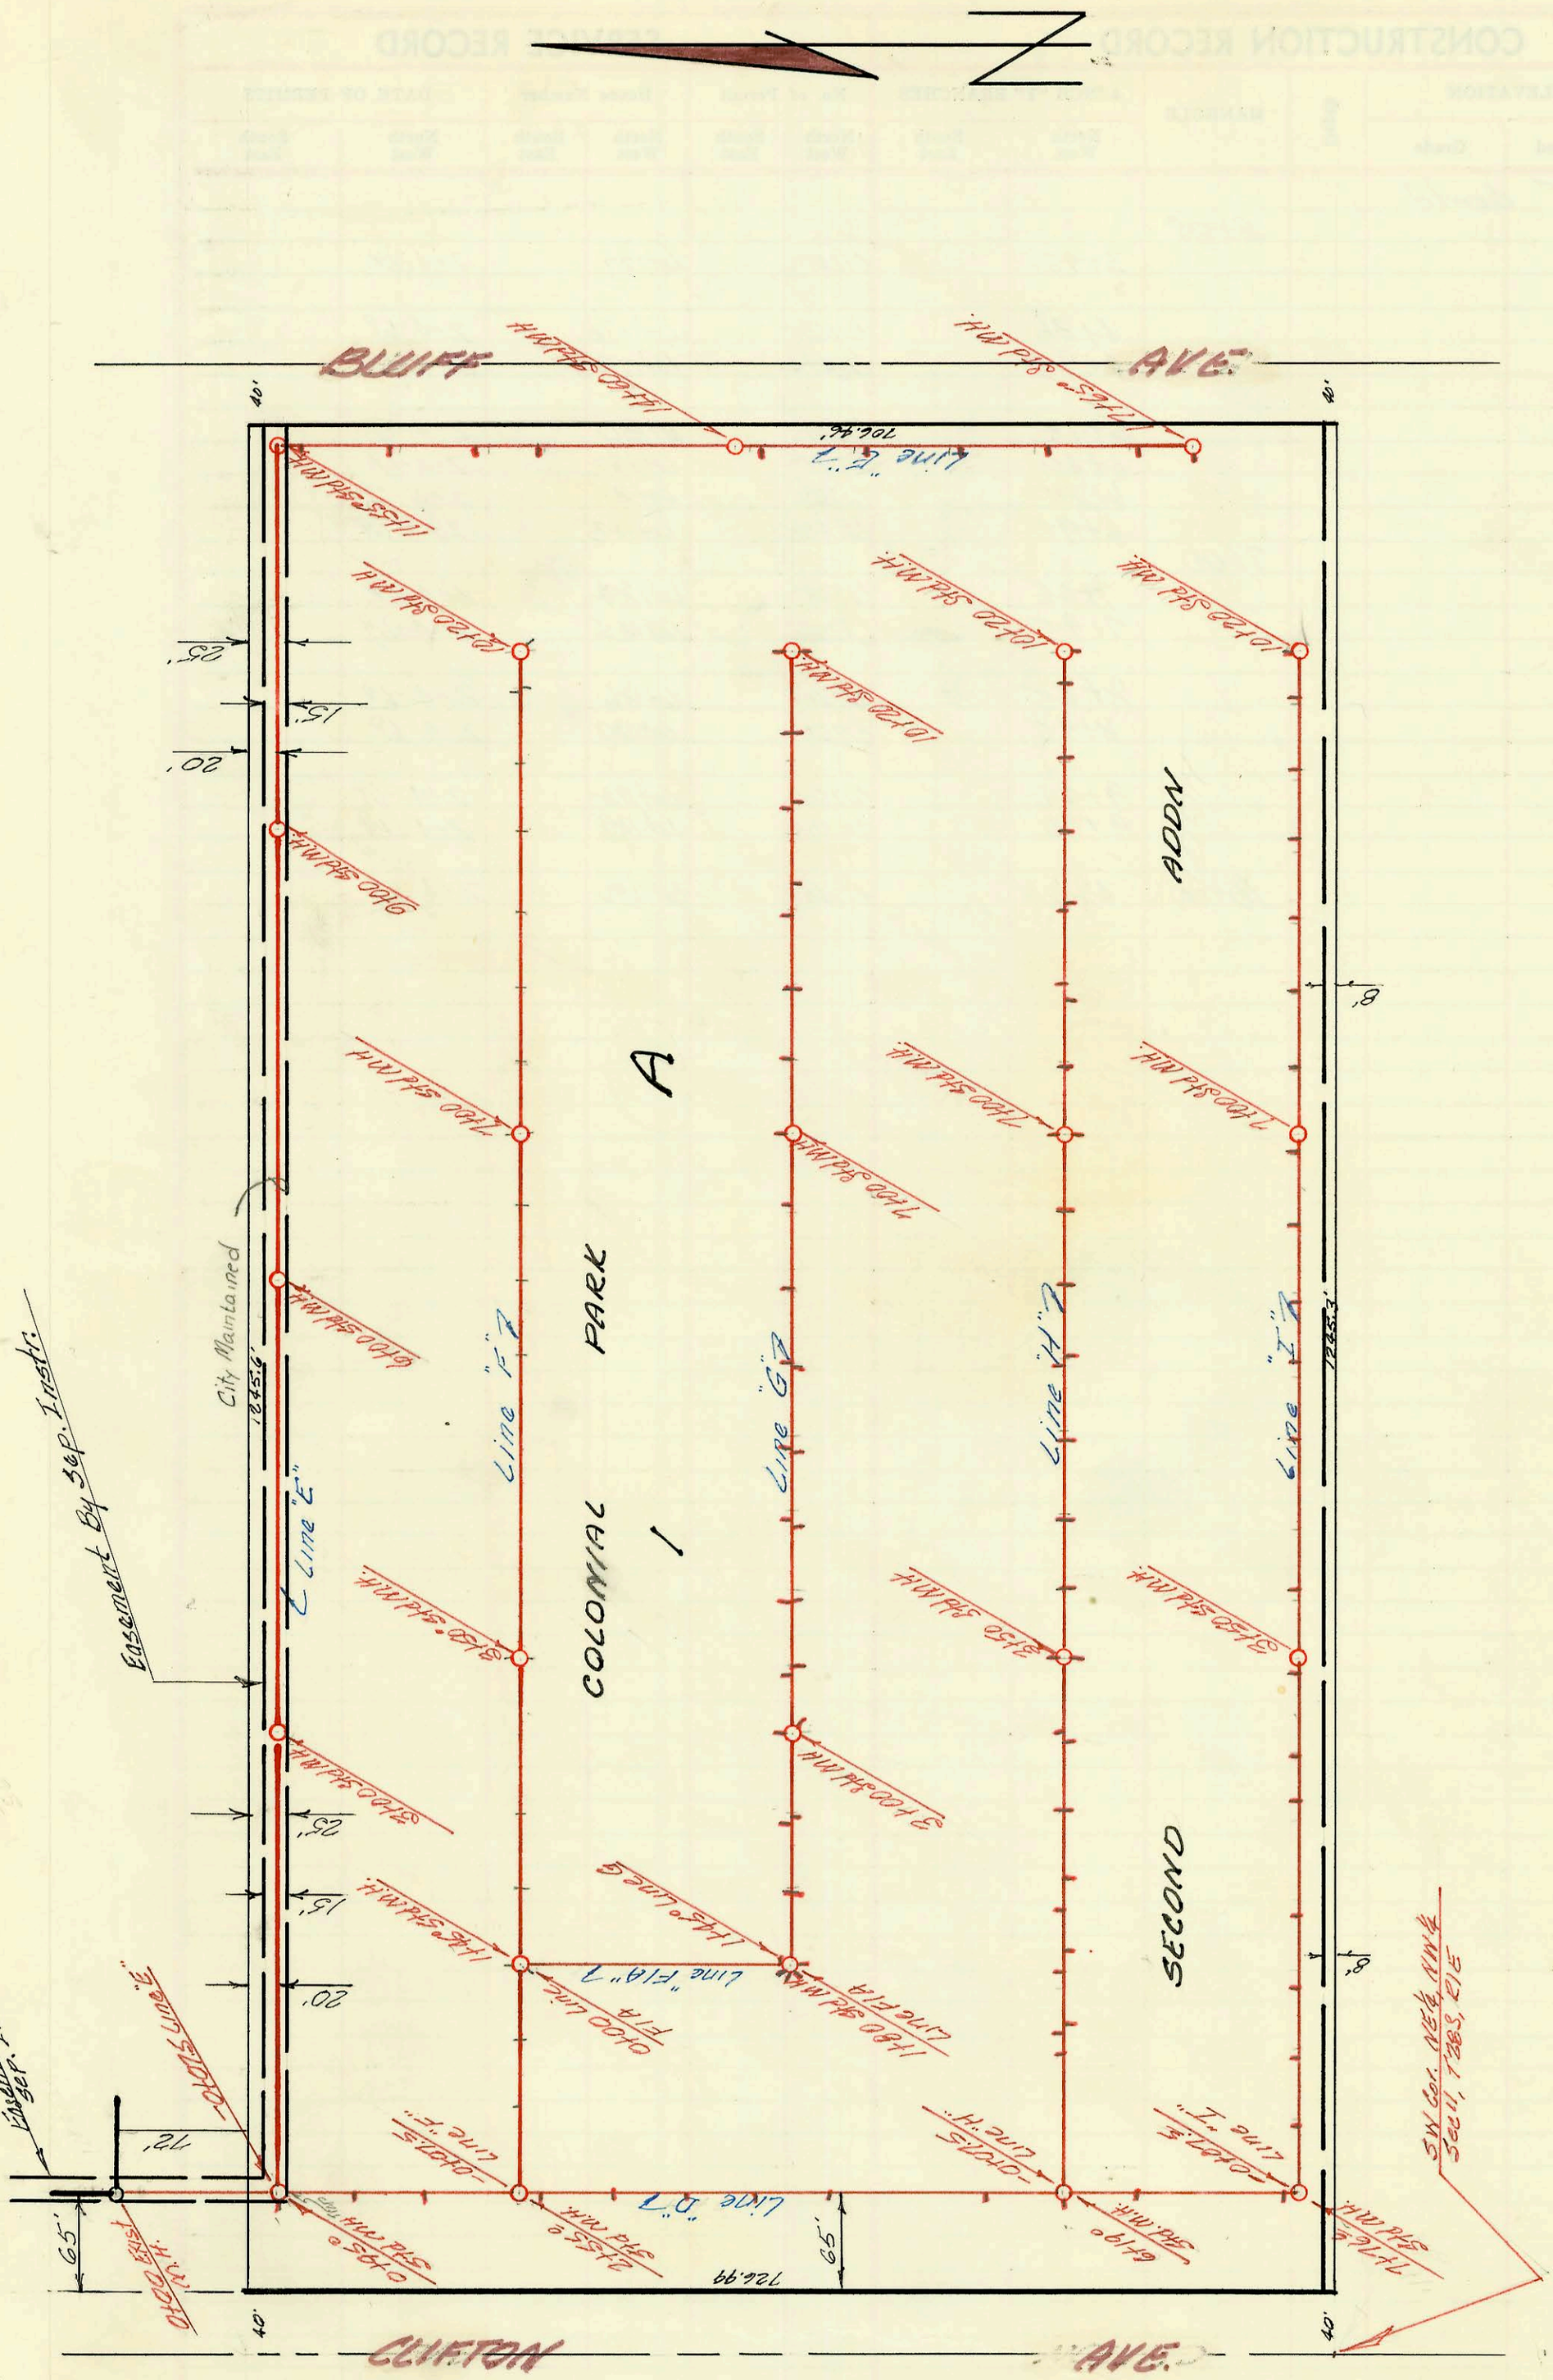

* NOTE: City maintains line E- Sta. 0+00 to 11+55
Remaining lines are private system

PRIVATE SAN. SEWER
COLONIAL PARK 2ND ADDN.
TRICO CONSTR. CO.
Constr. Jan 1969 Booked From
Plan April 1970 Scale 1" = 100'

on map

2-206

Form 42-020

CONSTRUCTION RECORD							SERVICE RECORD					
STATION	ELEVATION		Depth	MANHOLE	4-INCH "Y" BRANCHES		No. of Permit		House Number		DATE OF PERMITS	
	Ground	Grade			North West	South East	North West	South East	North West	South East	North West	South East
Line F												
				-0+07.5 = Sta 2+55 Line "B"								
					0+52.5		C12572		Lot 296		2-4-69	
					0+92.5		C12573		Lot 297		2-4-69	
						0+95		C12571		Lot 295		2-4-69
1+00												
				1+45°	4" Stub N		C12574		Lot 298		2-4-69	
						4" Stub S		C12570		Lot 294		2-4-69
				1+45								
					1+95		C12575		Lot 299		2-4-69	
						1+95		C12569		Lot 293		2-4-69
2+00												
					2+45		C12576		Lot 300		2-4-69	
						2+45		C12568		Lot 292		2-4-69
							C12577		Lot 301		2-4-69	
								C12567		Lot 291		2-4-69
3+00												
							C12578		Lot 302		2-4-69	
								C12566		Lot 290		2-4-69
				3+50								
							C12579		Lot 303		2-4-69	
								C12565		Lot 289		2-4-69
4+00												
5+00												
6+00					6+00		C12580		Lot 304		2-4-69	
						6+00		C12564		Lot 288		2-4-69
					6+50		C12581		Lot 305		2-4-69	
						6+50		C12563		Lot 287		2-4-69
				7+00	4" Stub N		C12582		Lot 306		2-4-69	
						4" Stub S		C12562		Lot 286		2-4-69
					7+45		C12583		Lot 307		2-4-69	
						7+45		C12561		Lot 285		2-4-69
					7+95		C12584		Lot 308		2-4-69	
						7+95		C12560		Lot 284		2-4-69
8+00												
					8+45		C12585		Lot 309		2-4-69	
						8+45		C12559		Lot 283		2-4-69
					9+00		C12586		Lot 310		2-4-69	
						9+00		C12558		Lot 282		2-4-69
9+00												
					9+45		C12587		Lot 311		2-4-69	
						9+45		C12557		Lot 281		2-4-69
					9+92.5		C12588		Lot 312		2-4-69	
						9+94.5		C12556		Lot 280		2-4-69
				10+20	4" Stub N.	4" Stub 2 E		C12555		Lot 279		2-4-69
Line F1A												
				0+00°	= 1+50 MH Line F							
1												
						1+74		C12532		Lot 258		2-4-69
				1+80°	4" Stb NW		C12515		Lot 257		2-4-69	
					4" Stb NW		C12516		Lot 256		2-4-69	
						4" Stub SW		C12517		Lot 255		2-4-69
						4" Stb S		C12518		Lot 254		2-4-69
Line G												
				1+45°	= MH Sta 1+80 Line F1A							
					1+92°		C12533		Lot 259		2-4-69	
						1+94°		C12519		Lot 253		2-4-69
2+00												
					2+39°		C12534		Lot 260		2-4-69	
						2+43		C12520		Lot 252		2-4-69
						2+49		C12521		Lot 251		2-4-69
				3+00	4" Stub N	4" Stub SE	C12535	C12522	Lot 261	Lot 250	2-4-69	2-4-69
					3+39		C12536		Lot 262		2-4-69	
						3+45		C12523		Lot 249		2-4-69
					3+88		C12537		Lot 263		2-4-69	
						3+90		C12524		Lot 248		2-4-69
4+00												

L-206A

L-203

SEE