C-217A

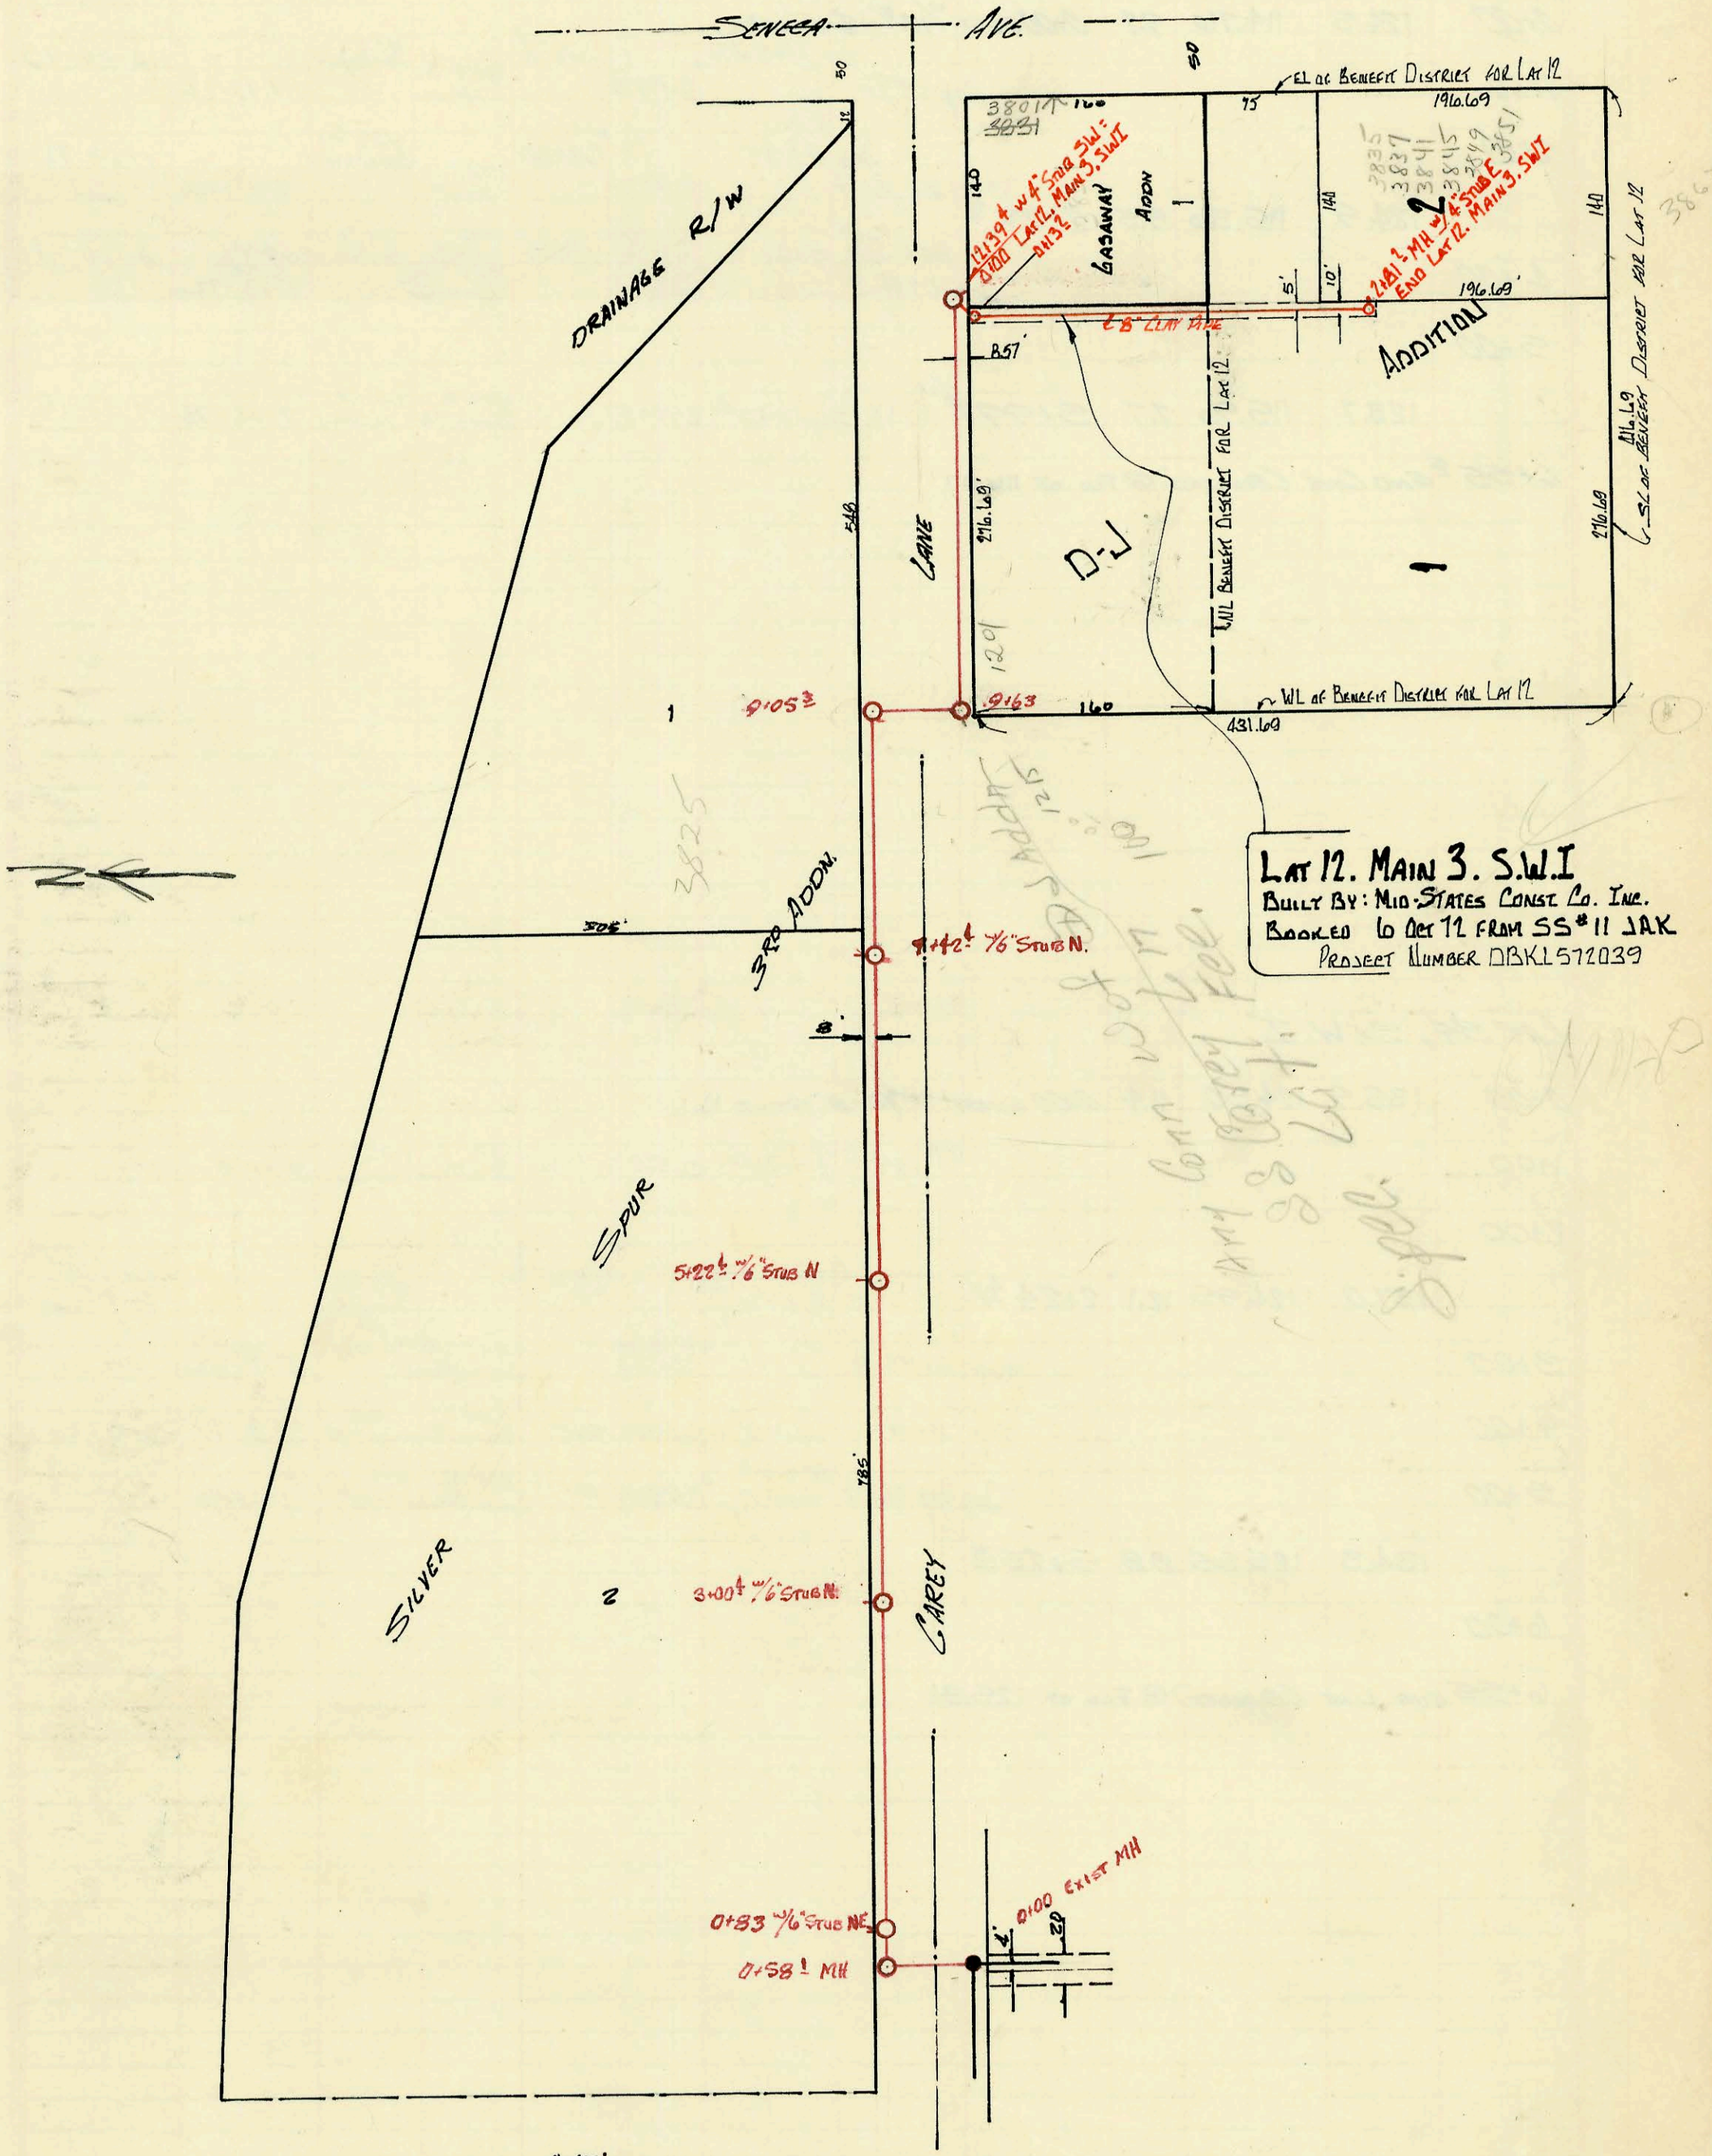

LAT 12. MAIN 3. S.W.I
BUILT BY: MID-STATES CONST CO. INC.
BOOKED 6 OCT 72 FROM SS#11 JAK
PROJECT NUMBER DBKLS72039

LAT 5, MAIN 3, S.W.I
BUILT BY: MID STATES CONST. CO.
BOOKED 1 FEB 72 FROM SS#11 JAK
PROJ. NO DBKLS69051

C-217

Form 42-020

CONSTRUCTION RECORD

SERVICE RECORD

STATION	ELEVATION		Depth	MANHOLE	4-INCH "Y" BRANCHES		No. of Permit		House Number		DATE OF PERMITS	
	Ground	Grade			North West	South East	North West	South East	North West	South East	North West	South East
LAT 5, MAIN 3, S.W.I.												
0+00	92.9	84.51	8.4	0+00 EXIST								
	92.4	84.60	7.8	0+58±								
	92.4	84.14	7.7	0+83		6" STUB NE						
1+00												
2+00												
	91.9	85.06	6.8	3+00±		6" STUB N.						
4+00												
5+00												
	91.9	85.4	6.5	5+22±		6" STUB N						
6+00												
7+00												
	91.8	85.73	6.1	7+42±		6" STUB N						
8+00												
9+00												
	90.1	85.97	4.7	9+05±		4" M# tap		C 33086		3825 S. Seneca	6-21-72	
	91.9	86.41	5.5	9+63±		M.H. tap		C38488		1215 Carey Lane (church)	4/25/73	#100.00 Spec. Ass. pd 4/25/73 Rec. 163855
10+00												
					tap	10+81±		C39066		120' Carey Lane	5-17-73	
11+00												
12+00												
	90.9	87.50	3.4	12+39±		4" STUB SE		#C30441		3801 ~~3831~~ S. Seneca		2-15-72
LAT 12. MAIN 3. S.W.I.												
0+00	90.8	87.61	3.2	EXIST MH 0+00 WAS 12+39± LAT 5								
	91.0	87.64	3.4	0+13±								
1+00												
2+00										3835 S. Seneca		9-14-73
	91.5	88.17	2.3	2+81±		W 4" STUB E		#C35277		3837 S. Seneca		10/10/72