


21st St. No.

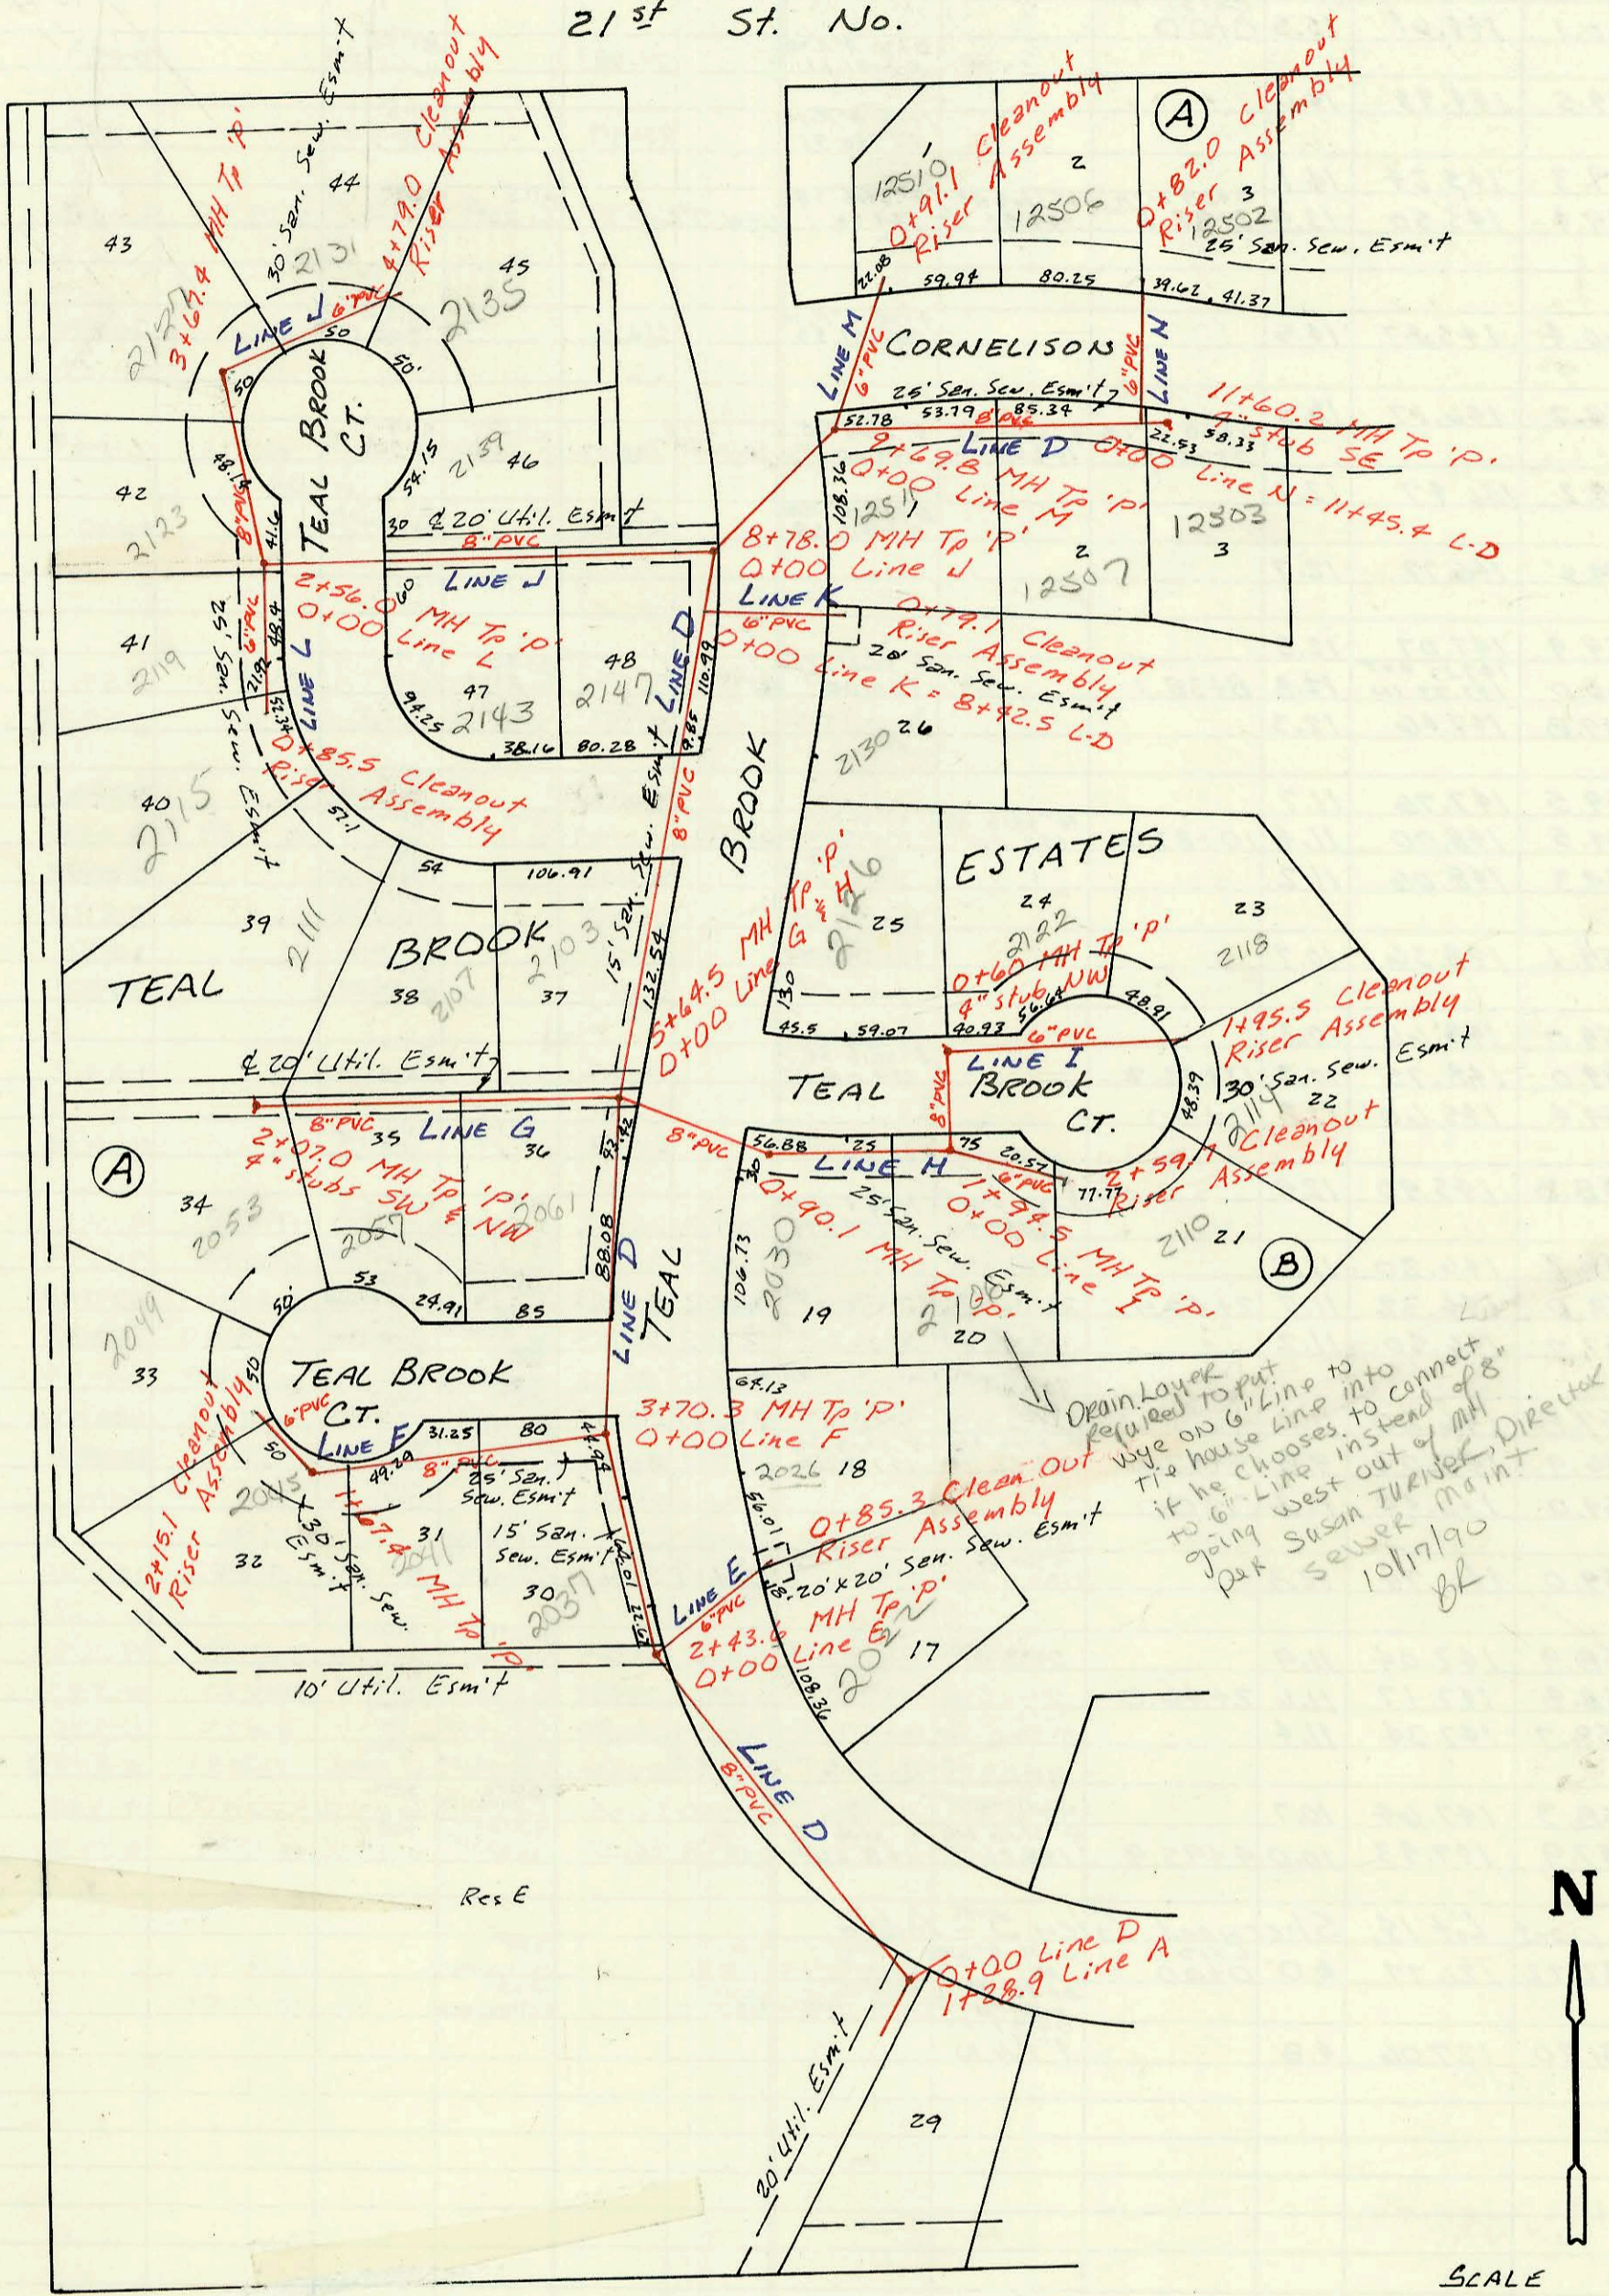

LAT 279, SWI  
 46B-81931 (608109)  
 Built By Mid-States Const.  
 Booked 1-31-90 from Plan  
 MP

CONSTRUCTION RECORD							SERVICE RECORD							
STATION	ELEVATION		Depth	MANHOLE	4-INCH "Y" BRANCHES		No. of Permit		House Number		DATE OF PERMITS			
	Ground	Grade			North West	South East	North West	South East	North West	South East	North West	South East		
LAT 279 SW I (CONT)														
	8+00	158.1	147.65	10.5										
	8+42.5	159.5	147.80											
	9+00	159.3	148.20	11.1										
		160.6	148.91	12.1	9+69.8									
	10+00	160.5	148.63	11.9		10+38.8		24290		12511 CORNELISON		11-15-89		
	11+00	159.9	149.03	10.9		11+22.0		24289		12507 CORNELISON		11-15-89		
	11+45.4	159.5	149.21							12503 CORNELISON		11-15-89		
		159.5	149.27	10.2	11+60.2	4" stub SE		24288						
LINE E	0+00	156.6	145.40	11.2	0+00	4" stub N 146.20	4" stub SE 146.20	24462	92-583	2026 Teal Brook	2022 Teal Brook	12-9-92	1-13-92	
LINE F	0+00	157.0	145.71	11.3	0+00									
	1+00	157.5	146.11	11.4			1+06.4		25979	2041 Teal Brook	2045 Teal Brook	7-23-90	11-15-89	
		158.0	146.55	11.6	1+67.4		1+66.8		24294					
	2+00													
	2+15.1	158.0				4" stub W 147.04		24939		2049 Teal Brook		3-14-90		
LINE G	0+00	156.9	146.29	10.6	0+00		4" SDR 35 0+29.0		91-2435		2061 Teal Brook		6-21-91	
	1+00	157.5	146.69	10.8		1+10.0	4" SDR 35 1+31.0		21519	91-2480	2107 Teal Brook	2051 Teal Brook	4-30-91	6-19-91
	2+00													
		157.5	147.12	10.4	2+07.0	4" stub NW	4" stub SW	92-1716	25898	2111 Teal Brook	2053 Teal Brook	1-29-92	8-1-90	
LINE H	0+00	156.9	146.29	10.6	0+00									
		156.4	146.65	9.8	0+90.1									
	1+00	156.5	146.69	9.8			1+53.1		24295		2030 Teal Brook		11- -89	
		157.3	147.07	10.2	1+94.5									
	2+00	157.5	147.12	10.4			6x4 wire 2+39.5		26324		2106 Teal Brook	2110 Teal Brook	10-16-90	
	2+59.7	157.3			1+94.5 L-H	4" stub SE 147.73		25761			2106 Teal Brook		7-18-90	
LINE I	0+00	157.4	147.17	10.2	0+00									
		157.1	147.51	9.7	0+60.0	4" stub NW		21286		2126 Teal Brook		11-15-89		
	1+00	157.0	147.98	9.0				21286		2126 Teal Brook		8-12-91		
	1+95.5	157.1			8+78.0 L-D	4" stub NE 148.94	4" stub SE 148.94	26522	26482	2114 N Teal Brook	2118 Teal Brook	7-9-91	11-7-90	
LINE J	0+00	159.5	148.10	11.4	0+00		4" SDR 35 0+51.0		92-1025		2147 N Teal Brook		6-24-92	
							4" SDR 35 0+70.0		91-1947		2134 N Teal Brook		3-7-91	
	1+00	159.0	148.50	10.5			4" SDR 35 1+38.0		92-2142		2143 N Teal Brook		8-14-92	
	2+00	158.0	148.90	9.1										
		159.0	149.22	9.9	2+56.0									
	3+00	159.3	149.40	9.9			4" SDR 35 3+01.0		26279		2123 Teal Brook		7-2-91	
		159.6	149.84	9.9	3+67.4		4" SDR 35 3+60.9		91-3816		2127 Teal Brook		11-25-91	
	4+00	159.7	150.16	9.5			4" SDR 35 4+36.4		91-3518		2121 Teal Brook		9-27-91	
LINE K	0+00	159.9				4" stub N 150.97	4" stub SE 150.97		92-587		2135 Teal Brook		1-13-92	
	0+79.1	158.5					4" stub SE 149.41		25960		2130 Teal Brook		8-15-90	
LINE L	0+00	159.0	149.39	9.6	0+00		5x6 wire 0+60.0		21299		2119 Teal Brook		10-23-90	
	0+85.5	158.7				4" stub W 150.25		25244		2115 Teal Brook		4-27-90		
LINE M	0+00	160.6	148.68	11.9	0+00									
	0+91.1	160.6			9+64.8 L-D	4" stub NE 149.60		24291		1280 CORNELISON		11-15-89		
LINE N	0+00	159.5	150.52	9.0										
	0+82.0	159.5				4" stub NW 150.85	4" stub NE 150.85	24292	24293	12506 CORNELISON	12502 CORNELISON	11-15-89	11-15-89	
LINE O	0+00	165.0	151.84	13.2	EXIST. 0+00									
	1+00	164.6	152.16	12.4										
							1+57.4		25228		2126 PINTAIL		4-25-90	
	2+00	164.6	152.48	12.1			4" SDR 35 2+50.9		91-3259		2130 PINTAIL		9-17-91	
		165.1	152.76	12.3	2+77.4		4" SDR 35 4" stub SW		91-3518		12402 CORNELISON		10-11-91	