M-26 A

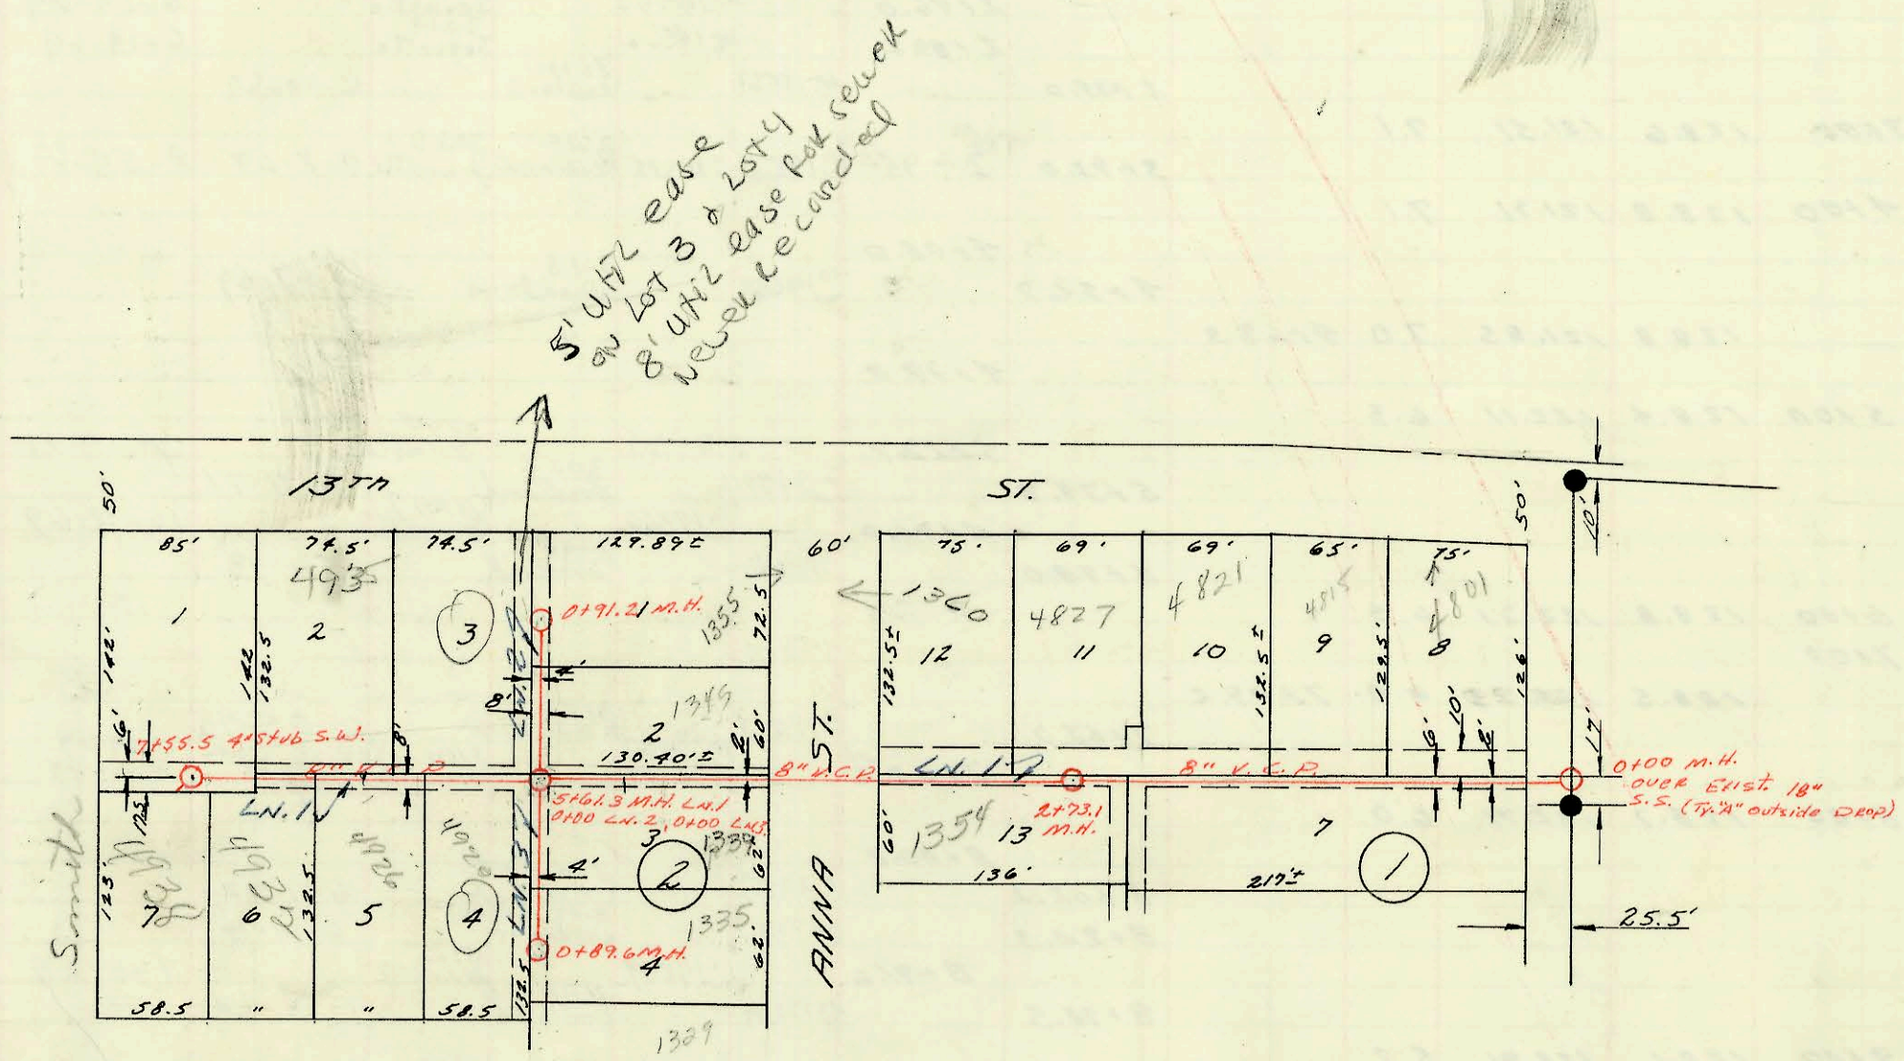


SCALE 1" = 100'

LAT. 193 SUB. 5 S.S. NO 22

W. B. CARTER Const. Co Inc.

Booked 5/15/69 Proj. C26-59

K-87

on map

M-26

Form 42-020

| | CONSTRUCTION RECORD | | | | | | | SERVICE RECORD | | | | | |
|---|---|---|---|---|---|---|---|---|---|---|---|---|---|
| | STATION | ELEVATION | | Depth | MANHOLE | 4-INCH "Y" BRANCHES | | No. of Permit | | House Number | | DATE OF PERMITS | |
| | | Ground | Grade | | | North West | South East | North West | South East | North West | South East | North West | South East |
| LN. #1 | 0+00 | 126.7 | 119.00 | 7.7 | 0+00 | TAP 0+45 | 0+54.6 | C20382 | | 4801 W. 13th | | 8-6-70 | |
| | | | | | | 0+56.6 | | | | | | | |
| | 1+00 | 128.1 | 119.50 | 8.6 | | | | | | | | | |
| | | | | | | 1+26.5 | | C20072 | | 4815 W. 13th | | 7-13-70 | |
| | | | | | | 1+91.7 | | C21456 | | 4821 W. 13th | | 10-22-70 | |
| | 2+00 | 132.8 | 120.00 | 12.8 | | | | | | | | | |
| | | | | | | 2+68.3 ~~2+71.0~~ | 2+69.0 | C50805 | | 4827 W. 13th | | 8-12-75 | |
| | | 133.2 | 120.40 | 12.8 | 2+73.1 | | | | | | | | |
| | | | | | | | TAP 2+93 ~~2+92.0~~ | | C51618 | | 1354 N. Anna | | 9-30-75 |
| | 3+00 | 132.7 | 120.50 | 12.2 | | | | | | | | | |
| | | | | | | TAP 3+29.0 | | C21925 | | 1360 N. Anna | | 11-25-70 | |
| | | | | | | | 3+31.0 | | | | | | |
| | 4+00 | 128.9 | 121.00 | 7.9 | | Tap 4+82.3 | | C49329 | | 1345 N. Anna | | 5-1-75 | |
| | 5+00 | 127.8 | 121.50 | 6.3 | | | TAP TIE 5+11.7 | | C49958 | | 1339 N. Anna | | 6-17-75 |
| | | 129.0 | 121.81 | 7.2 | 5+61.3 | | | | | | | | |
| | | | | | | | ~~5+84.34~~ 5+83.5 | | 10808 | | 4920 Briarwood | | 4-26-84 |
| | | | | | | 5+85.5 | | | | | | | |
| | 6+00 | 130.4 | 122.00 | 8.4 | | | | | | | | | |
| | | | | | | 4" PVC Tie Top 6+61.5 | 6+44.8 | | | | | | |
| | | | | | | 6+62.0 | 6+54.8 Stub | C14160 | 11400 | 4935 W. 13th | 4926 Briarwood | 5-20-69 | 7-10-84 |
| | | | | | | | 6+96.8 | | | | | | |
| | 7+00 | 131.6 | 122.50 | 9.1 | | | 6+91.5 Tap | | 13580 | | 4932 Briarwood | | 4-26-85 |
| | | | | | | 7+32.0 | | C15960 | | 4947 W. 13th St | | 9-18-69 | |
| | | 132.2 | 122.80 | 9.4 | 7+55.5 | 4" Stub | 7+50.5 S.W. | | 13308 | | 4938 Briarwood | | 3-22-85 |
| LN. #2 | 0+00 | 129.4 | 121.91 | 7.5 | Exist. 0+00 | | | | | | | | |
| | | | | | | | 0+36.7 | | C49958 | | | | |
| | | | | | | | 0+82.0 | | C20381 | | 1355 N. Anna | | 8-6-70 |
| | | 130.3 | 122.36 | 7.9 | 0+91.2 | | | | | | | | |
| LN #3 | 0+00 | 129.4 | 121.91 | 7.5 | Exist. 0+00 | | | | | | | | |
| | | | | | | | 0+25.0 | | | | | | |
| | | | | | | | ~~0+75.1~~ 0+80.6 | | C49336 | | 1335 N. Anna | | 5-1-75 |
| | | 129.9 | 122.36 | 7.5 | 0+89.6 | | | | | | | | |