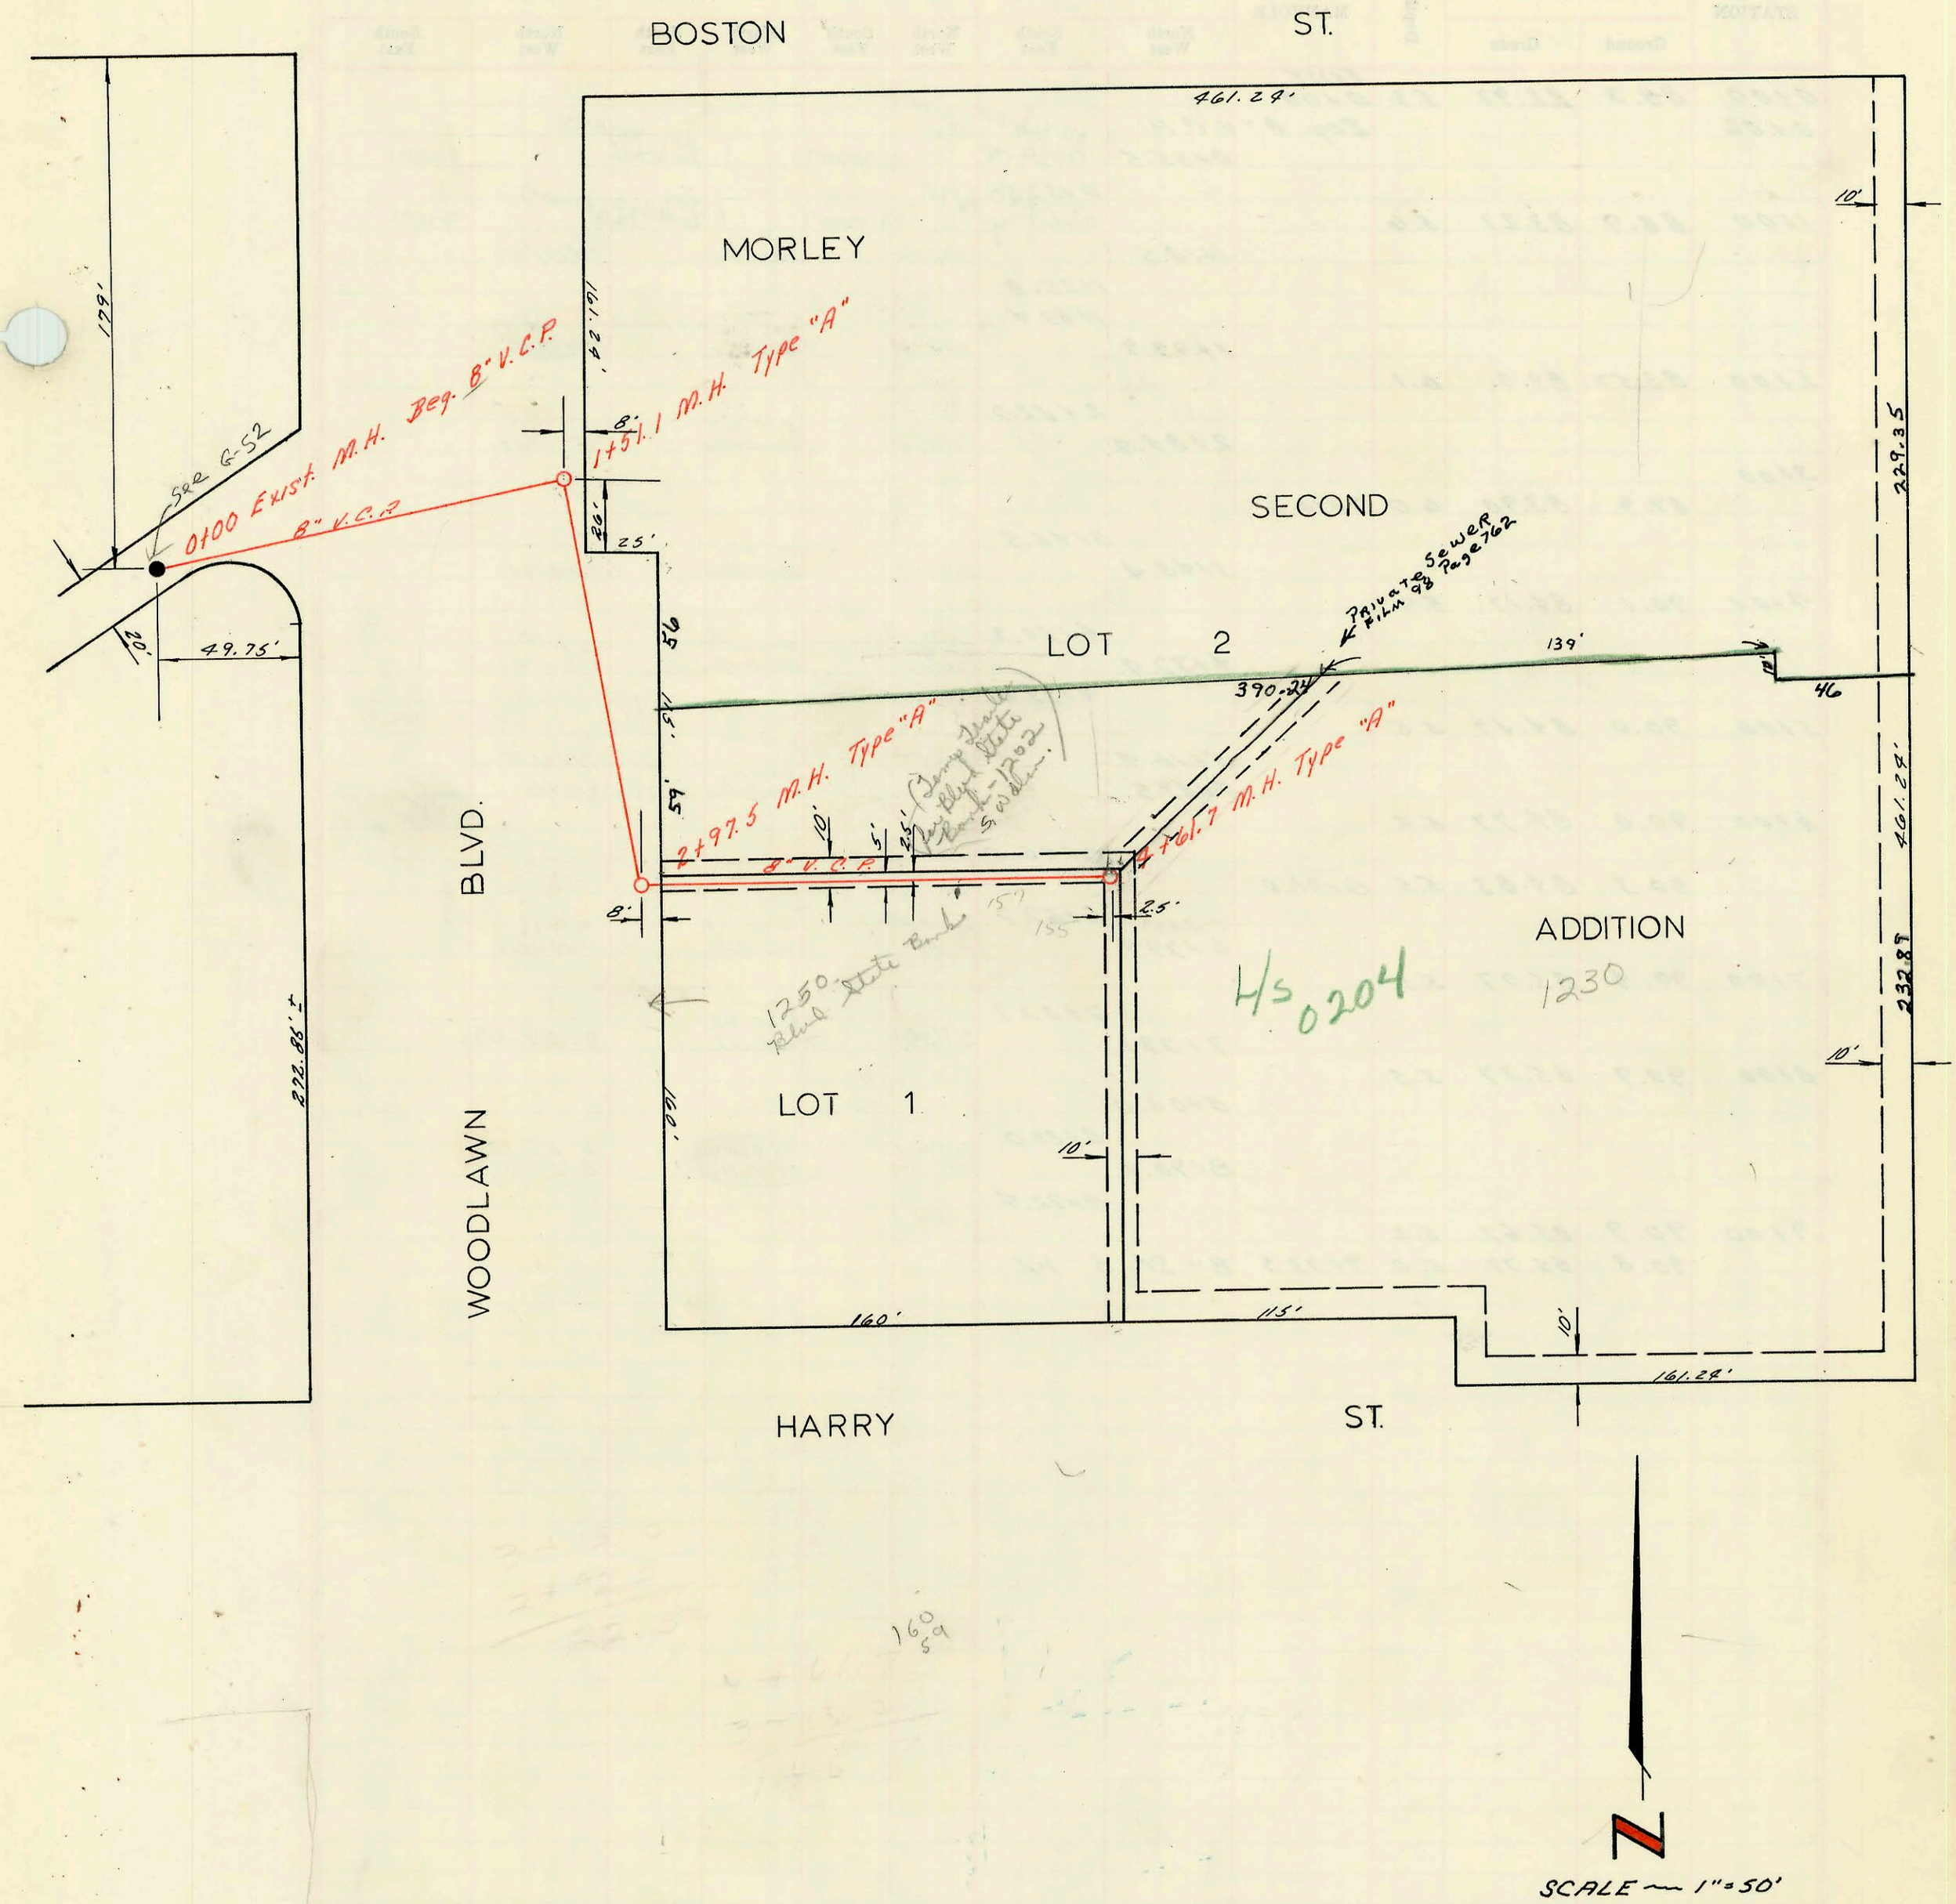

LAT. 19, SUB. 3, W.I.S.

W. B. CARTER CONST. CO. INC.

BOOKED 8/5/69 C29-16

256-4

117-38

Form 42-020

CONSTRUCTION RECORD							SERVICE RECORD					
STATION	ELEVATION		Depth	MANHOLE	4-INCH "Y" BRANCHES		No. of Permit		House Number		DATE OF PERMITS	
	Ground	Grade			North West	South East	North West	South East	North West	South East	North West	South East
0+00	137.4	127.00	10.4	Existing 0+00								
1+00	136.8	127.66	9.1									
	138.9	129.30 IN 127.99 OUT	9.6 10.9	1+51.1								
2+00	139.1	129.70	9.4									
	140.0	130.58 IN 130.48 OUT	9.4 9.5	2+97.5								
3+00	140.0	130.58	9.4									
					3+15.0							
						3+17.0	C52445	C51276		1250 S. Woodlawn		9-10-75
4+00	141.6	131.40	10.2		top 3+61.6		C45368		1202 S. Woodlawn		11-13-75 6-17-74	
	142.0	131.90	10.1	4+61.76	M.H. Top		C40219		1212 S. Woodlawn		7-24-73	
					M.H. Top		C48074		1230 S. Woodlawn		1-16-75	