M-50A

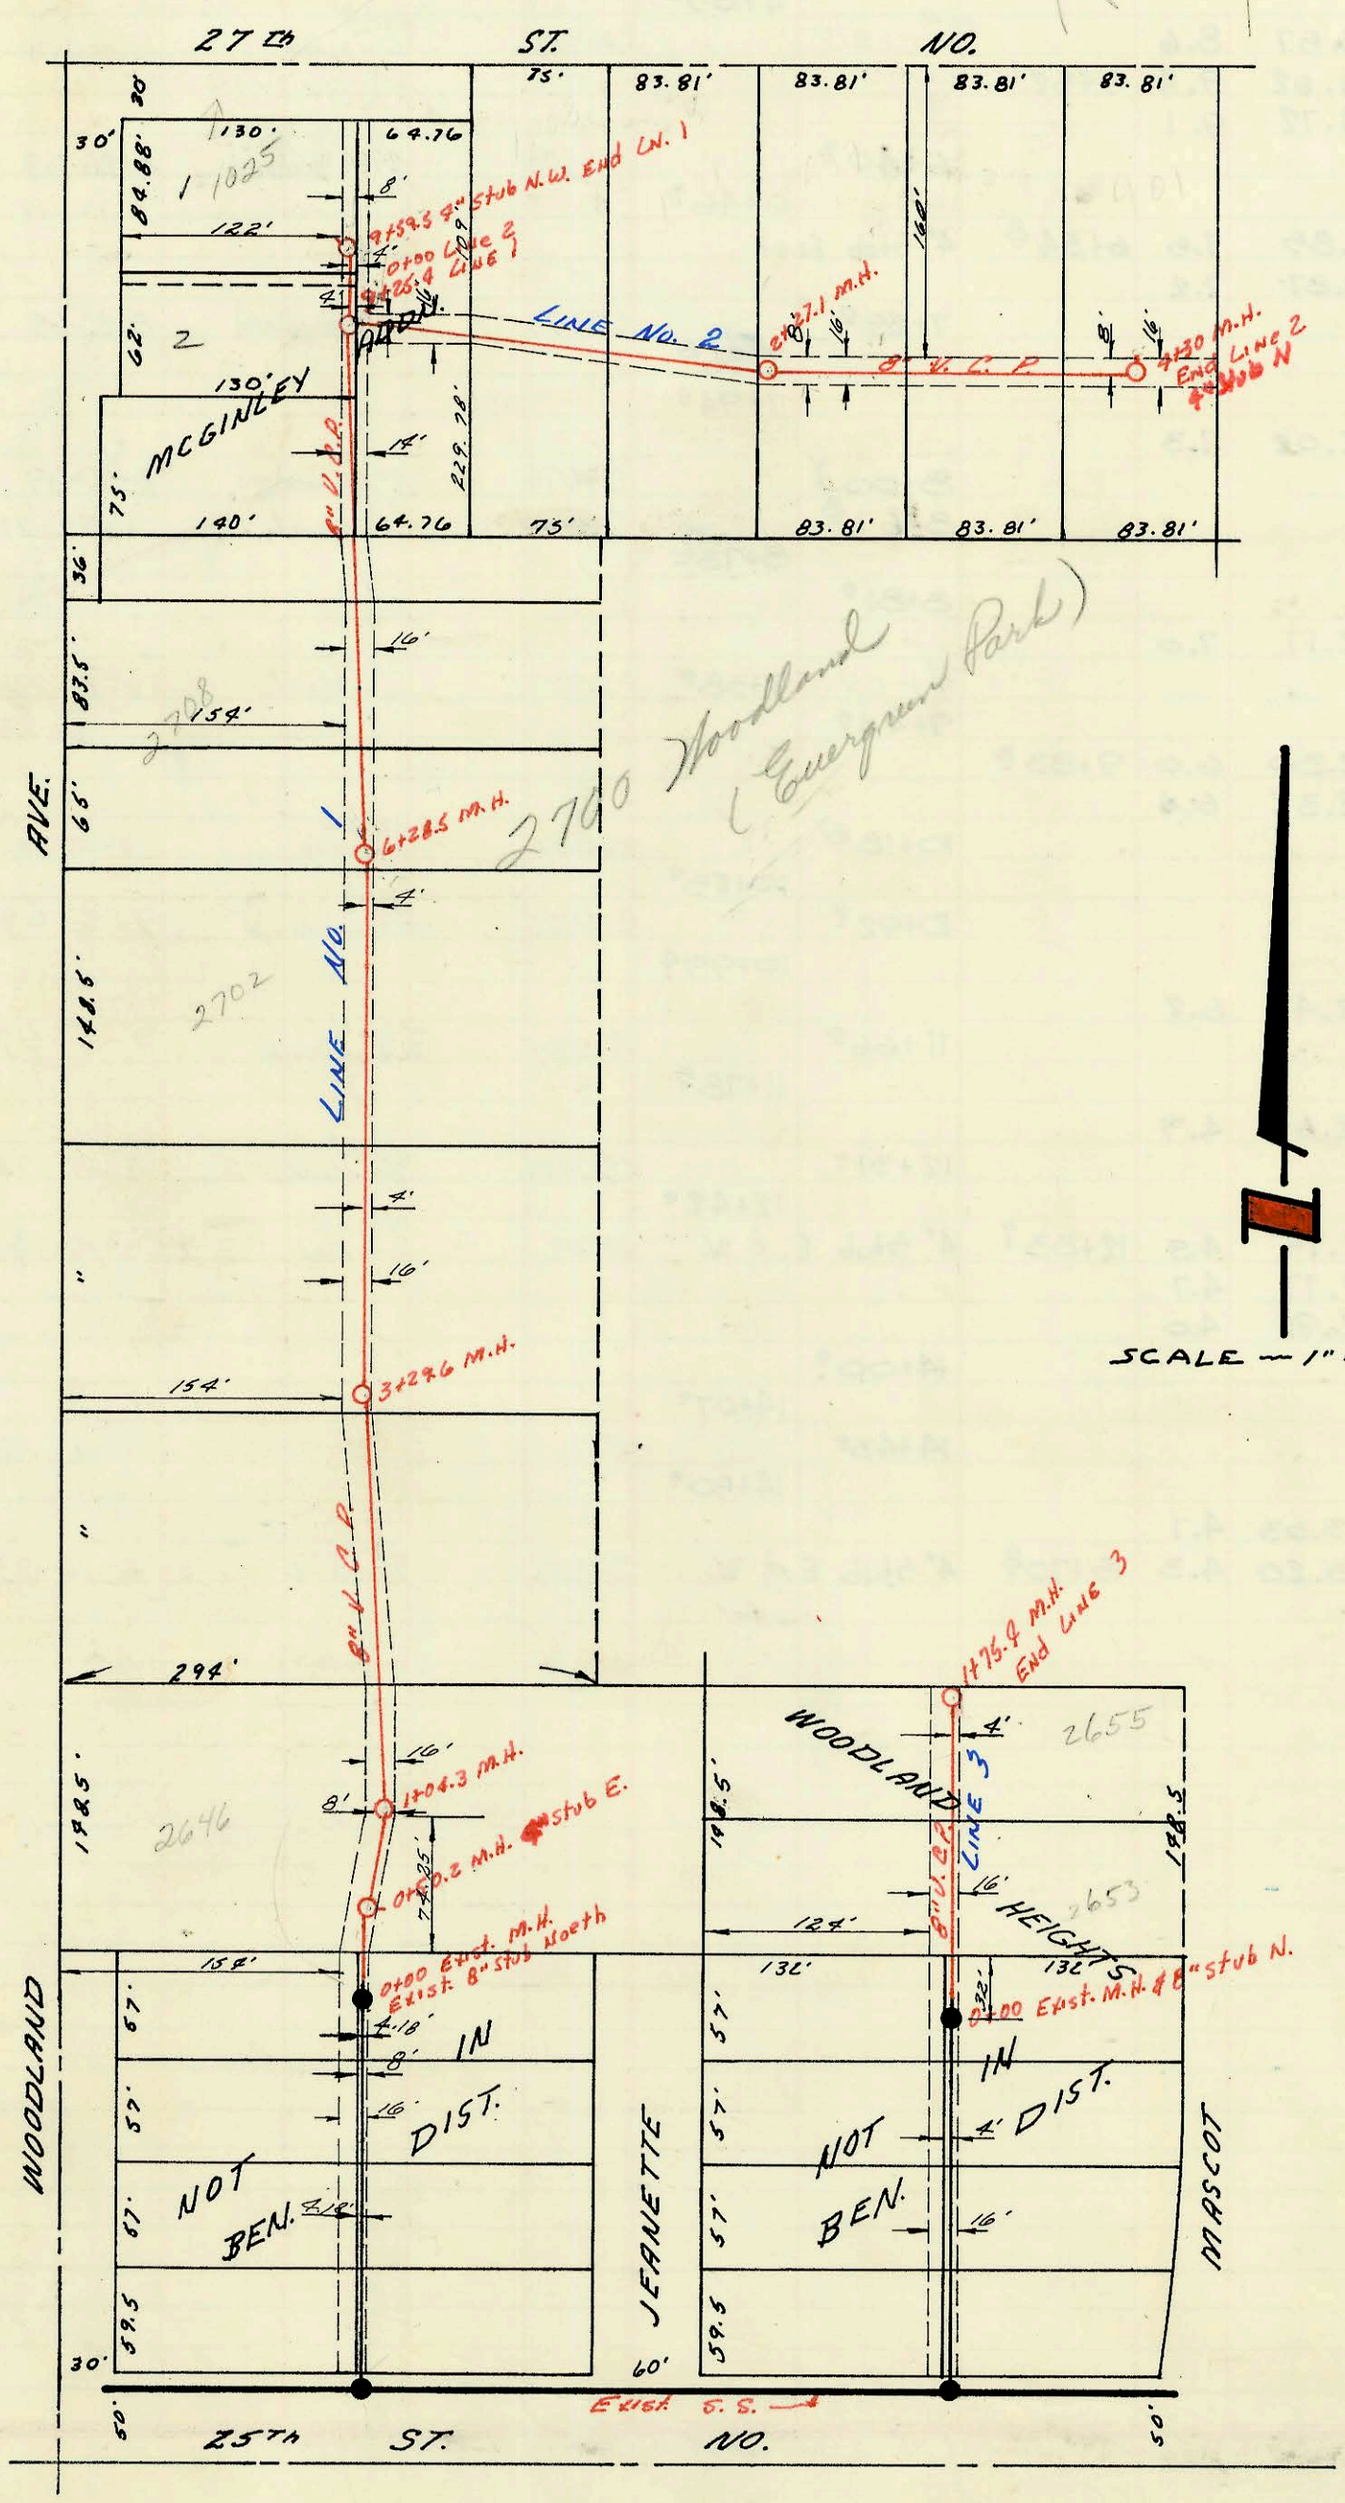

Lat. 32, DIST. T, S.S. NO. 20'

UTILITY CONTRACTORS INC.

8/22/69 PROJ. C23-5

I.H.-6

M-50

Form 42-020

	CONSTRUCTION RECORD							SERVICE RECORD					
	STATION	ELEVATION		Depth	MANHOLE	4-INCH "Y" BRANCHES		No. of Permit		House Number		DATE OF PERMITS	
		Ground	Grade			North West	South East	North West	South East	North West	South East	North West	South East
LINE 1	0+00	126.5	121.14	5.4	EXIST. 0+00								
		126.7	121.22	5.5	0+50.2	4" Stub	East						
							0+66.5						
	1+00	126.9	121.30	5.6									
		126.9	121.30	5.6	1+04.3								
							1+24.0						
						1+62.0		C-32097 C16102	seal off	2646 Woodland		5-9-72 9-29-69	
	2+00	127.0	121.44	5.6									
						2+14.0							
							2+16.0						
						2+58.0							
	3+00	128.0	121.59	6.4									
							3+04	C25722		2656 7 2658 Woodland		7-20-71	
						2+93.6 3+06		C16500				10-27-69	
		128.3	121.64	6.7	3+29.6	4" MH tap SE		C32670		2700 Woodland	Evergreen Park	6-5-72	
						6" MH tap SE	3+75.5	C32669		2700 Woodland	Evergreen Park	6-5-72	
						3+72.5							
	4+00	128.0	121.74	6.3									
	5+00	128.1	121.89	6.2									
							5+04						
						5+06							
	6+00	128.1	122.04	6.1									
		127.9	122.09	5.8	6+28.5								
						6+68.5	M.H. tap		C37937		2700 Woodland (Swimming Pool)	3-27-73	
							6+70.5						
	7+00	127.4	122.19	5.2									
						7+23.0		C26355		Seal off 2708 Woodland	temporary conn. by Wally Carter	8-11-71	
	8+00	127.5	122.34	5.2									
							8+26.0						
						8+28.0							
	9+00	127.2	122.49	4.7		9+00							
	IN	127.4	122.53	4.9									
	OUT	127.3	122.63	4.7	9+25.4								
		127.3	122.58	4.7	9+59.5	4" Stub	NW.	#C15734		1025 W. 27th St. No.		9-4-69	
LINE 2	0+00	127.3	122.63	4.7	EXIST. 0+00								
						0+99.0							
	1+00	127.3	122.74	4.6				SO. C33414 #C16377		1001 W. 27th N.		7-7-72 10-20-69	
						1+71.0							
	2+00	127.1	122.89	4.2									
					2+27.1			C31538 #C16387		Seal off 917 W. 27th N.		4-12-72 10-20-69	
						2+52.0							
	3+00	126.3	123.04	3.3									
						3+46							
	4+00	125.8	123.19	2.6									
		125.8	123.28	2.5	4+30	4" Stub	North						
LINE 3	0+00	127.2	120.30	6.9	EXIST. 0+00								
						0+45.4							
							0+57.0		C26349 C15334		Seal off 2653 Mascot		8-11-71 8-11-69
							0+79.0						
	1+00	128.1	120.50	7.6			TAP 1+50.5		C16408		2655 Mascot		10-21-69
							1+52.0						
		128.3	120.65	7.7	1+75.4								

C39176 - 2700 Woodland - Evergreen Park - 6" line into settling basin into new M.H.