


Hydraulic

Avenue

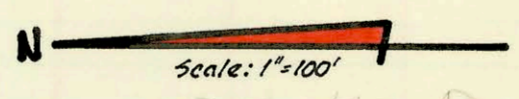

Sanitary Sewer Plan for **New Hope Addition**
 W. B. Carter Construction Company, Inc.
 Date: Oct. 17, 1969. Private Project
 Booked from Plan

4244 S. Hydraulic

CONSTRUCTION RECORD						SERVICE RECORD						
STATION	ELEVATION		Depth	MANHOLE	4-INCH "Y" BRANCHES		No. of Permit		House Number		DATE OF PERMITS	
	Ground	Grade			North West	South East	North West	South East	North West	South East	North West	South East
Lat. "A"												
0+05	1270.0	1263.21	6.8									
1+00	1270.4	1263.44	7.0		Plug							
	1270.5	1263.91 out 1263.61 in	7.0	A-2	1+25°							
2+00	1272.5	1263.76	8.7									
3+00	1272.9	1263.86 out 1263.96 in	9.0	A-3	2+51°	2+28°	C16279		*120(119-124)		10-15-69	
	1272.1	1264.06	8.0		Sta. 0+00 Lat. "D"							
4+00	1271.7	1264.26	7.4			3+04° 3+57°	C16280 C16281		202(201-206) 208(207-212)		10-15-69 10-15-69	
5+00	1271.9	1264.46	7.4	A-4		4+14° 4+71°	C16282 C16283		214(213-218) 220(219-224)		10-15-69 10-15-69	
	1272.2	1264.92 out 1264.62 in	7.7		5+27°	4" stub SW.						
6+00	1272.5	1264.76	7.8			5+60°	C16284 C16285		302(301-306) 308(307-312)		10-15-69 10-15-69	
8+00	1272.9	1264.97 out 1265.07 in	7.9	A-5	7+01°							
9+00	1271.6	1265.46	6.1									
	1271.5	1265.86	5.6	A-6	9+44°							
	1272.5	1266.04 out 1266.14 in	6.5			9+59°						
10+00	1272.7	1266.36	6.3									
						10+10° 10+52° 10+95° 75°	C16288 C16289 C16290 C16291		620(619-624) 614(613-618) 608(607-612) 602(601-606)		10-15-69 10-15-69 10-15-69 10-15-69	
11+00	1273.0	1266.76	6.2	A-7	11+24°	Sta. 0+00 Lat. "B"						
	1273.1	1266.86 out 1266.96 in	6.2									
12+00	1272.5	1267.26	5.2									
13+00	1274.2	1267.66	6.5	A-8	13+49°	Sta. 0+00 Lat. "C"						
	1273.6	1267.86	5.9			13+99°						
14+00	1273.8	1268.06	5.7			14+62°	C16304		802(801-806)		10-15-69	
15+00	1274.2	1268.46	5.7			15+14° 15+76°	C16305 C16306 C16307		808(807-812) 814(813-818) 820(819-824)		10-15-69 10-15-69 10-15-69	
16+00	1274.5	1268.86	5.6	A-9	16+25°							
	1274.5	1268.97 out 1269.07 in	5.5			16+51°						
17+00	1274.2	1269.36	4.8									
						17+12° 17+70°	C16308 C16309 C16310		902(901-906) 908(907-912) 914(913-918)		10-15-69 10-15-69 10-15-69	
18+00	1273.9	1269.76	4.1	A-10	18+45°							
	1273.7	1269.95	3.7									
Lat. "B"												
1+00	1273.0	1266.86 out 1267.47 in	5.5	A-7	0+00	Sta. 11+24° Lat. "A"						
						0+54°						
2+00	1273.3	1267.87	5.4			1+06° 1+64°	C16292 C16293 C16294		920(919-924) 514(513-518) 508(507-512)		10-15-69 10-15-69 10-15-69	
3+00	1273.6	1268.27	5.3	B-1	2+17°							
	1274.0	1268.58 out 1268.68 in	5.4		2+76°	2+99°	C16295 C16296		502(501-506) 420(419-424)		10-15-69 10-15-69	
4+00	1273.9	1268.77	5.1			3+27° 3+64°						
						3+60°	C16297 C16298		414(413-418) 408(407-412)		10-15-69 10-15-69	
5+00	1273.5	1269.17	4.3	B-2	4+01°	4+05°						
	1273.5	1269.30	4.2		4+31°		C16299		402(401-406)		10-15-69	

Lats. "C" & "D" on sheet M-62a

* Apartment numbers are substituted for house numbers. "120(119-124)" is read such that the permit is listed for apt. #120, but apts. 119-124 are all on the same hook-up. This form of notation is typical for complete project.

CONSTRUCTION RECORD						SERVICE RECORD						
STATION	ELEVATION		Depth	MANHOLE	4-INCH "Y" BRANCHES		No. of Permit		House Number		DATE OF PERMITS	
	Ground	Grade			North West	South East	North West	South East	North West	South East	North West	South East
Lots "A" & "B" on sheet M-62												
Lat. "C"	1273.6	1267.86 out 1268.24 in	5.4	A-2 0+00	Sta. 13+49°	Lat. "A"						
					0+23°		C16300		724(119-724)		10-15-69	
					0+70°		C16301		714(713-718)		10-15-69	
1+00	1273.2	1268.64	4.6		1+12°		C16302		708(707-712)		10-15-69	
					1+57°		C16303		702(701-706)		10-15-69	
	1273.0	1268.96	4.0	C-1 1+80°								
Lat. "D"	1272.9	1263.86 out 1265.80 in	7.1	A-3 0+00	Sta. 2+51°	Lat. "A"						
					0+33°		C16276		114(113-118)		10-15-69	
					0+89°		C16277		108(107-112)		10-15-69	
1+00	1273.0	1266.20	6.8		1+47°		C16276		102(101-106)		10-15-69	
	1273.2	1266.50	6.7	D-1 1+75°	6" stub NNW.		C16275		4244 S. Hydraulic		10-15-69	

** This is the street number of a building, not an apt. number as the other numbers in this column are.

