M-78A

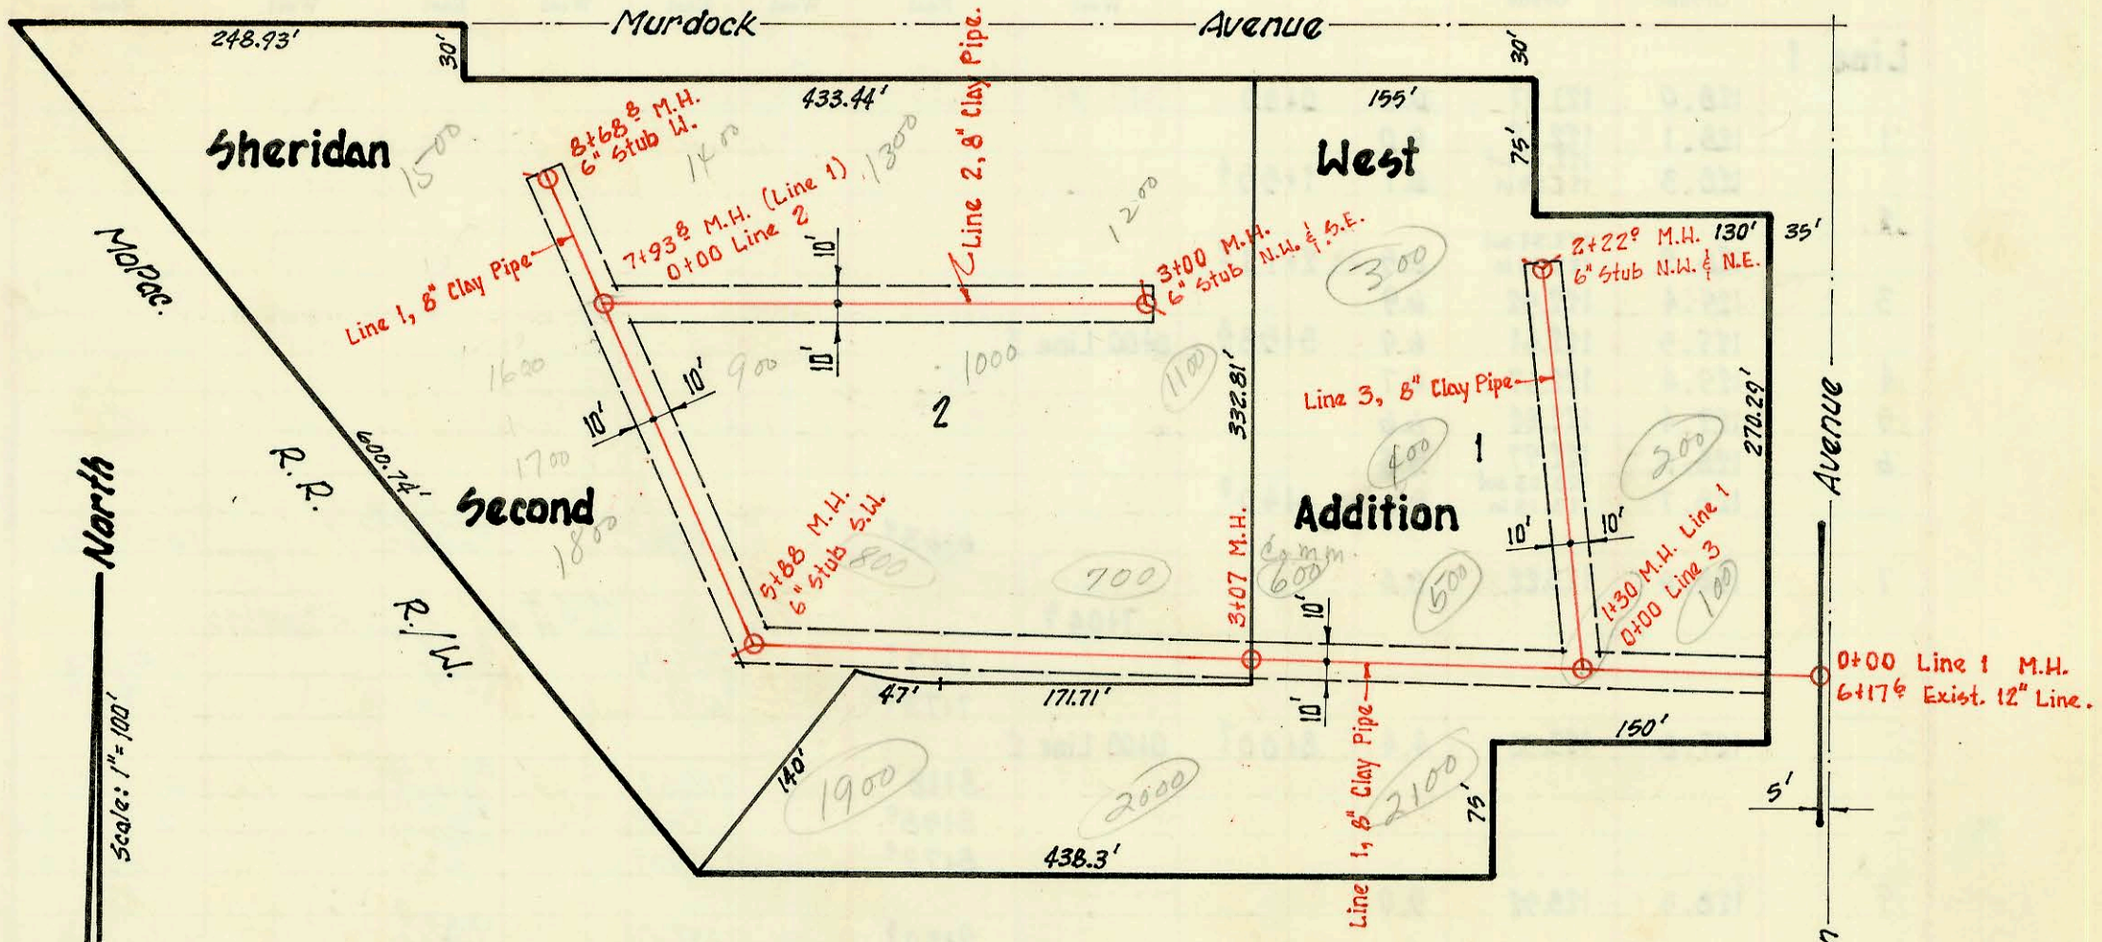

Sanitary Sewer for

Sheridan West Second Addition

Mid-States Construction Company, Inc.

Private Project.

Booked from Plan, Feb. 26, 1970.

on map

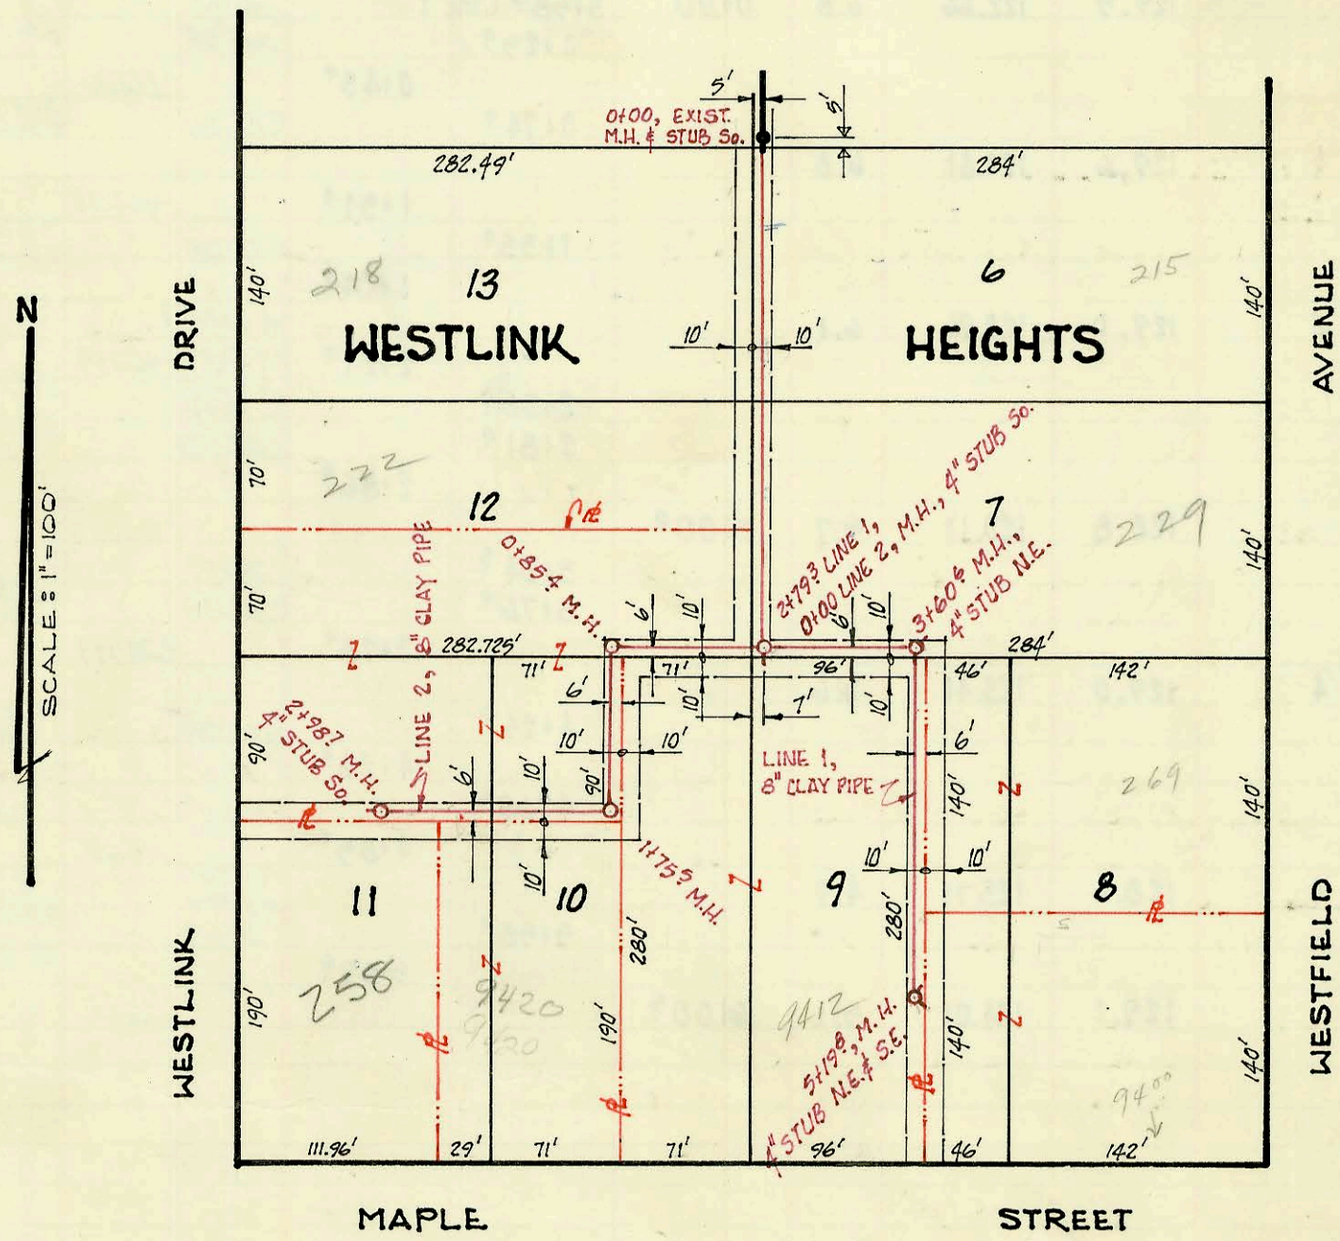

LAT. 20 WESTLINK SEWER

MID-STATES CONSTRUCTION COMPANY, INC.

BOOKED FROM K-90 8-18-70

PROJECT NO. C27-7

on map

M·78

Form 42-020

CONSTRUCTION RECORD							SERVICE RECORD					
STATION	ELEVATION		Depth	MANHOLE	4-INCH "Y" BRANCHES		No. of Permit		House Number		DATE OF PERMITS	
	Ground	Grade			North West	South East	North West	South East	North West	South East	North West	South East
Line 1												
	120.5	105.59 out 105.93 in	14.6	0+00								
1+00	121.0	107.69	13.3									
	120.5	108.17	12.3	1+30	0+00 Line 3							
2+00	119.3	108.52	10.8									
						2+37.5		#C18184		803 N. Sheridan		3-2-70
					2+70 Bldg 600		#C18183		803 N. Sheridan		3-2-70	
	120.2	109.02	10.2	3+07								
						3+67						
4+00	121.0	109.52	11.5		Est 3+76 Bldg 700	3+72 Bldg 2000	C18361	C18185	803 N. Sheridan	803 N. Sheridan	3-11-70	3-2-70
5+00	122.0	110.02	12.0			5+00						
					5+02 Bldg 800	5+11 Bldg 1900	C18360	C18186	803 N. Sheridan	803 N. Sheridan	3-11-70	3-2-70
	122.4	110.37 out 110.47 in	11.9	5+88	6" Stub S.W. Bldg 1800		C21177		803 N. Sheridan		9-30-70	
6+00	122.3	110.62	11.7									
					6+82 (6" Wye) Bldg 1700		C21176		803 N. Sheridan		9-30-70	
7+00	121.8	111.12	10.7									
					7+68 Bldg 1600		C21175		803 N. Sheridan		9-30-70	
	121.0	111.57	9.4	7+93.8	0+00 Line 2							
	120.3	111.99	8.3	8+68.8	6" Stub W. Bldg 1500		C21174		803 N. Sheridan		9-30-70	
Line 2												
	121.0	111.67	9.3	0+00	7+93.8 Line 1							
					0+43 Bldg 1400		C21173		803 N. Sheridan		9-30-70	
						0+85 Bldg 900		C21169		803 N. Sheridan		9-30-70
1+00	122.0	112.67	9.3									
					1+56 Bldg 1300		#C21172		803 N. Sheridan		9-30-70	
2+00	122.5	113.67	8.8									
						2+09.5 Bldg 1000		#C21170		803 N. Sheridan		9-30-70
	123.5	114.67	8.8	3+00	6" Stub N.W. & S.E. Bldg 1100			#C18187		803 N. Sheridan		3-2-70
						Bldg 1200	#C21171		803 N. Sheridan		9-30-70	
Line 3												
	120.5	111.25	9.3	0+00	1+30 Line 1							
						0+54 Bldg 100		#C18178		803 N. Sheridan		3-2-70
					0+56 Bldg 500		#C18182		803 N. Sheridan		3-2-70	
1+00	121.5	112.75	8.7									
						1+53 Bldg 200		#C18179		803 N. Sheridan		3-2-70
					1+55 Bldg 400		#C18181		803 N. Sheridan		3-2-70	
2+00	123.7	114.25	9.5									
	124.0	114.63	9.4	2+22	6" Stubs N.E. & N.W. Bldg 300			#C18180		803 N. Sheridan		3-2-70
LAT. 20 WESTLINK SEWER												
Line 1												
	155.8	147.98	7.8	EXIST 0+00								
					0+49!		C22624		218 S. Westlink	215 S. Westfield	1-20-71	
						0+54.3		C23243				3-12-71
					0+98.0							
1+00	156.9	148.18	8.7									
						1+05.0						
					1+84.7		#C23448		222 S. Westlink		3-25-71	
2+00	158.4	148.38	10.0									
	158.8	148.54 out 148.64 in	10.3	2+79.3		4" Stub So.						
3+00	158.4	148.68	9.7									
4+00	156.5	149.06	7.4									
						4+38.4		C23513		269 S. Westfield		3-30-71
					4+78.7		#C20225		9412 W. Maple		7-24-70	
5+00	157.6	149.46	8.1									
	157.4	149.58	7.8	5+19.8	4" Stub N.E.	4" Stub S.E.		C23083		9400 W. Maple		3-2-71
Line 2												
	159.0	148.64	10.4	0+00	(2+79.3, Line 1)							
	160.5	148.98 out 149.08 in	11.5	0+85.4								
1+00	161.8	149.14	12.7									
	161.4	149.44 out 149.54 in	12.0	1+75.5								
2+00	161.2	149.64	11.6									
					2+07.9							
						2+21.0		C23283		9420 W. Maple		3-15-71
						2+66.8		C23241		258 S. Westlink		3-12-71
	160.9	150.04	10.9	2+98.7		4" Stub So.						

94-5124-7- ~~4-12-94~~ Rep. 229 S. Westfield (New Garage) - tied into existing 4" clay line 1-wye; 1-22; 1-4" C.O.; 4" ABS