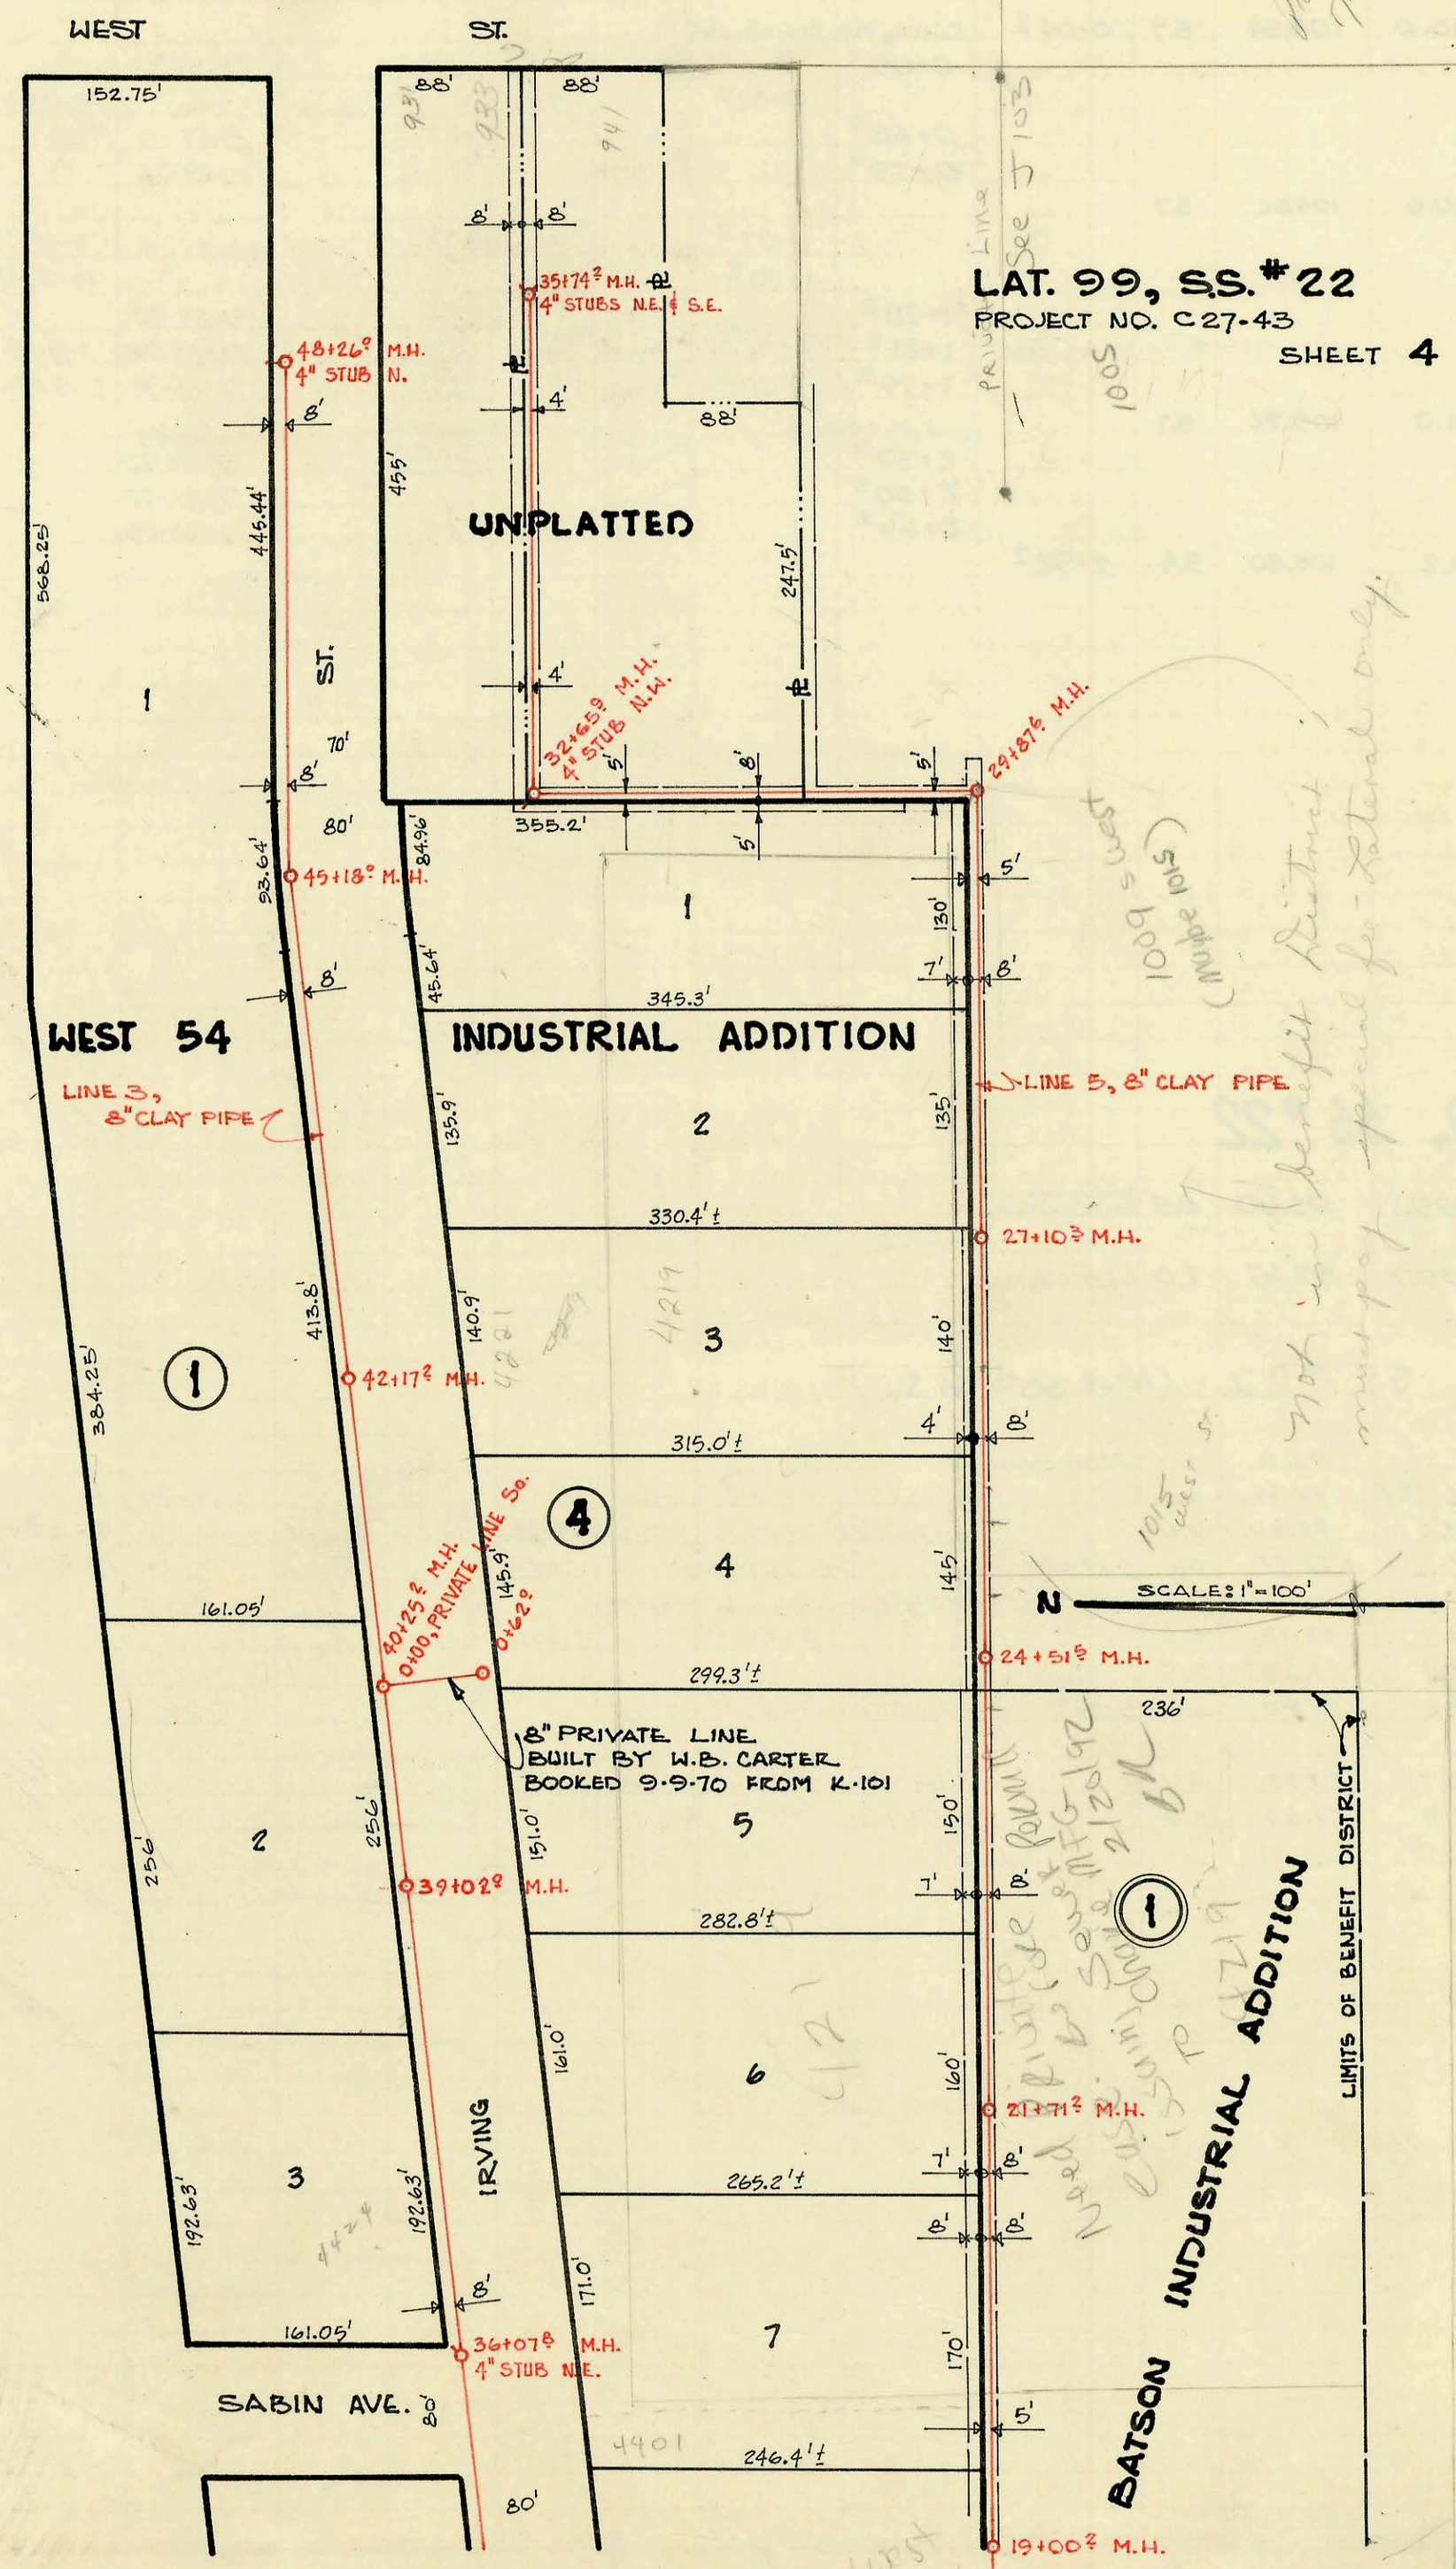
LAT. 99, S.S. #22
PROJECT NO. C27-43
SHEET 4 OF 4
WEST ST.
152.75'
88'
88'
8'
8'
35+74 M.H.
4" STUBS N.E. & S.E.
48+26 M.H.
4" STUB N.
8'
4'
88'
455'
UNPLATTED
247.5'
568.25'
446.44'
ST.
1
4'
32+65 M.H.
4" STUB N.W.
29+87 M.H.
70'
8'
5'
8'
5'
80'
355.2'
5'
93.64'
84.96'
45+18 M.H.
1
5'
130'
45.64'
8'
7'
8'
345.3'
WEST 54
INDUSTRIAL ADDITION
LINE 3, 8" CLAY PIPE
LINE 5, 8" CLAY PIPE
135.9'
2
135'
330.4'±
27+10 M.H.
413.8'
140.9'
3
140'
384.25'
1
42+17 M.H.
4'
8'
315.0'±
4
145.9'
4
145'
161.05'
40+25 M.H.
0+00, PRIVATE LINE So.
0+62
N
SCALE: 1"=100'
24+51 M.H.
299.3'±
236'
8" PRIVATE LINE
BUILT BY W.B. CARTER
BOOKED 9-9-70 FROM K-101
256'
2
256'
151.0'
5
150'
39+02 M.H.
7'
8'
282.8'±
1
161.0'
6
160'
21+71 M.H.
192.63'
3
192.63'
IRVING
7'
8'
265.2'±
8'
8'
8'
171.0'
7
170'
161.05'
36+07 M.H.
4" STUB N.E.
5'
SABIN AVE.
80'
246.4'±
BATSON INDUSTRIAL ADDITION
LIMITS OF BENEFIT DISTRICT
80'
19+00 M.H.

M-99

Form 42-020

CONSTRUCTION RECORD							SERVICE RECORD					
STATION	ELEVATION Ground	ELEVATION Grade	Depth	MANHOLE	4-INCH "Y" BRANCHES North West	4-INCH "Y" BRANCHES South East	No. of Permit North West	No. of Permit South East	House Number North West	House Number South East	DATE OF PERMITS North West	DATE OF PERMITS South East
Line 5 (CONT.) – Lat. 99, S.S.# 22												
						5+93?						
					5+95?							
6+00	113.0	105.02	8.0									
	113.0	105.10	7.9	6+49!	4" MH TAP		C34563		1360 S. ANNA		8-28-72	
7+00	113.0	105.17	7.8			7+06?						
					6" SDR 35 7+08?		20022		1350 Anna		1-28-88	
8+00	113.6	105.32	8.3									
					TAP 7+99	8+11?	C64122		1332 S. Anna		11-22-77	
					8+13?	8+20.0	C34929	16166	1342 S. Anna	1331-5 Young 1313 S	9-18-72	4-23-86
	114.0	105.43	8.6	8+70?	8+75.3	9+08.5	C58832	C59270	1332 S. Anna	Young	11-24-76	12-23-76
9+00	113.4	105.47	7.9			9+15?						
					9+17?							
10+00	114.3	105.62	8.7		TAP 10+64 ~~10+12?~~	10+10?	C60368		1314 S. Anna		3-14-77	
	113.7	105.76 OUT 105.86 IN	7.9/7.8	10+94?								
12+00	114.3	106.02	8.3		12+02?		C71601		1001 S. Young		5-3-79	
	114.9	106.15 OUT 106.25 IN	8.7	12+84?								
13+00	114.5	106.27	8.2									
	116.0	106.36	9.6	13+62?								
14+00	116.0	106.52	9.5		14+68?	14+45?	20055 C38542		4501 W. Irving	Rel	7-21-05 4-27-73	
15+00	116.3	106.67	9.6		15+33?							
						15+35?						
16+00	116.6	106.82	9.8		16+11?							
						16+13?						
	116.2	106.86	9.3	16+31?								
					16+50?							
17+00	115.7	106.97	8.7		17+40?		C21356		4501 W. Irving		10-14-76	
						17+42?						
18+00	115.2	107.12	8.1		18+52?							
						18+54?						
	114.5	107.27	7.2	19+00?		17+31.8 tap		92-23457 C64335		4219 W. Irving		12-6-77
					19+56.2	19+65?	9413		4401 W Irving		10-11-83	
20+00	113.8	107.42	6.4			20+52?						
21+00	113.9	107.57	6.3			21+54?						
	113.9	107.68	6.2	21+71?		TAP 21+16.5		C64339		4219 W. Irving		12-6-77
22+00	113.8	107.72	6.1			22+51?						
23+00	113.0	107.87	5.1			23+52?						
24+00	113.5	108.02	5.5									
	114.0	108.10	5.9	24+51?								
						24+64?						
25+00	113.6	108.17	5.4		25+83?	25+75.3 tap	10121	14550		1015 S. West	1009 S. West J-103	8-21-85
					tap 25+64	25+85?	C29098	C77059	4219 Irving	1015 S. West	11-22-71	3-28-80
26+00	113.6	108.32	5.3		tap 26+17.3	27+21.3	C29027	C 51074	4219 Irving	4219 W. Irving C	11-16-71	8-27-75
	113.3	108.49	4.8	27+10?	6" STUB N.	6 STUB N.E.	C20774	C20808	4219 Irving	4219 Irving	8-31-70	9-2-70
28+00	113.7	108.62	5.1		28+51!		C20777	(rear)	4201 Irving		8-31-70	
29+00	114.1	108.77	5.3									
	113.6	108.90 OUT 109.00 IN	4.7/4.6	29+87?								
30+00	113.5	109.02	4.5									
31+00	114.6	109.17	5.4		31+33?							
					31+43.9	TAP	C20775	(front)	4201 Irving		8-31-70	
32+00	114.7	109.32	5.4		32+61.9	TAP	C20776		4133 Irving		8-31-70	
	114.6	109.41 OUT 109.51 IN	5.2/5.1	32+65?	4" STUB N.W.							
33+00	114.4	109.57	4.8									
34+00	114.0	109.72	4.3									
35+00	113.8	109.87	3.9									
					35+64?			12999 C35451		931 S. West		1-28-85 10-17-72
	113.4	109.92	3.5	35+74?	4" STUB N.E.	4" STUB S.E.		C35199		941 S. West		10-4-72
					M.H.	tap	C23905		9335 West		4-22-71	

C35400 - 1355 S Young - Ernie Schuster - 10-13-72 - Tap (into 6+49.1 MH.)

H19961 - 4219 W. IRVING - Leon Stallcup 3-19-87 TAP 26+28.4

92-17739-7 5/27/92 - 4219 W IRVING (New add) - MORRIS - NC - (6" SDR 35 41½ E. of M.H.)