

EXIST. MAIN
MH 23
(1+51)

TRAP

MH 19
(3+35)

MH 18
(2+00)

EXIST. MH
(6+04)

See Note in
B 211 concerning
Duck Ponds in Riverside PK
12796

MH-2
(4+259)

3722.7 as
meas in field
7-26-76

18" Clay (0+15)

MH-1
(0+00)


Lift
Station

18" C.L.P.
Force Main

MH 24

Exist. Sewer
Pine St.

235' to next MH
as per flow crew
7-15-76

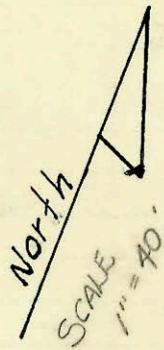

Sanitary Sewer for
PARK PLAZA "A" Project Kans. R-17 (Urban Renewal)
SHEET 4 OF 5

DN Map

MH 3
(2+60)

18" Clay Pipe

18" Clay Pipe

18" Clay Pipe

18" Clay Pipe

18" Clay Pipe

VE WACO

CONSTRUCTION RECORD

SERVICE RECORD

STATION	ELEVATION		Depth	MANHOLE	4-INCH "Y" BRANCHES		No. of Permit		House Number		DATE OF PERMITS	
	Ground	Grade			North West	South East	North West	South East	North West	South East	North West	South East
SEWER WEST FROM M.H. 1												
1+15	13.41	96.75	16.66	M.H. 1								
2+00	12.31	97.46	14.85									
3+00	13.69	98.30	15.39									
4+00	13.83	99.14	14.69									
4+25.9	13.82	99.36	14.46	M.H. 2								
5+00	14.30	99.98	14.32									
6+04 OUT	19.80	100.85	18.95	EXIST. M.H.								
SEWER SOUTH FROM M.H. 1												
0+18		96.68		DEEP WELL								
0+25	13.49	96.69	16.80									
1+00	14.00	96.78	17.22									
2+00	12.94	96.90	16.04									
2+60	13.12	96.97	16.15	M.H. 3								
SEWER NORTH FROM M.H. 1												
0+02	13.19	100.56	12.59	M.H. 1	MA Jap		C 74710		7077 Dard		10-5-79	
1+00	14.08	102.32	11.76									
2+00	14.12	104.04	10.08	M.H. 18								
3+00												
3+35 OUT	16.47	106.36	10.11	M.H. 19								
SEWER EAST FROM M.H. 19												
0+00		106.36		M.H. 19								
0+50	16.92	106.56	10.36									
1+00	16.29	106.76	9.53									
1+51	16.18	106.96	9.22	M.H. 23								
SEWER EAST FROM LIFT STATION IS CAST IRON FORCE MAIN												