M-108 A

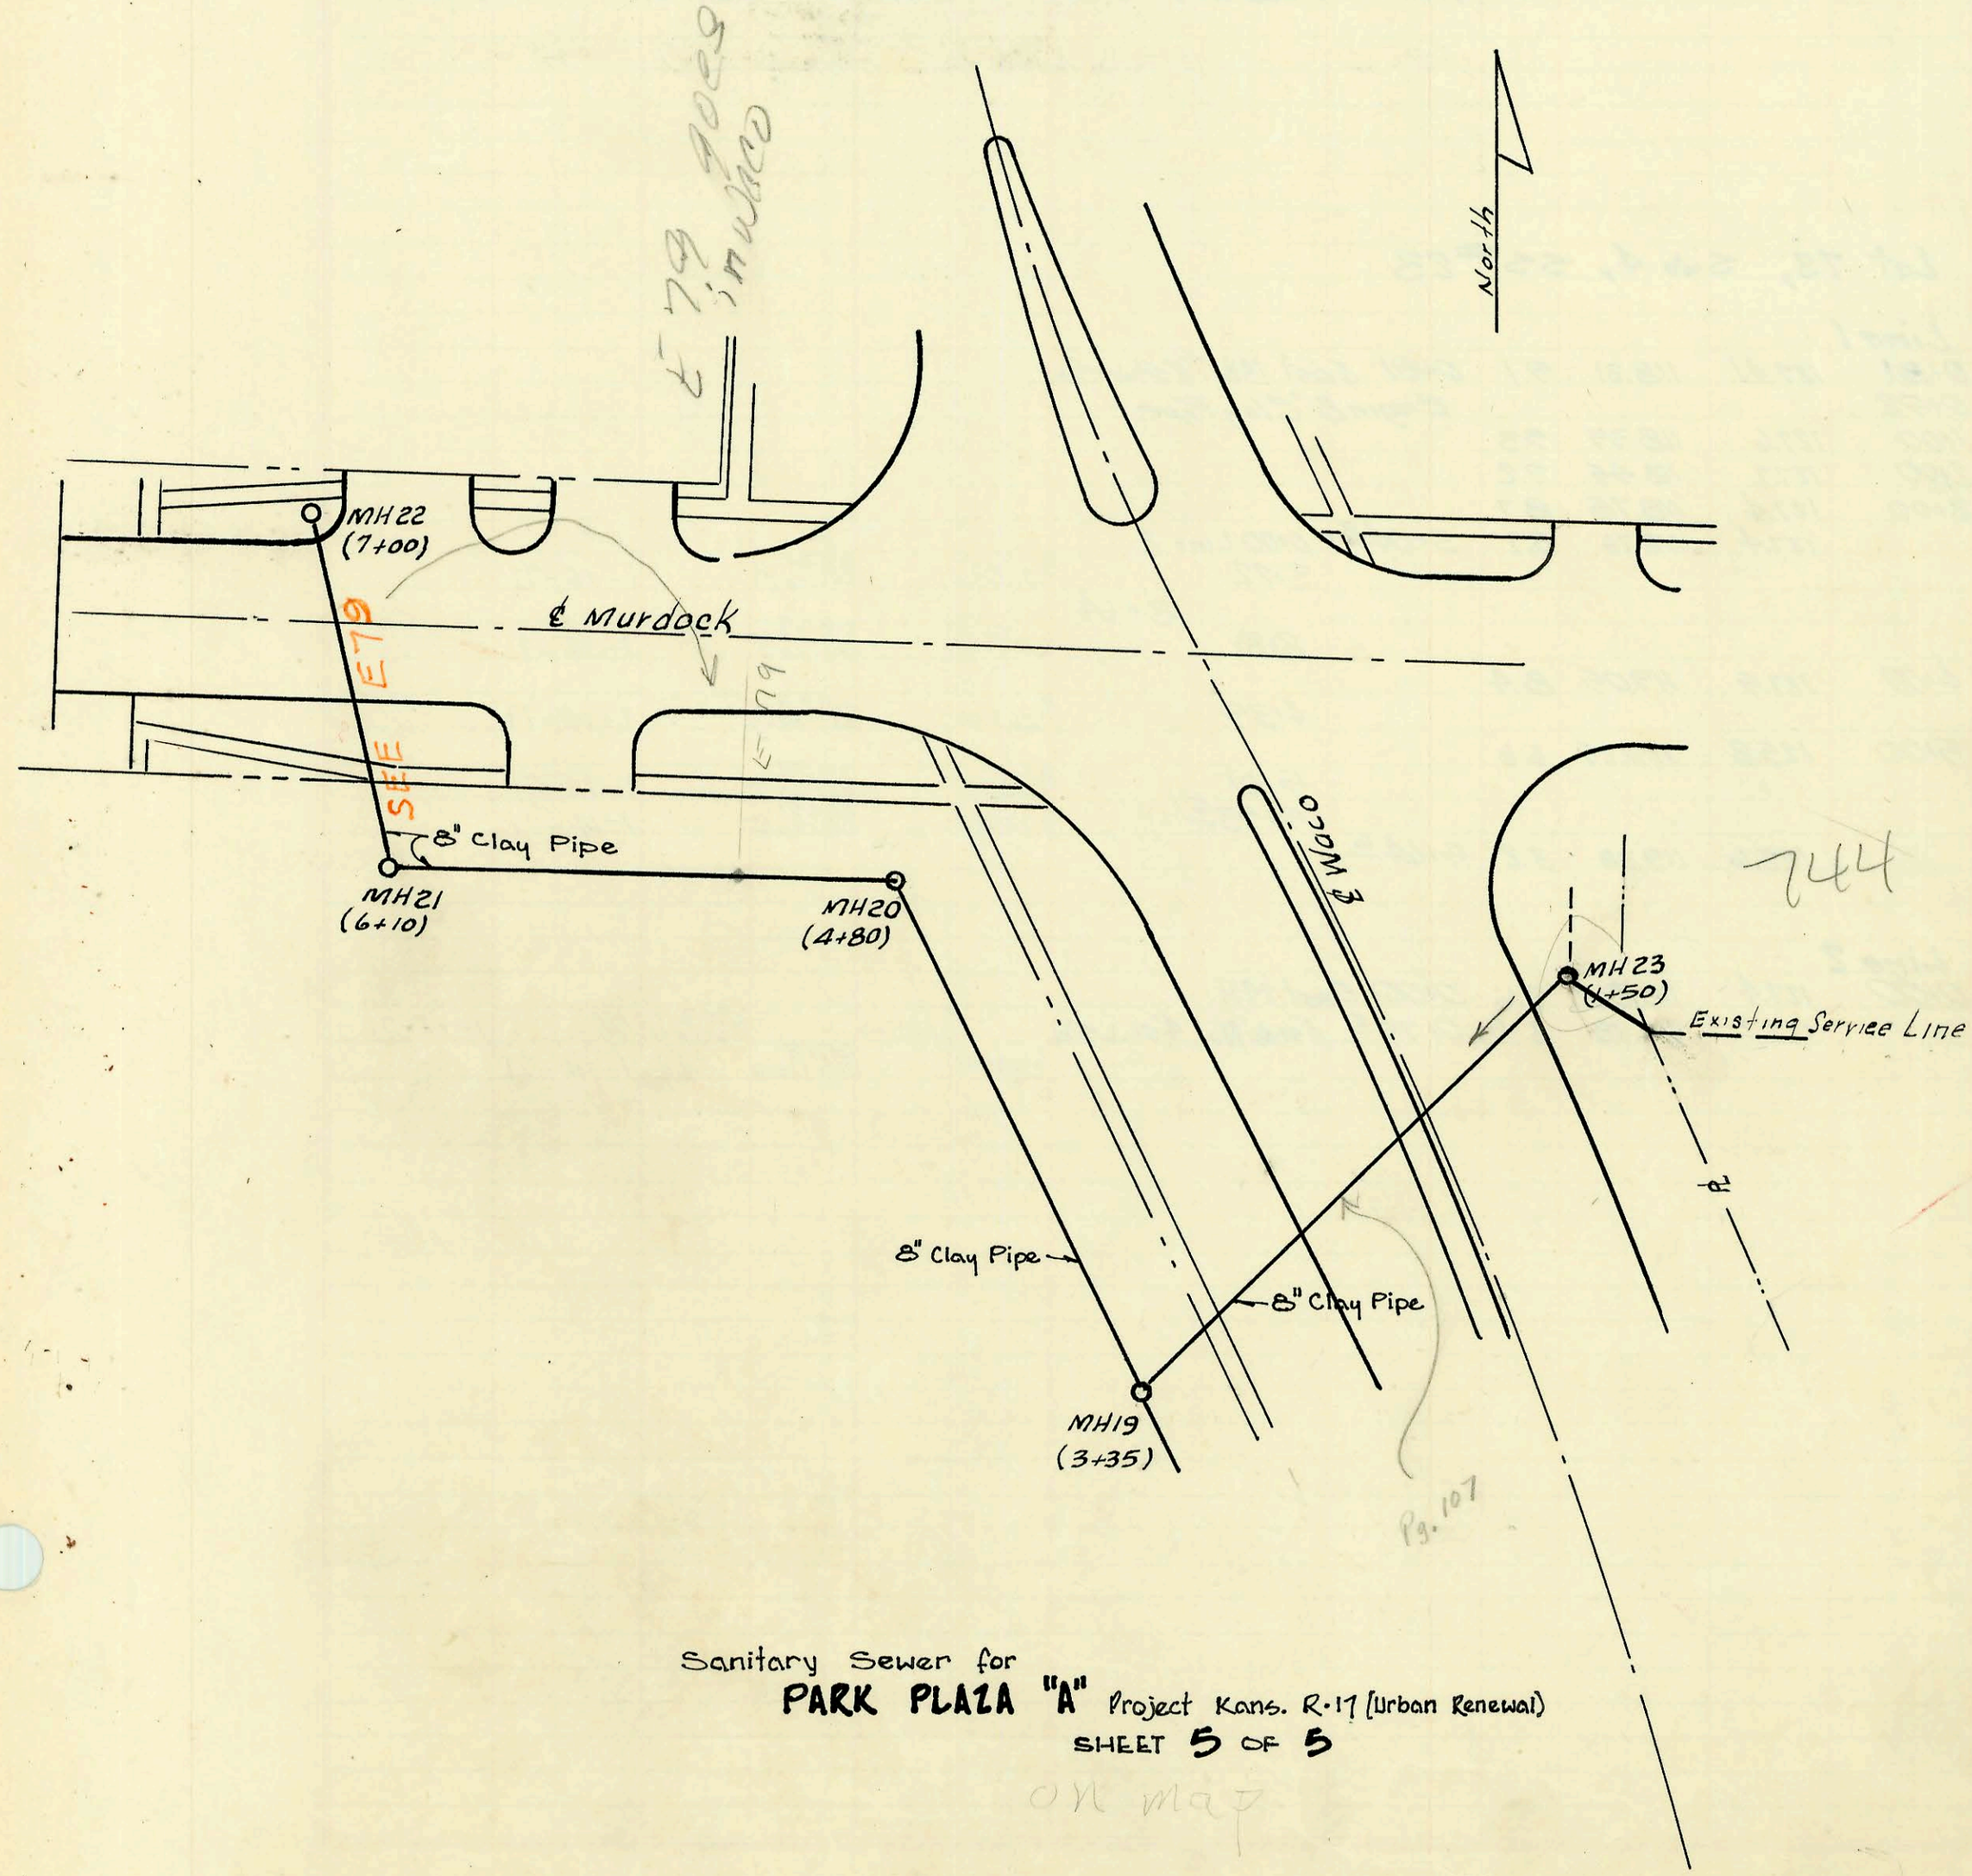

Sanitary Sewer for
PARK PLAZA "A" Project Kans. R-17 (Urban Renewal)
SHEET 5 OF 5

M-108

Form 42-020

CONSTRUCTION RECORD							SERVICE RECORD					
STATION	ELEVATION		Depth	MANHOLE	4-INCH "Y" BRANCHES		No. of Permit		House Number		DATE OF PERMITS	
	Ground	Grade			North West	South East	North West	South East	North West	South East	North West	South East
3+35 IN	16.47	108.32	8.15	M.H. 19								
4+00	16.42	108.58	7.84									
4+80	15.73	108.90	6.83	M.H. 20								
5+00	15.91	108.98	6.93									
6+00	16.67	109.38	7.29									
6+10 OUT	17.05	109.42	7.63	M.H. 21								
IN		113.27	3.57									
6+50	16.36	113.75	2.61									
7+00	18.00	114.35	3.65	M.H. 22								
				M.H. 23	M+Tap		SO C29663	C72858	(Swift Co.) 307-11 W. Murlock	744 N Vacs	12-23-71	7-10-79