M-138A

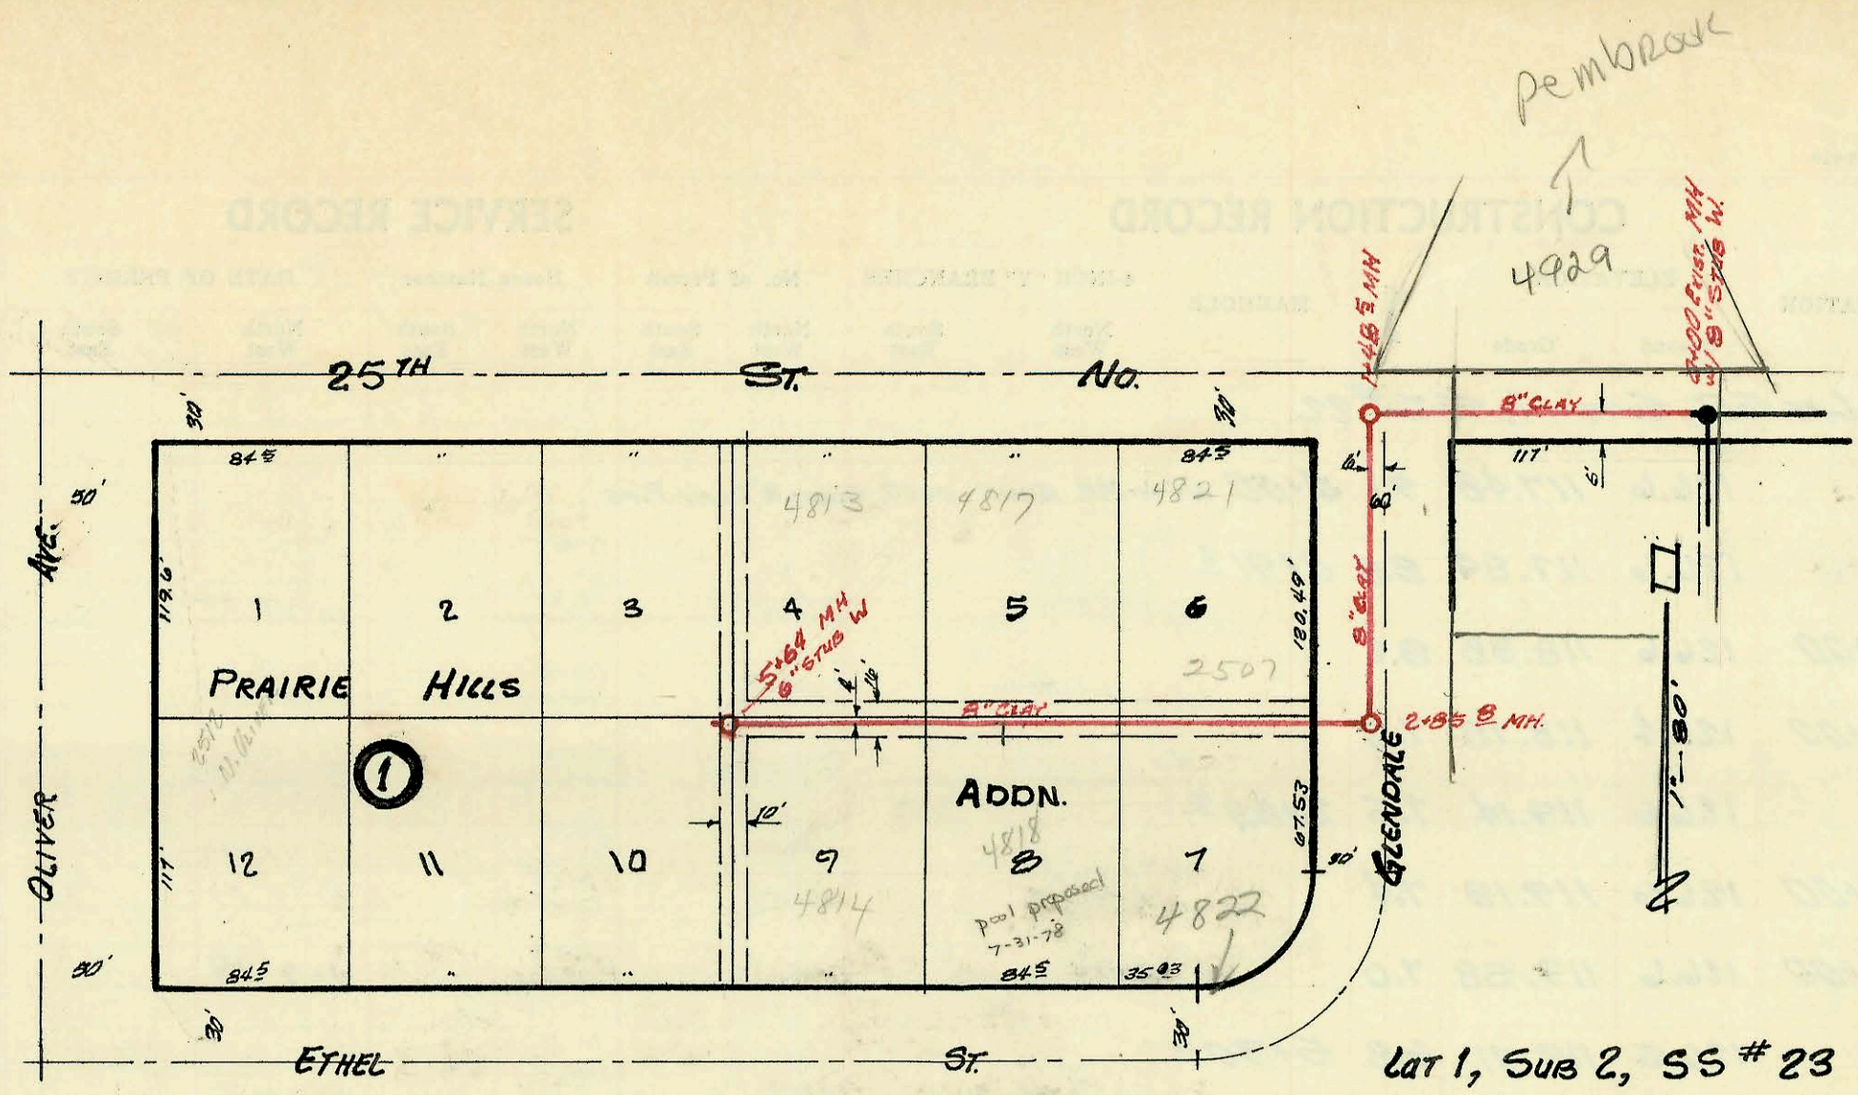

LAT 1, SUB 2, SS # 23
BUILT BY: W.B. CARTER CONST CO. INC
BOOKED 1 JULY 71 FROM IH-76
PROJECT NO DBKL571003

Pipe for Table above 2-13-74

Caution - Water Table
Use Well Points

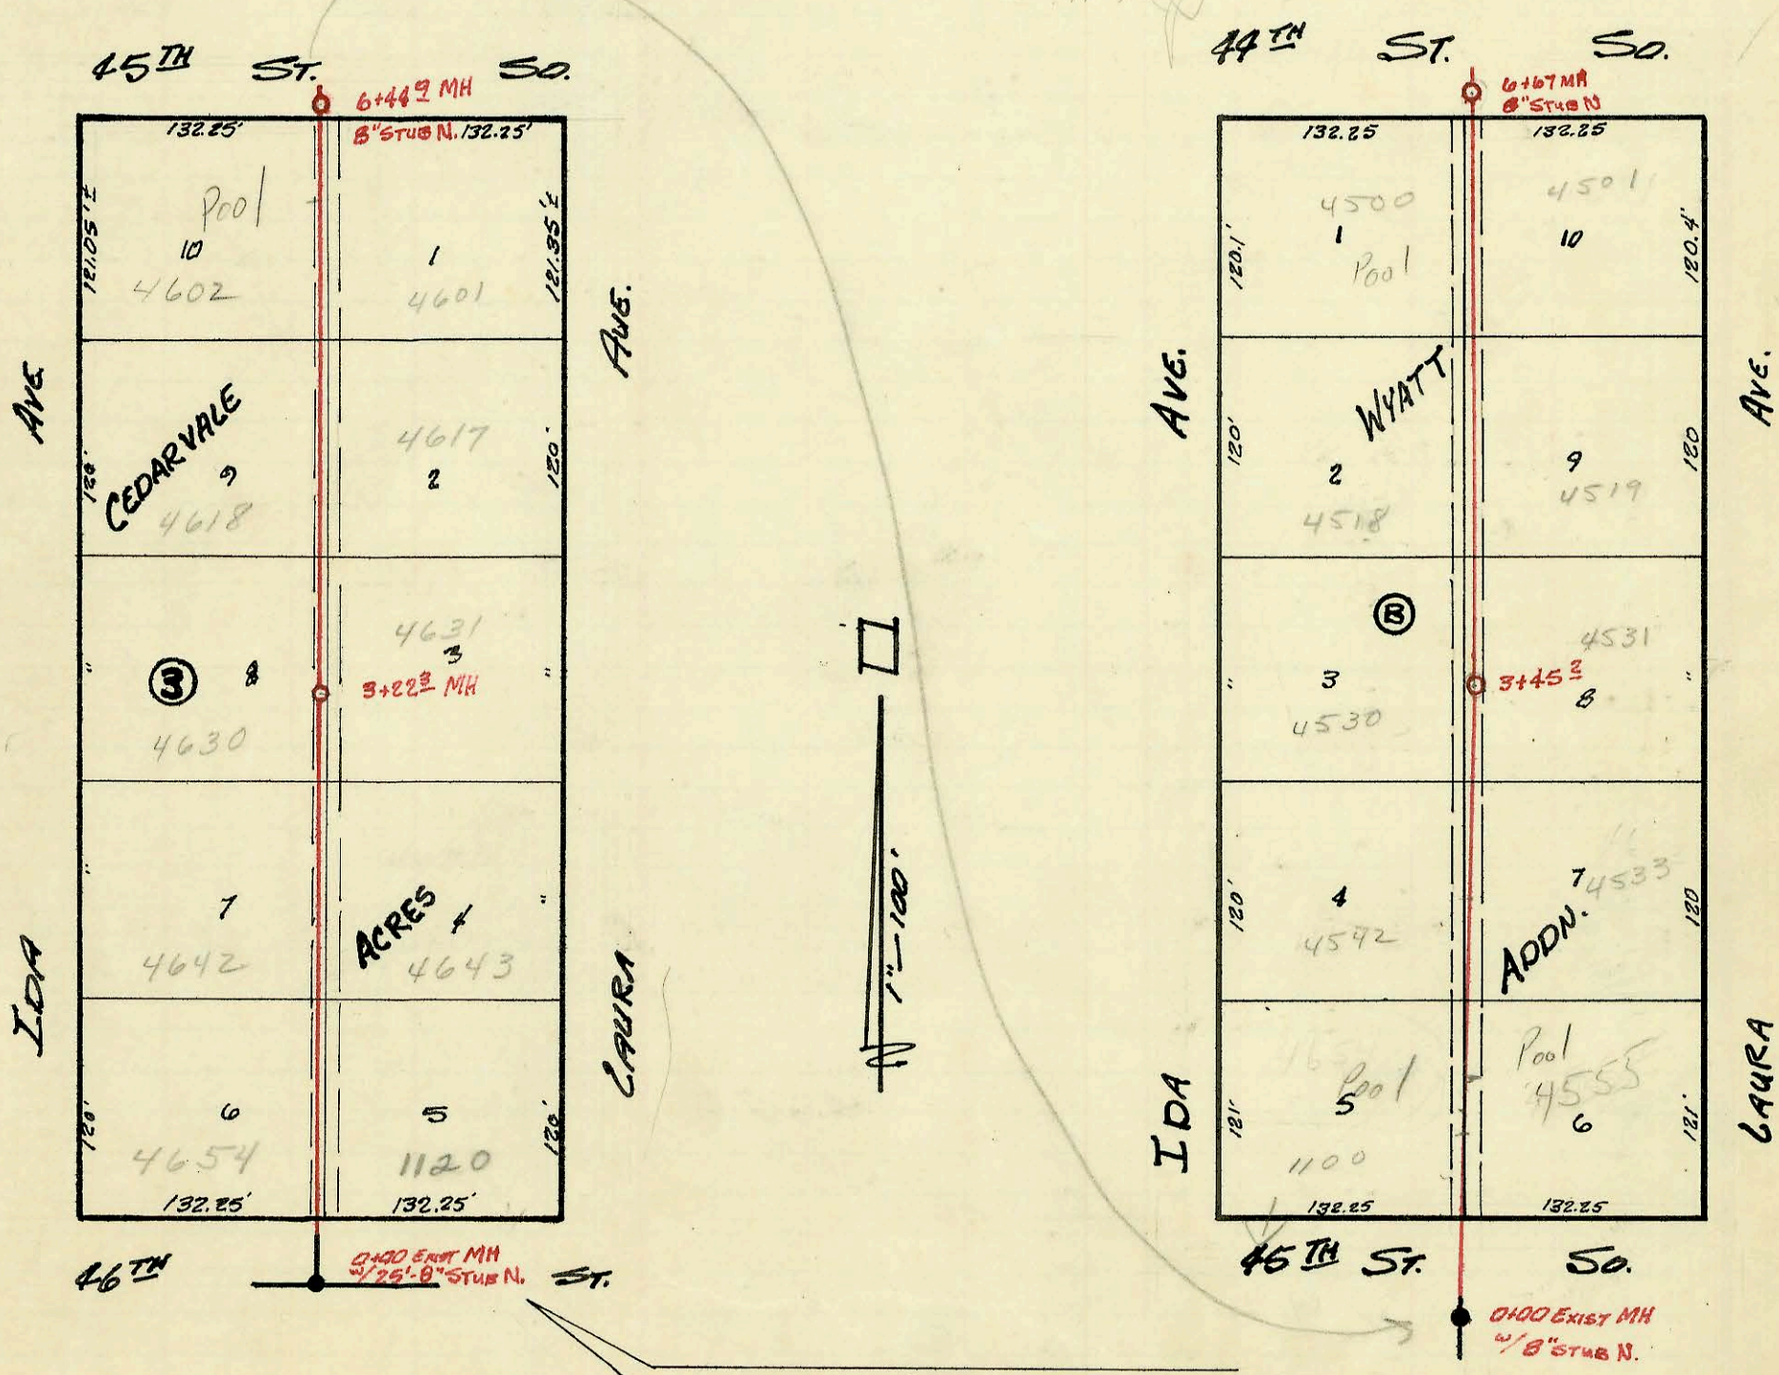

LAT 23, SUB 1, S.W.I
BUILT BY: MID STATES CONST.
BOOKED 1 JULY 71 FROM IH-70
PROJ NO. DBKL570059

LAT 13, SUB 1, S.W.I.
BUILT BY: MID-STATES CONST CO.
BOOKED 11 AUG 71 FROM 264-4
PROJ NO DBKL570081

M-138

Form 42-020

CONSTRUCTION RECORD							SERVICE RECORD					
STATION	ELEVATION		Depth	MANHOLE	4-INCH "Y" BRANCHES		No. of Permit		House Number		DATE OF PERMITS	
	Ground	Grade			North West	South East	North West	South East	North West	South East	North West	South East
LAT 1,	SUB 2,	SS #23										
0+00	179.3	168.10	11.2	0+00 EXIST W/8" STUB W		4" SC440 0+85	2000 02029		4929 Pembleton Ct		9-1200	
1+00	181.7	168.50	13.2									
	182.2	168.70	13.5	1+48 5								
2+00	182.3	169.00	13.5									
	182.3	169.34	13.0	2+85 8								
3+00	182.5	169.50	13.0		tap 3+45 8		C43462		4821 E. 25th N.		2-13-74	
4+00	182.3	169.90	12.4		4+37.4 tap	3+51 8	C13569	C42457	4817 E. 25th N.	4822 Ethel	8-13-79	11-27-73
					tap	4+42		C25316		4818 Ethel		7-6-71
5+00	181.5	170.30	11.2		tap	4+94 2		C39201		4814 Ethel		5-24-73
					tap	5+06 6	C4347		4813 E. 25th N.		2-26-74	
	180.2	170.56	9.6	5+64 0	4" ABS OK 6" STUB W	M. H. tap	91-18919-07	C26376	2512 Oliver	2512 N. Oliver	3-13-91	8-11-71
LAT 23,	SUB 1,	S.W.I.										
0+00	83.2	75.02	8.2	0+00 EXIST MH W/25'-8" STUB N.								
						tap 0+85.9		C54372		1120 E 46th St		3-23-76
1+00	83.1	75.22	7.9		tap 0+62		C25521		4654 Ida		7-14-71	
					TAP 1+78 9		C28954		4642 IDA		11-11-71	
2+00	83.4	75.42	8.0			tap 2+33.6		C25522		4643 Laura		7-14-71
3+00	83.3	75.62	7.7									
					tap 3+12 7	tap 3+16.3	C43424	C43423	4630 Ida	4631 Laura	2-11-74	2-11-74
	83.5	75.66	7.8	3+22 3								
4+00	83.4	75.82	7.6			4+54.7 8 tap 4+31.5		#02775 C44612		4617 S Laura		3-6-81 4-25-74
					4+11.8		C63418		4618 Ida		10-7-77	
5+00	84.2	76.02	8.2									
					tap 5+86 2		C29593		4607 Ida		12-21-71	
6+00	84.2	76.22	8.0			tap 6+44 9		C31923		4601 Laura		5-1-72
	84.5	76.31	8.2	6+44 9	8" STUB N.							
LAT 13,	SUB 1,	S.W.I.										
0+00	88.2	76.31	11.9	0+00 EXIST W/8" STUB N.								
					tap 1+14.3		C64849		1100 E. 45th		1-16-78	
1+00	89.1	76.51	12.6			Tap 1+31 0		C29934		4555 Laura		1-11-72
2+00	89.2	76.71	12.5									
					2+59.6	tap 2+27 0	C64832	C32535	4542 Ida	4533 Laura	1-13-78	5/30/72
3+00	88.6	76.91	11.7									
					tap 3+27 6	tap 3+38 3	C34759	C49184	4530 IDA	4531 Laura	9-7-72	4-23-75
	84.9	77.00	7.9	3+45 2								
4+00	84.9	77.11	7.8									
					4+30.2	4+25 6	53878	C26545 C32428	4518 Ida	4519 R Laura	2-23-76	11-14-90 5-23-72
5+00	83.8	77.31	6.5									
					tap 5+73		C41784		4500 Ida		10-19-73	
6+00	84.1	77.51	7.2			TAP 5+78 4		C33890		4501 LAURA		7-26-72
	84.3	77.64	6.7	6+67	8" STUB N.							