M-181 A

MOBIL MANOR MOBIL HOME PARK
SANITARY SEWER
BUILT BY: MID-STATES CONST. CO.
BOOKED 15 FEB 73 FROM SS# 13 J.K.
PROJ. NO. AAKB502045

SCALE
1" = 150'

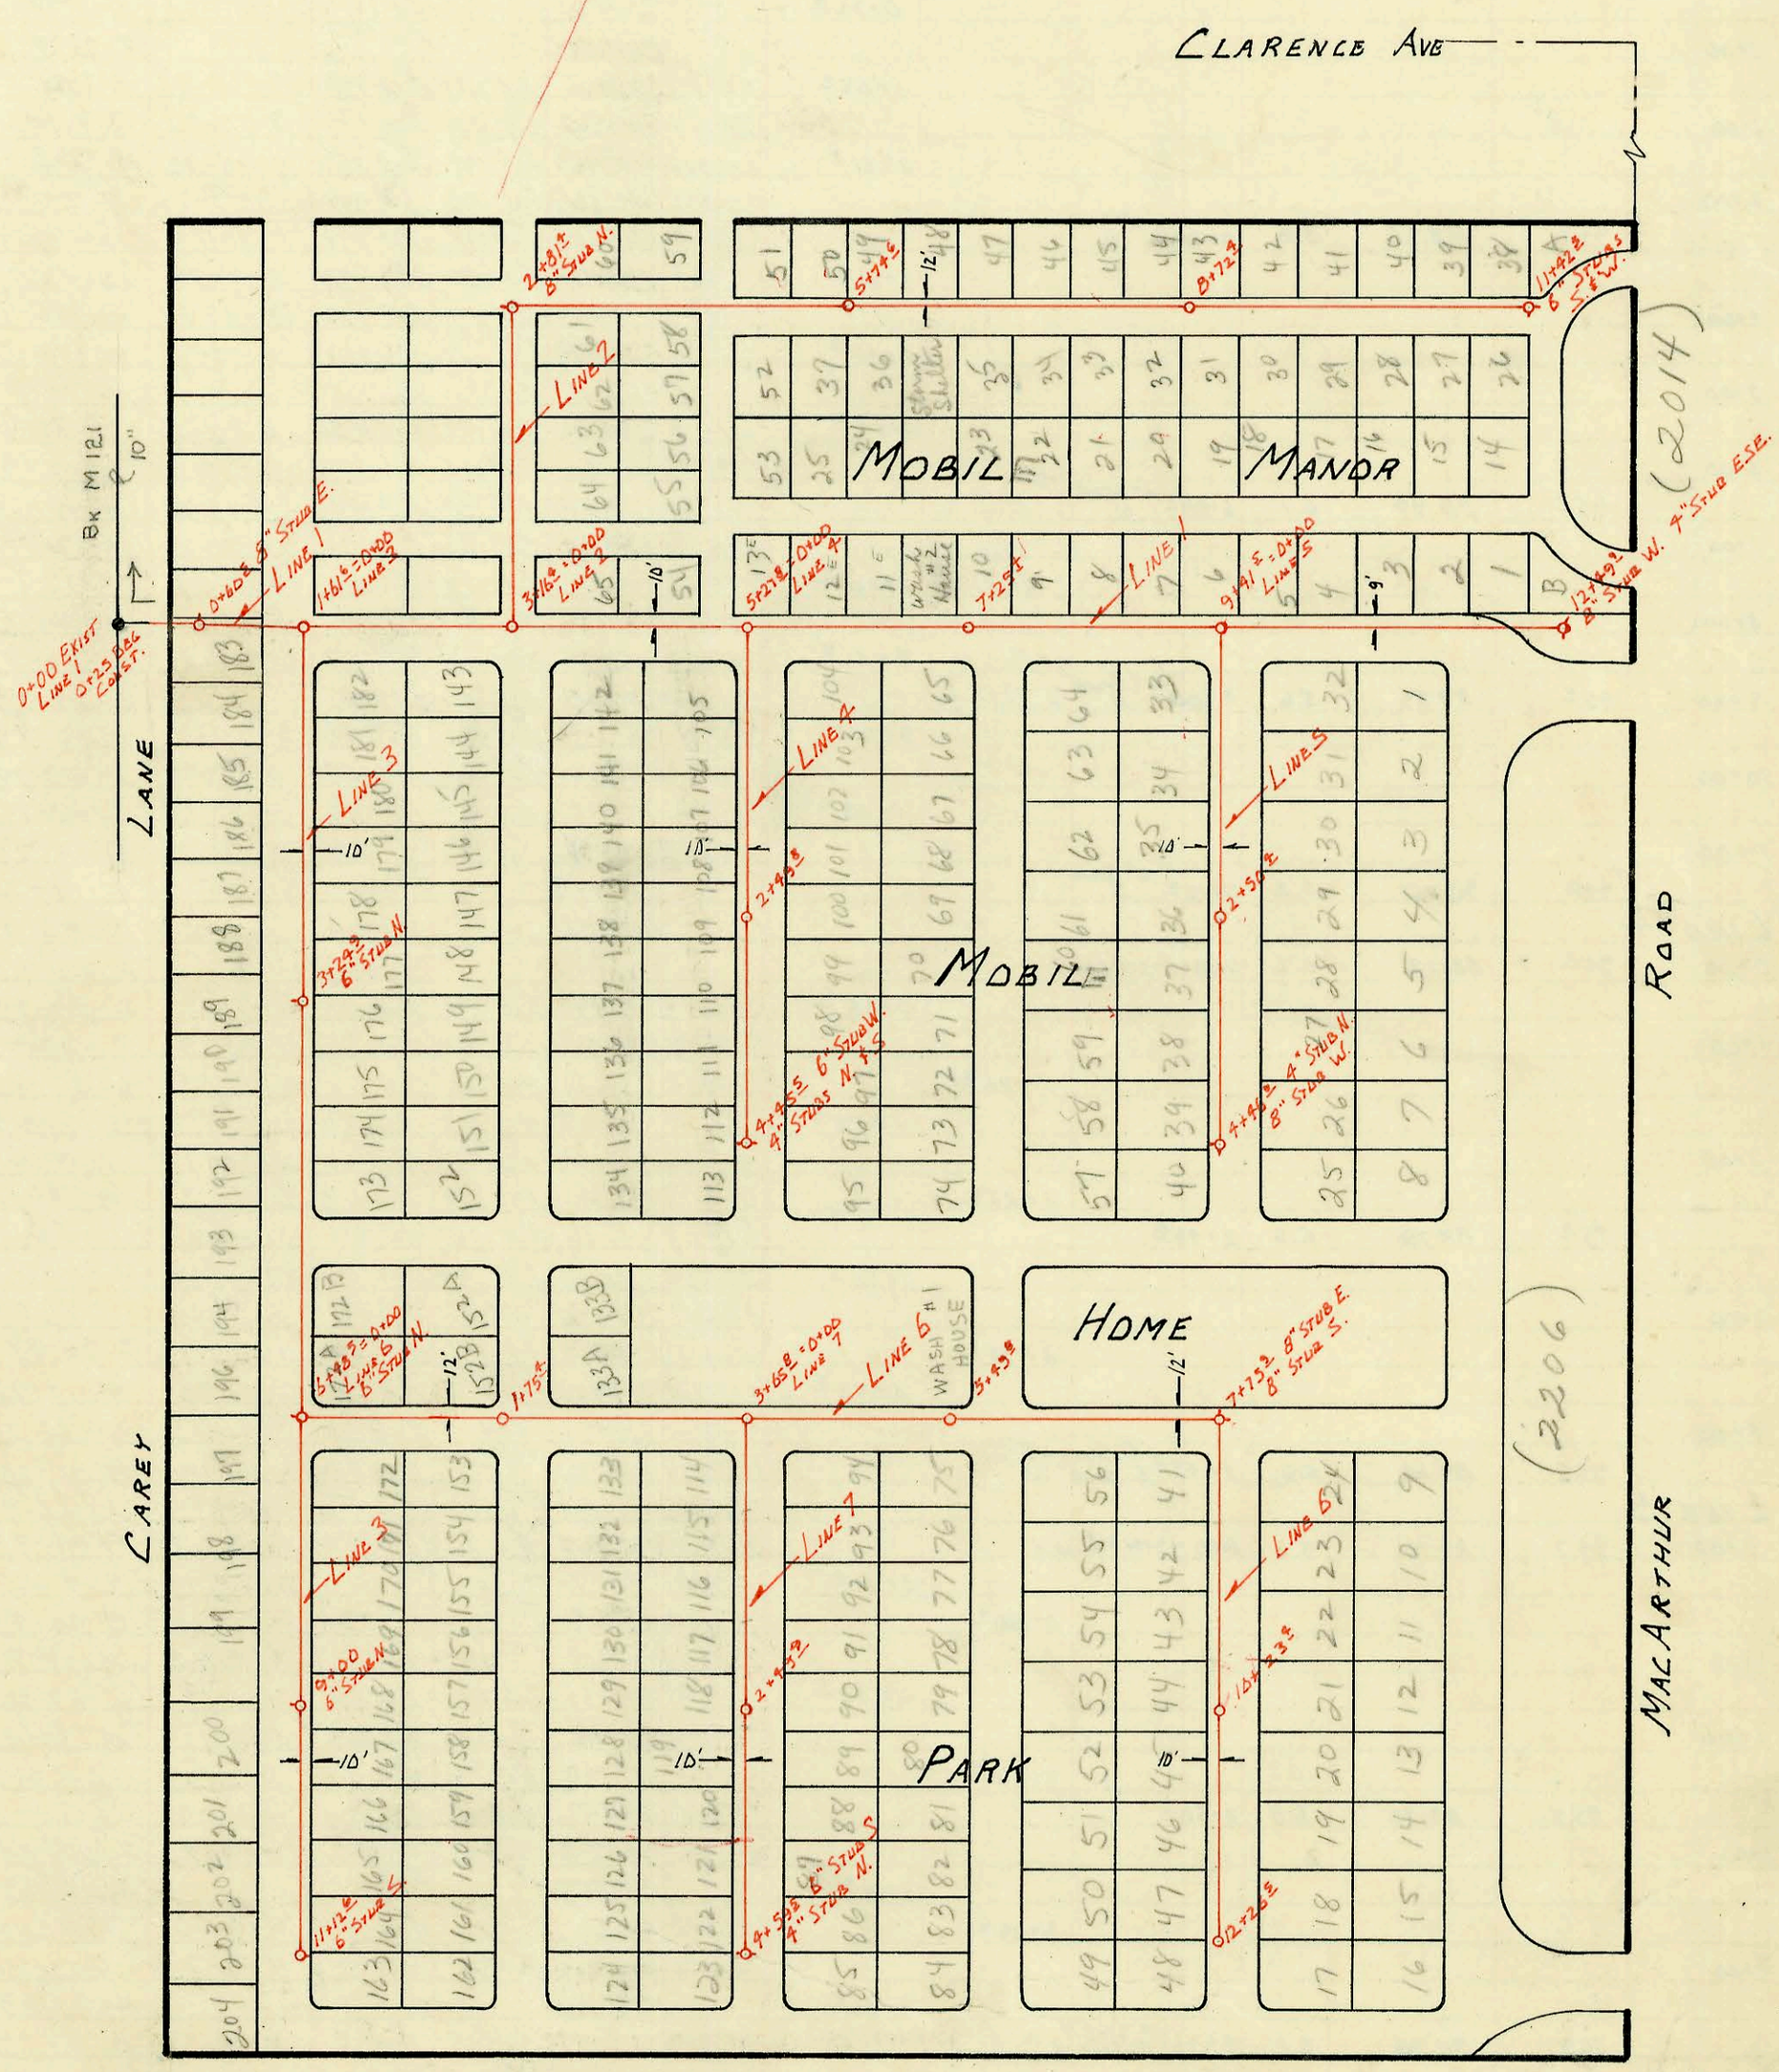

M-182

Form 42-020

CONSTRUCTION RECORD / SERVICE RECORD

STATION	ELEVATION Ground	ELEVATION Grade	Depth	MANHOLE	4-INCH "Y" BRANCHES North West	4-INCH "Y" BRANCHES South East	No. of Permit North West	No. of Permit South East	House Number North West	House Number South East	DATE OF PERMITS North West	DATE OF PERMITS South East
	94.5	89.70	4.8	8+72 4			C43105		Lot 31E		1-23-74	
9+00							C43104	C42695	Lot 30E	Lot 43E	1-23-74	12-12-73
						9+05 0	C43107	C42694	Lot 19E	Lot 42E	1-23-74	12-12-73
					9+06 5		C43106	C42693	Lot 18E	Lot 41E	1-23-74	12-12-73
					6" +97 0		C43855	C42692	Lot 16E	Lot 40E	3-7-74	12-12-73
						+99 0	C43856	C42691	Lot 17E	Lot 27E	3-7-74	12-12-73
10+00							C43857	C42690	Lot 28E	Lot 26E	3-7-74	12-12-73
11+00							C43858	C42689	Lot 29E	Lot 15E	3-7-74	12-12-73
						11+01 5		C42688		Lot 14E		12-12-73
					6" 11+06 0		C39746		Lot 38E.		6-27-73	
	94.4	90.76	3.6	11+42 5 6" STUBS S & W.			C41038		Lot 39E.		9-5-73	
LINE 3												
0+00	93.4	87.55	5.8	0+00 = 1+61 6 LINE 1				C49074		Lot 144		4-17-75
								C49072		Lot 182		4-17-75
						0+73 5		C49073		Lot 181		4-17-75
1+00								C43864		Lot 145		3-7-74
						1+65 0	C50371	C43865	Lot 189	Lot 146	7-17-75	3-7-74
2+00							C50372	C43866	Lot 190	Lot 179	7-17-75	3-7-74
						2+61 4	C50376	C43867	Lot 194	Lot 180	7-17-75	3-7-74
3+00							C50375	C43860	Lot 193	Lot 149A	7-17-75	3-7-74
	94 0	88.20	5.8	3+24 9 6" STUB N.			C43862	C42702	Lot 175	Lot 174	3-7-74	12-12-73
						3+56 5	C43861	C42703	Lot 150	Lot 123	3-7-74	12-12-73
4+00							C43863	C47205	Lot 176	Lot 152	3-7-74	12-12-73
						4+48 1	C49066	C42704	Lot 196	Lot 151	4-17-75	12-12-73
							49067		Lot 197		4-17-75	
5+00							49068	C42115	Lot 198	Lot 172	4-17-75	11-7-73
						5+64 5	49069	C42396	Lot 199	Lot 152A	4-17-75	11-26-73
6+00							C49070	C42116	Lot 195	Lot 152B	4-17-75	11-7-73
	95 0	88.94	6.1	6+48 5 6" STUB N.	MH Stub 6" Stub N.		C49065	C44070	Lot 154	Lot 195	4-17-75	4-17-75
7+00					6" Stub N.		C45126	C49064	Lot 204	Lot 171	12-18-74	4-17-75
					6" Stub N.	7+20 5	C45125	C49063	Lot 203	Lot 172	12-18-74	4-17-75
8+00					6" Stub N.		C45124	C42405	Lot 202	Lot 169	12-18-74	11-26-73
					6" Stub N.	8+21 5	C45123	C42404	Lot 201	Lot 156	12-18-74	11-26-73
9+00	95 0	89.35	5.6	9+00 6" STUB N.	6" Stub N.		C45122	C42406	Lot 200	Lot 170	12-18-74	11-26-73
						9+17 0	C43848	C43113	Lot 165	Lot 158	3-7-74	1-23-74
10+00							C43849	C43112	Lot 166	Lot 157	3-7-74	1-23-74
						10+09 0	C43850	C43111	Lot 159	Lot 168	3-7-74	1-23-74
11+00							C43851	C38916	Lot 160	Lot 163	3-7-74	5-10-73
	95 0	90.20	4.8	11+12 0 6" STUB S.				C38917		Lot 164		5-10-73
LINE 4								C43110		Lot 167		1-23-74
0+00	94 2	88.28	6.2	0+00 = 5+27 8 LINE 1				C39736		Lot 103		6-27-73
						0+68 0	C38143	C39737	Lot 141	Lot 104	3/21/73	6-27-73
1+00							C38144	C39738	Lot 140	Lot 65	3/21/73	6-27-73
					1+26 5		C38146	C39739	Lot 106	Lot 66	4/9/73	6-27-73
						1+72 0	C38149	C42107	Lot 107	Lot 67	4/9/73	11-7-73
2+00							37436	C42108	Lot 108	Lot 68	2/26/73	11-7-73
					2+23 8		C38437	C42412	Lot 109	Lot 69	2/26/73	11-26-73
	95 3	88.78	6.5	2+49 8			37438	C42411	Lot 138	Lot 70	2/26/73	11-26-73
						2+56 9	37439	C41649	Lot 139	Lot 136	2/26/73	10-11-73
3+00							C41647	C41650	Lot 111	Lot 137	10-11-73	10-11-73
					3+38 5		C41648	C38899	Lot 110	Lot 97	10-11-73	5-10-73
						3+49 5	*C37829	C38900	Lot 113	Lot 98	3/21/73	5-10-73
4+00							*C37830	C38901	Lot 134	Lot 71	3/21/73	5-10-73
	95.5	89.64	5.9	4+45 5 4" STUBS N & S 8" STUB W.			*C37837	C38902	Lot 135	Lot 72	3/21/73	5-10-73
LINE 5							*C37828	C43108	Lot 112	Lot 1	3/21/73	1-23-74
0+00	94.2	89.10	5.1	0+00 = 9+41 5 LINE 1			C43109	C38147	Lot 2	Lot 59	1-23-74	4-9-73
						0+74 0	C37441	C38150	Lot 34	Lot 60	2/26/73	4-9-73
					0+80 4		C37440	38919	Lot 33	Lot 32	2/26/73	5-10-73
1+00							C38152	38918	Lot 63	Lot 31	4/9/73	5-10-73
						1+92 3	C38151	39747	Lot 64	Lot 30	4/9/73	6-27-73
2+00							C39744	38922	Lot 35	Lot 29	6/27/73	5-10-73
					2+12 4		39745	39740	Lot 36	Lot 3	6/27/73	6-27-73
	95.5	89.50	6.0	2+50 4			C42217	39741	Lot 62	Lot 4	11-7-73	6-27-73
3+00							C42218	37500	Lot 61	Lot 28	11-7-73	2/28/73
						3+18 4	"	C37497		Lot 27		2/28/73
					3+24 6		C38138	C43114	Lot 38	Lot 5	4-9-73	1-23-74
4+00							C38145	C42415	Lot 37	Lot 57	4-9-73	11-26-73
						4+36 0		C42122		Lot 7		11-7-73
	95.5	90.38	5.1	4+46 0 4" STUB N. 8" STUB W.	4" Stub N.	4" Stub N	C42413	C42121	Lot 39	Lot 8	11-26-73	11-7-73
					"		C42414	C42120	Lot 40	Lot 25	11-26-73	11-7-73
							C42706	C42119	Lot 58	Lot 26	12-12-73	11-7-73

CONTINUED PAGE 183

*C41048-51-2206 N. MacArthur - B.A. Rockenbach - 9-5-73 - used stub in MH 4+95 (Lots 95, 96, 73, 74)

C42409 - Lot 99 - Wye 2+56.9 - 11-26-73
C42410 - Lot 100 - " " "
C42109 - Lot 101 - " 1+72.5 11-7-73
C42110 - Lot 102 " " "
C43115 - Lot 6 - " 3+18.4 1-23-74

C50373 - Lot 191 - Wye 3+24 - 7-17-75
C50374 - Lot 192 - " "
C50375 - Lot 193 - " "
C50376 - Lot 194 - " "
C50705 - Lot 179 - Wye 1+65 8-6-75 Line 3

182A