M-202A

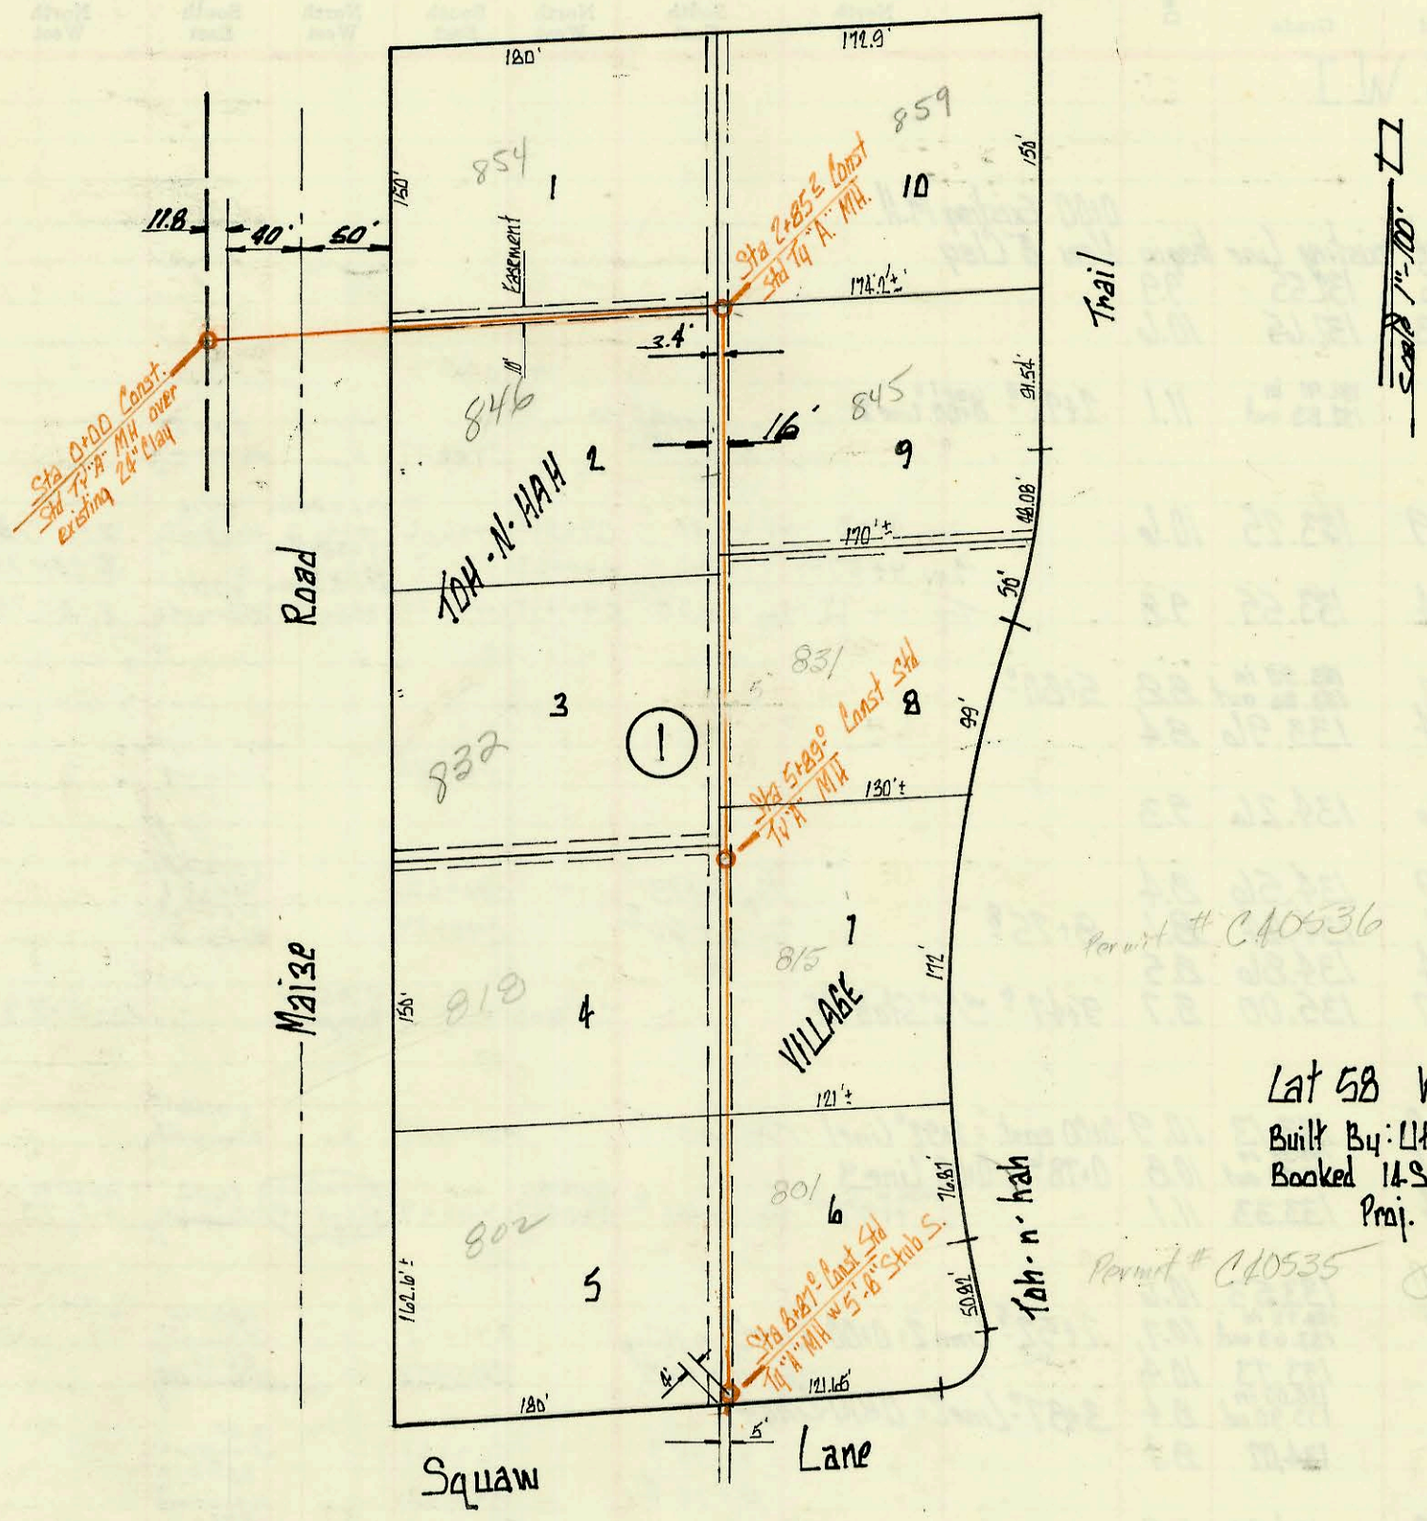

Permit # C40536

Permit # C40535

Lat 58 Westlink Interceptor
Built By: Utility Contractors Inc.
Booked 14 Sept 73 from K-106
Proj. No. DBKL 573028

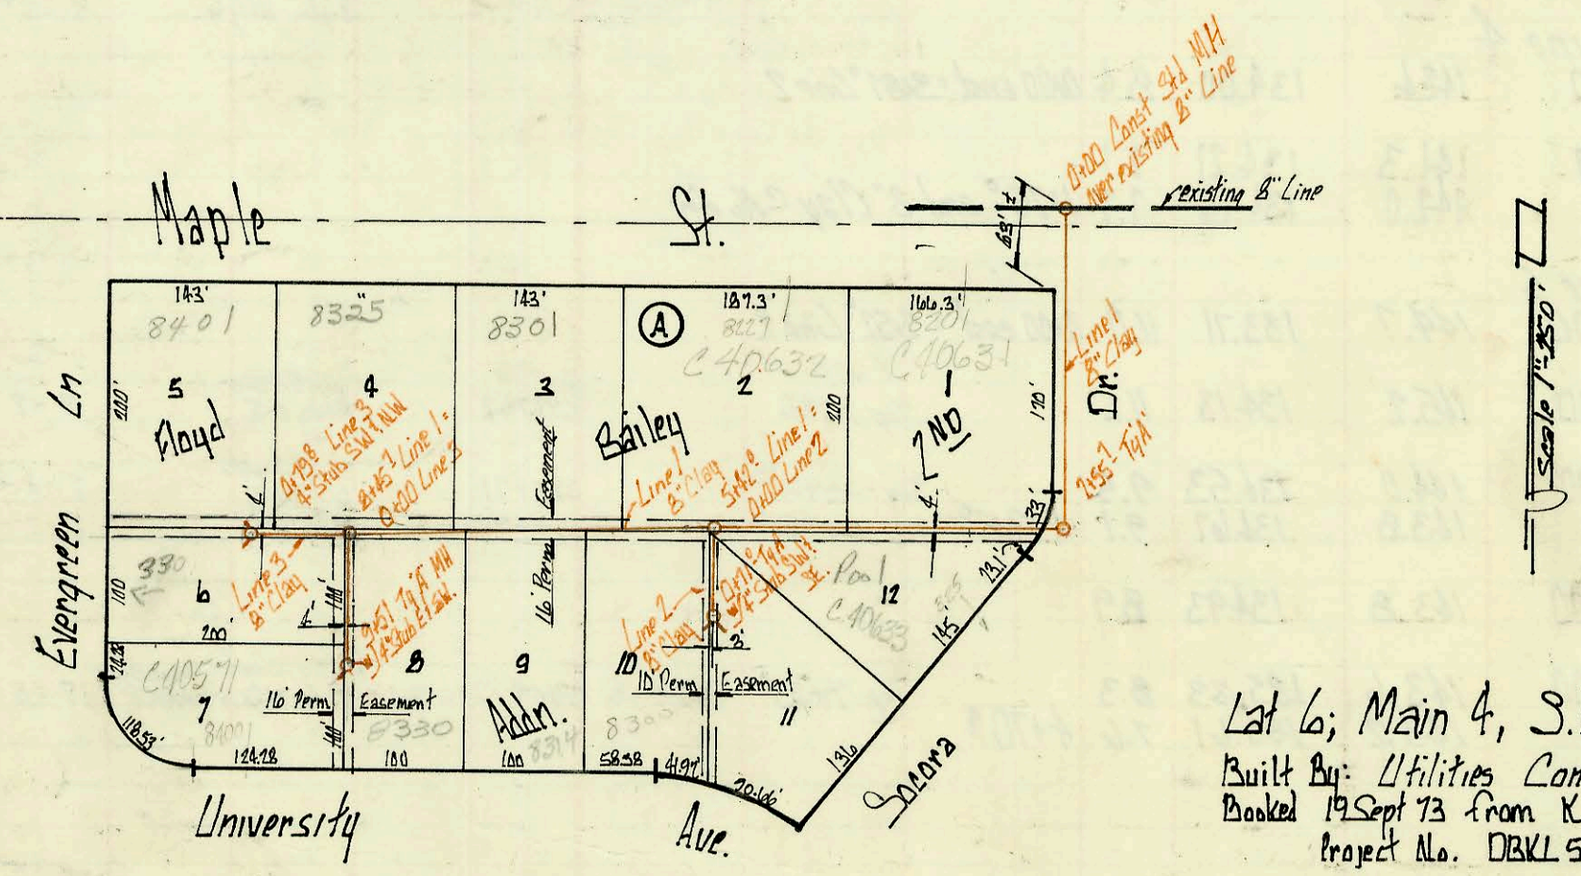

Lat 6; Main 4, S.W. Int.
Built By: Utilities Contractors
Booked 19 Sept 73 from K-105
Project No. DBKL 571036

M-202

Form 42-020

CONSTRUCTION RECORD							SERVICE RECORD					
STATION	ELEVATION		Depth	MANHOLE	4-INCH "Y" BRANCHES		No. of Permit		House Number		DATE OF PERMITS	
	Ground	Grade			North West	South East	North West	South East	North West	South East	North West	South East
Lat 5B	Westlink Interceptor											
0+00	141.8	134.30	7.5	Const. New MH over exist. line								
1+00	149.1	138.80	10.3									
					Top 1+93.1		C53388		854 N. Maige Rd		1-27-76	
2+00	155.0	143.30	11.7									
	158.9	141.11 out 141.33 in	11.7	2+85 2 4" Stub N.E.		4" Stub NE		C46128		859 Joh-N-Hah		8/8/74
3+00												
					Top 3+75 5	Top 3+59 5	C48999	C48920	846 N. Maige Rd.	845 Joh-N-Hah	4-14-75	4-8-75
4+00	159.7	147.88	11.8									
5+00	160.9	148.38	12.5		Top 5+18	Top 4+69 5	C48190	C43439	832 Maige Rd.	831 Joh-N-Hah	1-27-75	2-12-74
	161.2	148.83	12.4	5+89 0								
6+00	161.3	148.88	12.4		Top 6+79 0	Top 6+74 9	C43441	C40536	818 Maige Rd	815 Joh-N-Hah	2-12-74	8-10-73
7+00	161.1	149.38	11.7		Top 7+87 0	Top 7+99 5	C43440	C40535	802 Maige Rd	801 Joh-N-Hah	2-12-74	8-10-73
8+00	161.0	149.88	11.1									
	161.0	150.32	10.7	8+87 0 w/5'-8" Stub S.								
Lat 6. Main 4. S.W.I. Line 1												
0+00	140.8	132.60	8.2	Const. New MH over existing line								
1+00	139.7	132.80	6.9									
2+00	139.5	133.00	6.5			Top 3+30 7		C40633		325 S. Socora		8-15-73
	139.3	133.10	6.2	2+55 7								
3+00	138.9	133.30	5.6			Top 3+72 0	C40631			8201 Maple		8-15-73
4+00	139.5	133.50	6.0			Top 4+77 7		C40632		8227 Maple		8-15-73
5+00	139.7	133.70	6.0									
	140.1	133.79	6.3	5+42 = 0+00 Line 2								
6+00	140.4	133.90	6.5			Top 6+72 8		C40827		8314 University		8-22-73
					Top 6+25 9		C44766		8301 Maple		5-7-74	
7+00	140.2	134.10	6.1									
					Top 7+66 2		C42531		8325 Maple		11-30-73	
8+00	138.9	134.30	4.6									
	138.9	134.39	4.5	8+45 7 = 0+00 Line 3								
9+00	138.9	134.60	4.3									
	139.5	134.70	4.8	9+51 0 w/4" Stubs E & S.W				C41763		8330 University		10-18-73
					Top 9+45 0		C40571		8400 University		8-13-73	
Line 2 0+00	140.1	133.88	6.2									
	139.5	134.18	5.3	0+71 0 w/4" Stub S.W. & S.E.			26380 C41020	C41021	8300 B W. University	339 S. Socora	10-24-90 9-4-73	9-4-73
Line 3 0+00	138.9	134.50	4.4									
							C42531		8325 W Maple		11-30-73	
	139.7	134.82	4.9	0+79 8 w/4" Stub S.W. & N.W.			C60821	C70213	8401 Maple	330 EVERGREEN	4-22-77	2-2-79