M-236 A

PRIVATE SANITARY SEWER FOR WICHITA STATE UNIVERSITY

BUILT BY UTILITY CONTRACTORS

BOOKED FROM PLAN

7-2-74 On map DBKW704002

SCALE 1"=100'

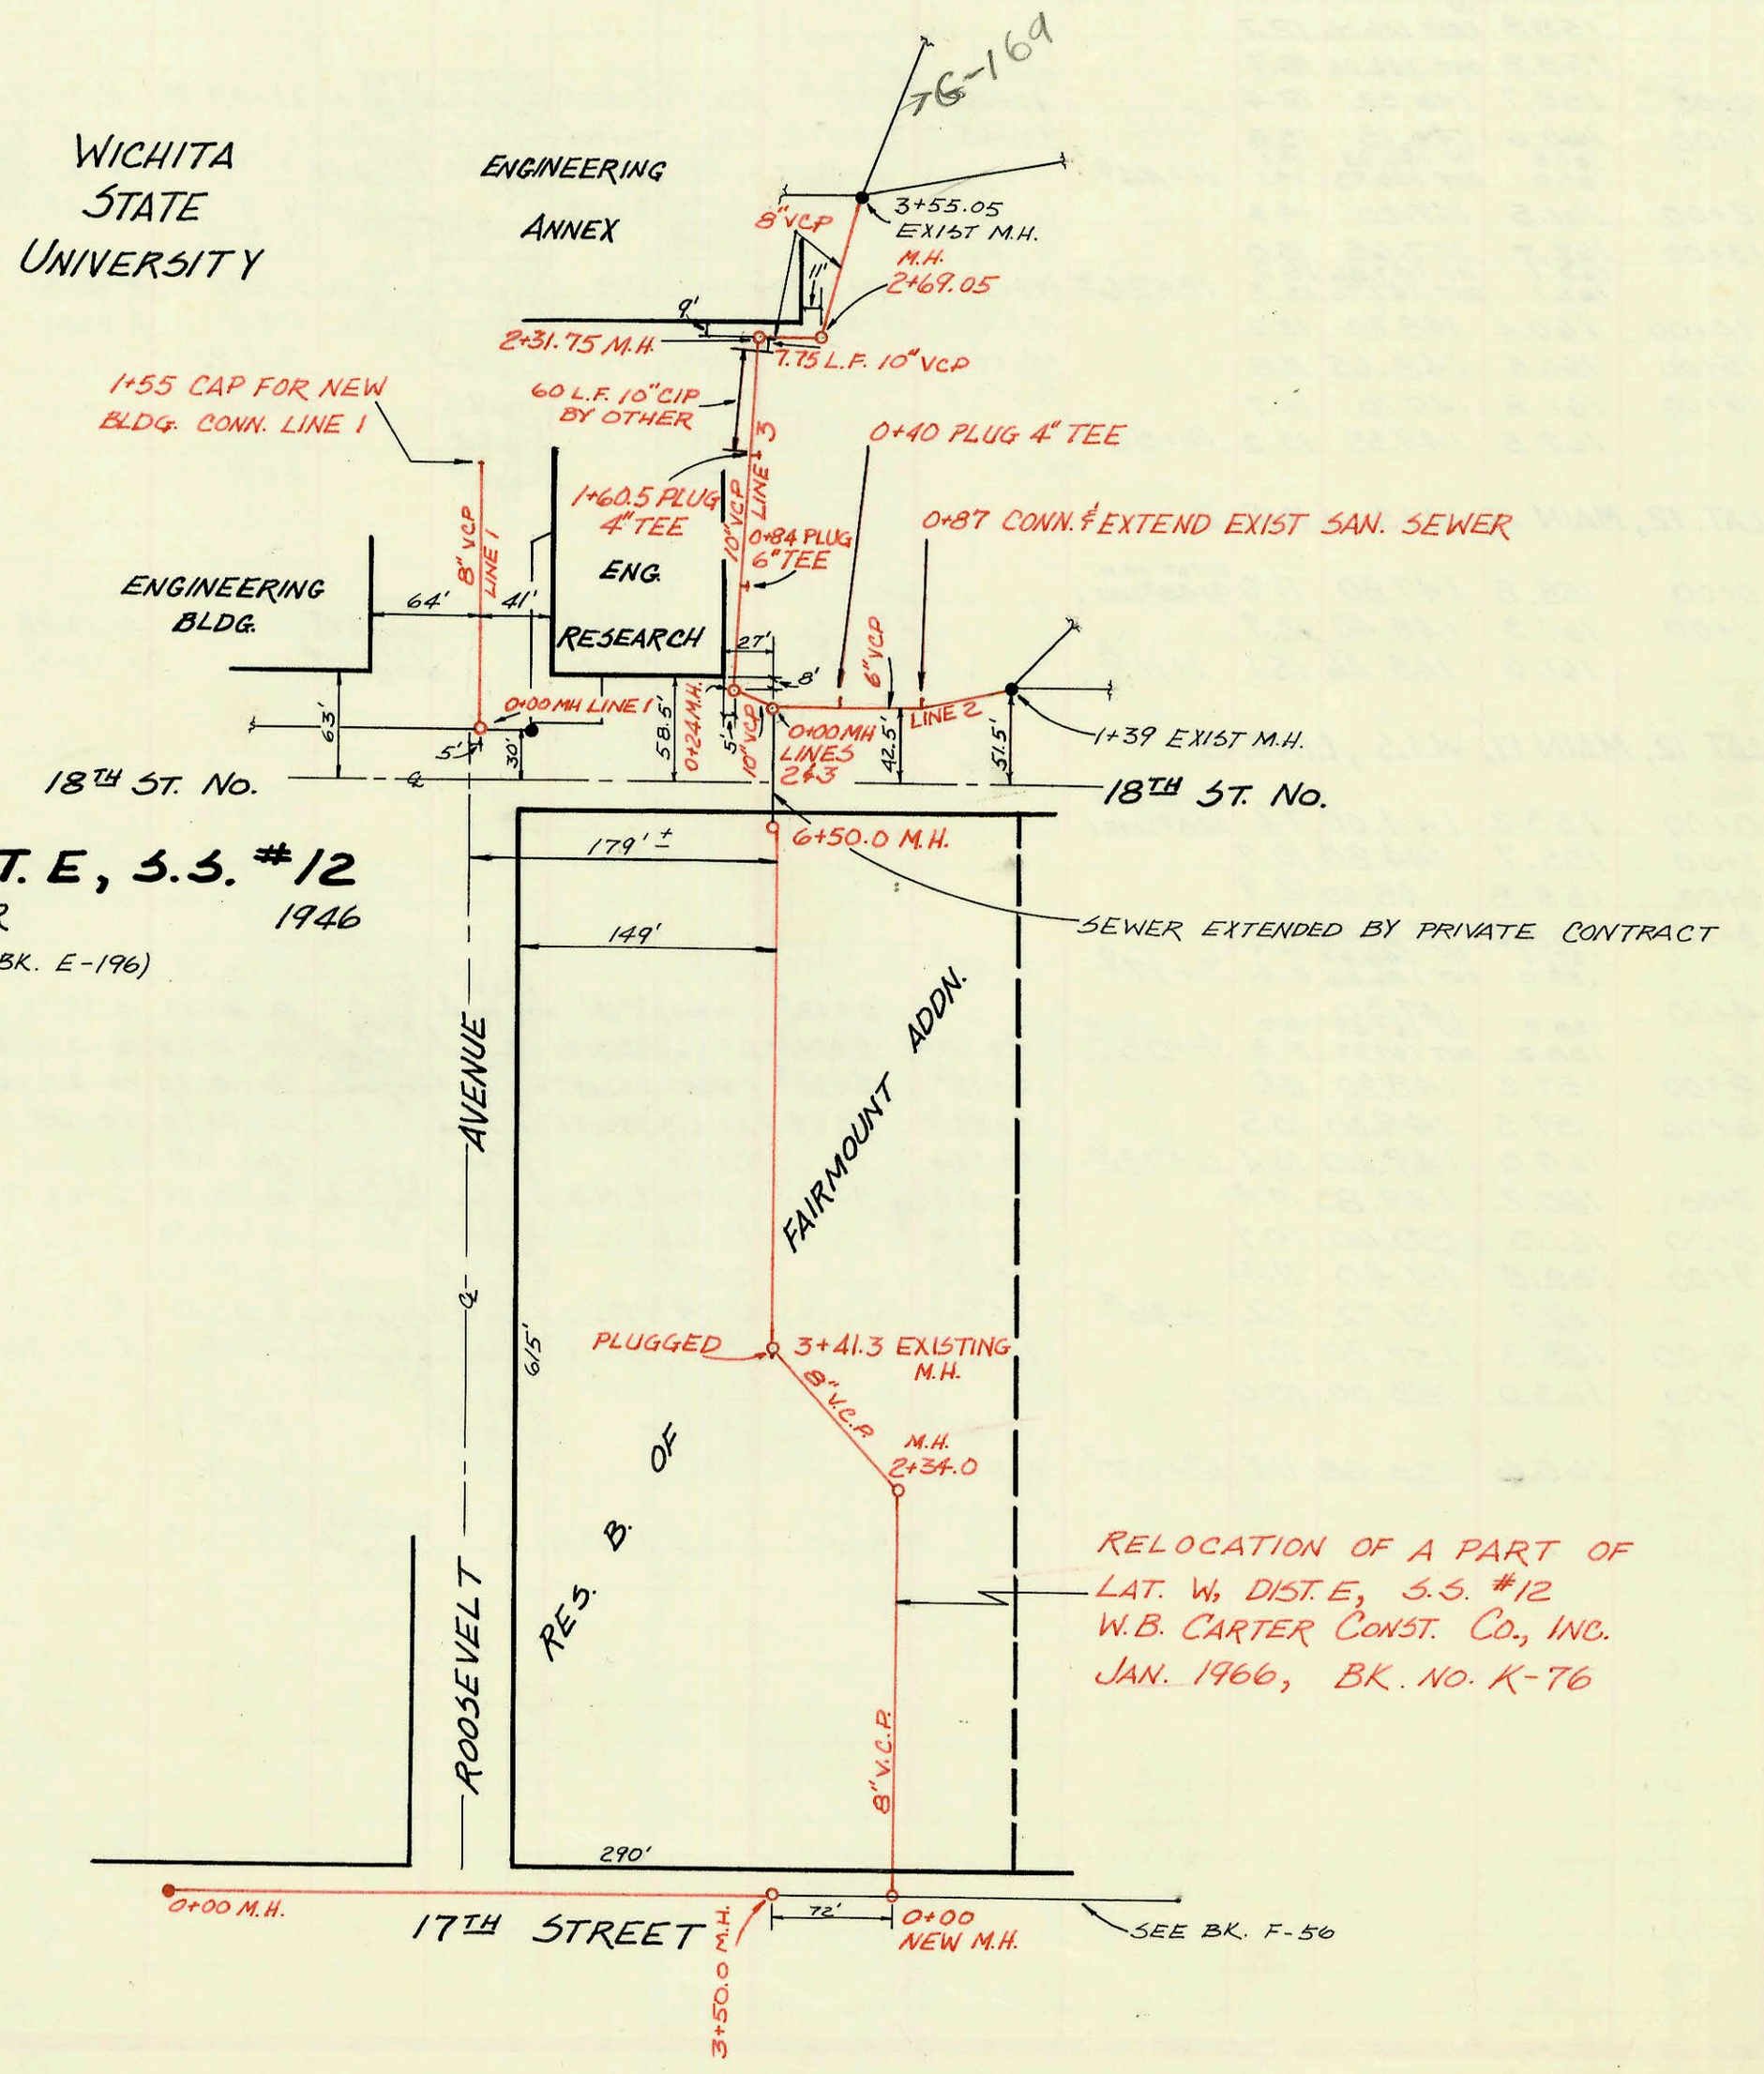

M-236

Form 42-020

CONSTRUCTION RECORD							SERVICE RECORD					
STATION	ELEVATION		Depth	MANHOLE	4-INCH "Y" BRANCHES		No. of Permit		House Number		DATE OF PERMITS	
	Ground	Grade			North West	South East	North West	South East	North West	South East	North West	South East
PRIVATE SANITARY SEWER FOR WICHITA STATE UNIVERSITY												
LINE 1												
0+00	213.0	206.75	6.3	0+00								
1+00		209.49										
END LINE 1+55		211.00										
LINE 2												
0+00	215.4	205.94	9.5	0+00								
1+00	216.6	207.77	8.8									
	217.2	208.49	8.7	EXIST. 1+39								
LINE 3												
0+00	215.4	205.94	9.5	0+00								
	216.6	206.03	10.6	0+24								
1+00	216.7	206.12	10.6									
2+00	216.9	206.32	10.6									
	217.0	206.37	10.6	2+31.75								
	217.2	206.37	10.8	2+69.05								
3+00	217.2	206.37	10.8									
	217.0	206.37	10.6	EXIST. 3+55.05								