



WICHITA STATE UNIV PVT S.S.
 BUILT BY: PRIVATE
 PROJ. N^o AAKB 502033
 BOOKED 3-18-75 FROM PLAN

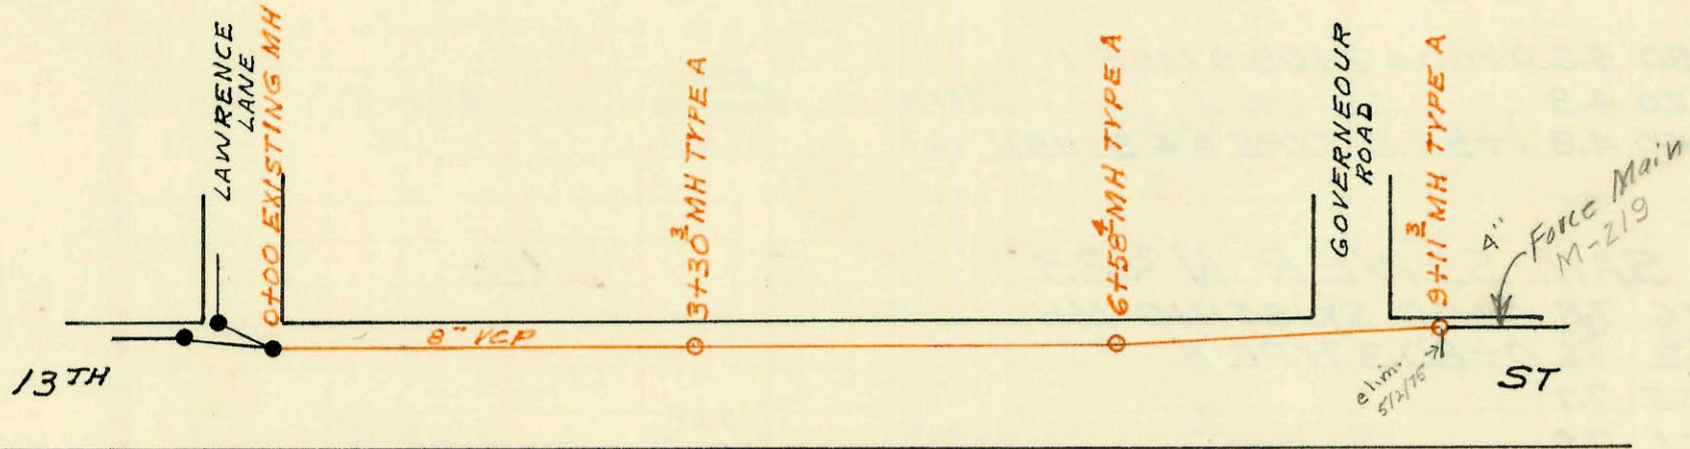

LEISURE LIVING VENTURES 1ST ADDN
 SANITARY SEWER
 BUILT BY: UTILITY CONT. INC.
 PROJ. N^o DBKW 704044
 BOOKED 3-19-75 FROM IH 75

SCALE 1"=150'

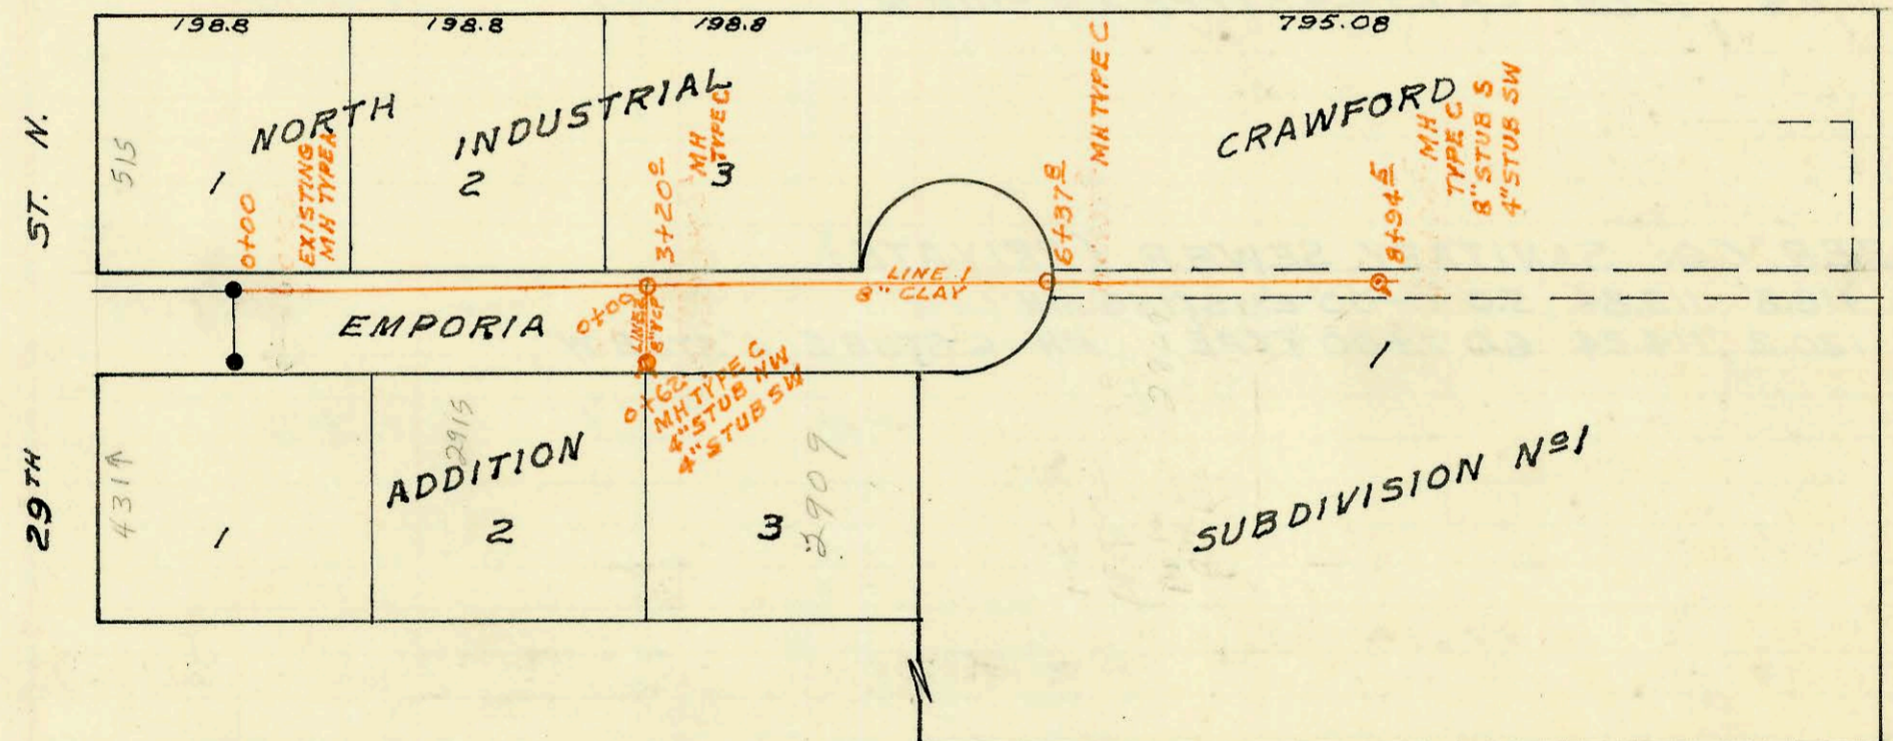

LATERAL 84 MAIN 4 S.S. N^o 23
 BUILT BY: MID STATES CONST CO INC
 PROJ. N^o DBKL 574096
 BOOKED 3-25-75 FROM IH 84

SCALE 1"=150'

on map

