


LATERAL 7, MAIN 1, COWSKIN INTERCEPTOR SEWER
 PROJ. NO. 468-82102 (740761)
 BUILT BY UTILITY CONTRACTORS, INC.
 BOOKED 3-2-92 PER PLAN

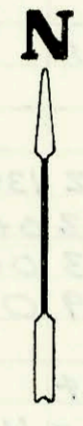

SCALE: 1" = 100'

N-18

CONSTRUCTION RECORD						SERVICE RECORD						
STATION	ELEVATION		Depth	MANHOLE	4-INCH "Y" BRANCHES		No. of Permit		House Number		DATE OF PERMITS	
	Ground	Grade			North West	South East	North West	South East	North West	South East	North West	South East
LATERAL LINE 1	L 7, MAIN 1, COWSKIN INTERCEPTOR SEWER											
0+00	137.00	120.80 OUT 121.10 IN	16.2	0+00								
1+00	132.70	121.50	11.2									
	134.30	121.89	12.4	0+00-Line 2 7+97.58								
2+00	134.30	121.90	12.4									
3+00	136.20	122.30	13.9									
					3+20-4" Riser E - 128.50		92-6861-7		313 S. Firefly ct		5-11-92	
4+00	138.00	122.70	15.3	Line 3-0+00 4+95.56								
	140.00	123.08	16.9									
5+00	140.00	123.09	16.9		5+60 5+60-4" Riser E - 132.50		#1880		337 Firefly ct		7-22-92	
6+00	141.10	123.50	17.6		4" SDR 35 6+70-4" Riser E - 134.00		202-89-3 #1881		341 Firefly ct		2-5-92 1-22-92	
7+00	142.30	123.90	18.4									
	143.50	124.29	19.2	0+00-Line 4 7+99.55								
8+00	143.50	124.29	19.2									
					8+70-4" Riser E - 135.00		92-4328-7		413 S. Firefly ct		3-30-92	
9+00	143.10	124.70	18.4									
					9+80-4" Riser E - 135.00		92-3527-7		417 S. Firefly ct		3-12-92	
10+00	143.00	125.10	17.9									
11+00	142.80	125.50	17.3									
	143.00	125.51	17.5	0+00-Line 5 11+03.54								
12+00	141.90	125.90	16.0									
					12+30-4" Riser E - 133.50		92-6113-7		457 Firefly ct		4-28-92	
13+00	140.70	126.30	14.4									
14+00	139.80	126.70	13.1									
	139.80	126.75 OUT 126.83 IN	13.1	14+07.52	14+70-4" Riser N - 131.50	14+60-4" Riser S - 131.50	92-24837-7	92-23887-7	461 Firefly ct	12726 w. Taff	8-27-92	9-8-93
15+00	139.40	127.20	12.2		4" SDR 35 15+46.5 tap	15+40-4" Riser S - 131.00	92-24826-7		465 Firefly ct		8-27-92	
					15+50-4" Riser N - 131.00							
16+00	139.00	127.60	11.4		4" SDR 35 15+91.53 tap		93-19527-7		12722 w. Taff		7-19-93	
	138.40	127.69	10.7	16+24.53	4" Stub N	4" Stub S	92-45678-7	93-19526-7	469 S. Firefly ct	12718 w. Taff	12-23-92	7-19-93
17+00	138.00	128.00	10.0		4" SDR 35 16+01.53 tap	4" SDR 35 17+71.53 tap	92-45679-7	93-8703-7	473 Firefly ct	12714 w. Taff	3-24-93	4-19-93
					4" SDR 35 17+62.53 tap	4" SDR 35 17+93.53 tap	92-45677-7	93-8705-7	477 S. Firefly ct	12710 w. Taff	12-23-92	4-19-93
18+00	136.80	128.40	8.4		4" SDR 35 18+56.5 tap	4" PVC LI 18+50.03	92-12770-7		12706 w. Taff		5-24-93	
	136.10	128.70	7.4	18+75.53	4" Stub SE		92-23826-7	96-17897-7	481 S. Firefly ct	12702 w. Taff	9-25-92	10-16-96
LATERAL LINE 2	0+00	134.30	12.4	0+00	0+30-4" Riser S - 126.00		92-9267-7		309 S. Firefly ct		6-23-92	
					4" SDR 35 1+55.49 tap		92-8897-7		305 S. Firefly ct		6-12-92	
1+00	134.00	122.39	11.6									
	134.30	122.74	11.6	1+88.49								
2+00	134.00	122.79	11.2									
									301 S. Firefly ct		9-4-92	
3+00	133.10	123.19	9.9									
4+00	133.70	123.59	10.1									
	133.60	123.81 OUT 123.91 IN	9.8	4+54.17								
5+00	133.40	124.09	9.3		4" SDR 35 5+01.1 tap		92-12966-7		302 S. Firefly ct		7-10-92	
6+00	133.40	124.49	8.9		4" SDR 35 5+74.1 tap		92-16212-7		306 S. Firefly ct		7-23-92	
					4" SDR 35 6+37.92 tap		92-1801-7		310 S. Firefly ct		1-26-93	
7+00	133.40	124.89	8.5		4" SDR 35 7+12.9 tap		92-33023-7		314 S. Firefly ct		9-25-92	
	133.60	125.00	8.6	7+28.92	4" SDR 35 7+80.92 tap		92-8256-7		318 S. Firefly ct		6-4-92	
8+00	134.00	125.29	8.7									
9+00	135.00	125.69	9.3		4" SDR 35 9+45.52 tap		92-24843-7		322 S. Firefly ct		8-27-92	
	135.20	125.80 OUT 125.90 IN	9.4	9+27.52	4" SDR 35 9+510.3 tap		92-6115-7		326 Firefly ct		5-5-92	
10+00	134.90	126.19	8.7		4" SDR 35 10+18.5 tap		92-4762-7		330 Firefly ct		4-28-92	
					4" SDR 35 10+87.5 tap		92-3573-7		334 Firefly ct		4-3-92	
11+00	135.60	126.59	9.0									
					4" SDR 35 11+510.55 tap		92-8892-7		406 Firefly ct		6-12-92	
12+00	133.60	126.99	6.6		4" SDR 35 12+22.05 tap		92-10299-7		410 Firefly ct		6-29-92	
	133.60	127.14	6.5	12+35.55	4" SDR 35 12+71.5 tap		92-4761-7		414 Firefly ct		4-6-92	
13+00	133.30	127.39	5.9		4" SDR 35 13+30.5 tap		92-6437-7		418 S. Firefly ct		5-5-92	
									422 Firefly ct		7-31-92	
14+00	133.30	127.79	5.5		4" SDR 35 14+41.7 tap		92-24845-7		426 S. Firefly ct		8-27-92	
15+00	133.30	128.19	5.1		4" SDR 35 15+41.4 tap		92-23031-7		430 S. Firefly ct		9-7-93	
					4" SDR 35 15+93.7 tap		92-22879-7		434 S. Firefly ct		8-24-93	

Form #192-020 (July, 1981)

93-19526-7 - 12718 w Taff - 7/14/93 - NC - Tap 44 w of M.H. (16+6853);
1-22 v; PVC scribe; 4" PVC - did not use M.H. Stub that was available