


LATERAL 21, MAIN 15, S.W.I.  
PROJ. NO. 468-82098 (740720)  
BUILT BY UTILITY CONTRACTORS INC.  
BOOKED 4-2-92 PER PLAN

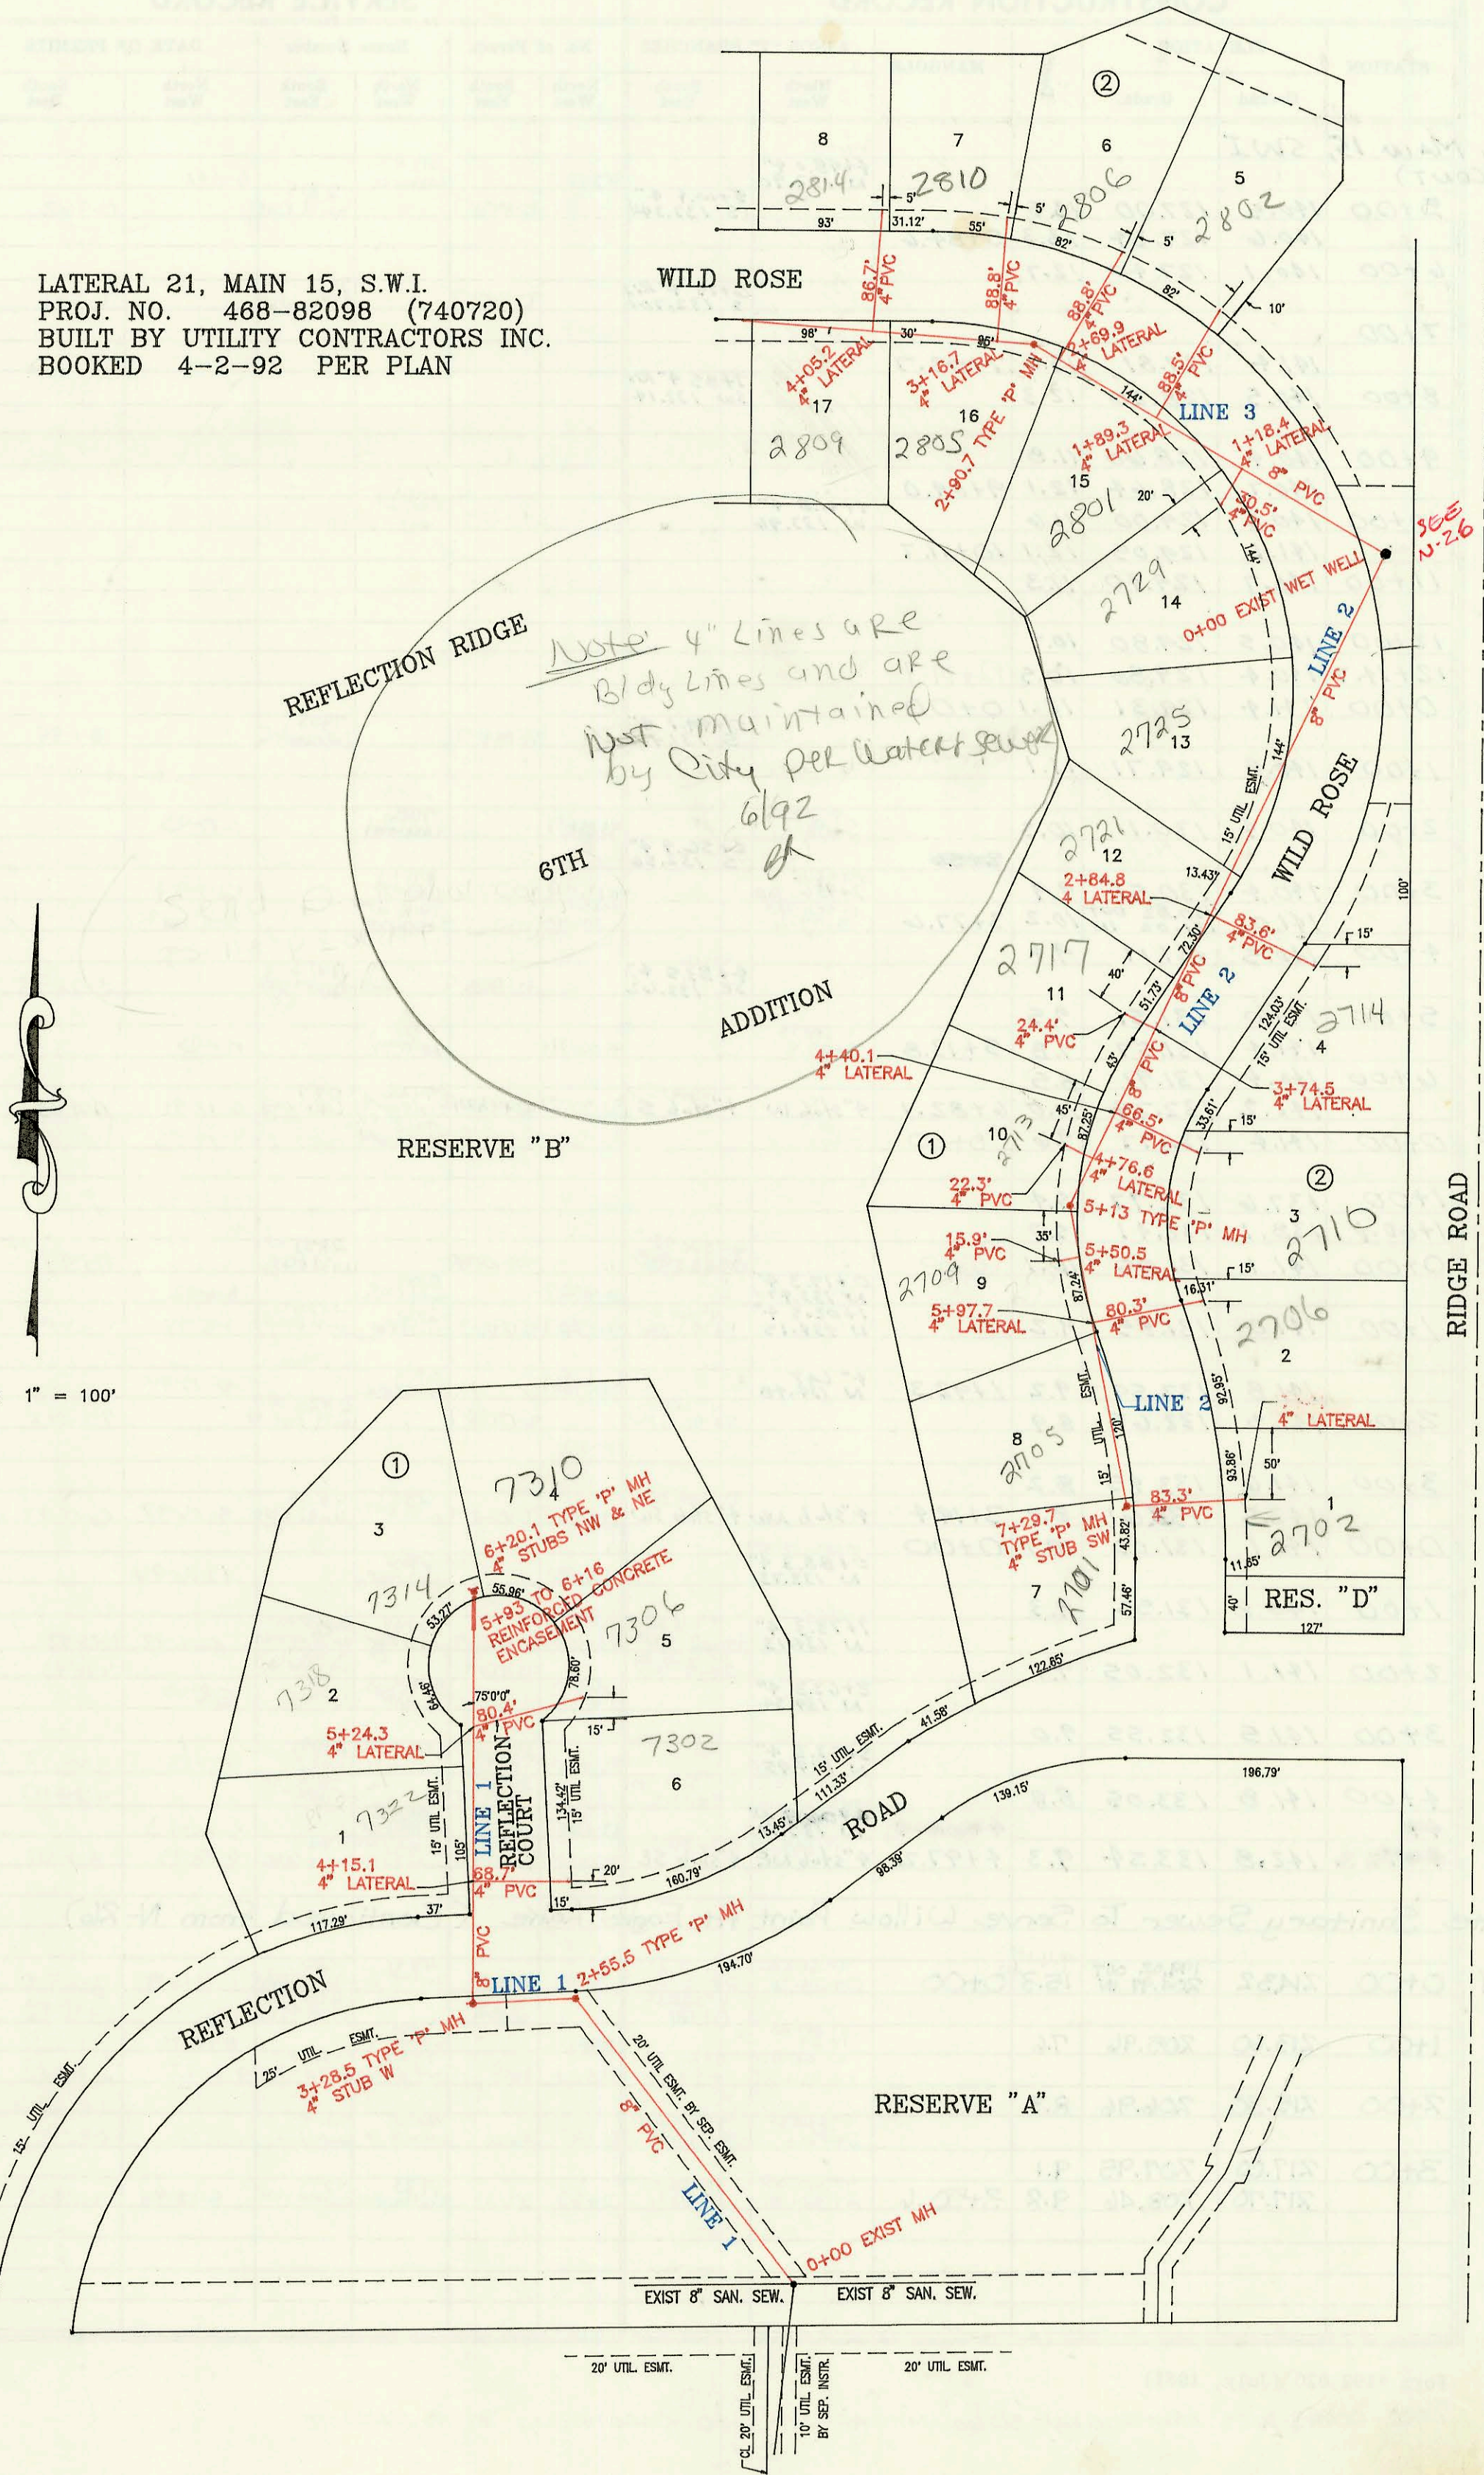

SCALE: 1" = 100'

CONSTRUCTION RECORD						SERVICE RECORD						
STATION	ELEVATION		Depth	MANHOLE	4-INCH "Y" BRANCHES		No. of Permit		House Number		DATE OF PERMITS	
	Ground	Grade			North West	South East	North West	South East	North West	South East	North West	South East
LAT 21, MAIN 15, SW I												
LINE 1	0+00	137.16	132.43	4.7	0+00							
	1+00	137.0	132.73	4.3								
	2+00	136.6	133.03	3.3								
		139.7	133.20 OUT 133.30 IN	6.5	2+55.5							
	3+00	139.4	133.43	6.0								
		139.9	133.52 OUT 133.62 IN	6.4	3+28.5	4" stub W						
	4+00	140.3	133.83	6.5								
						4" SDR 35 11+44.5 4" PVC 40 5+23.5	4+15.1 4" E 135.29	96-13883-7	94-955-7	11372 Reflection 7318 Reflection ct	7302 W Reflection ct	8-13-96 1-5-94
	5+00	140.2	134.13	6.1			5+24.3 4" E 135.74	94-905-7	94-19-7	7318 Reflection ct	7306 Reflection ct	1-14-94 1-3-94
	6+00	140.5	134.43	6.1								
LINE 2	0+00	141.1	134.49	6.6	6+20.1	4" SDR Below 4" stub NW	4" PVC 40 4" stub NE	92-24806-7	93-8760-7	7314 W Reflection ct	7310 Reflection ct	8-27-92 4-21-93
	1+00	139.1	129.40	9.7								
						4" SDR 35 1+64.0 top		72-11044-7		2725 Wild Rose		7-7-92
	2+00	140.5	129.80	10.7								
						4" SDR 35 2+57 top	4" SCH 40 2+84.8 4" E 132.53	93-13333-7	92-02724-7	2721 W Wild Rose	2717 W Wild Rose	5-26-93 10-3-92
	3+00	140.5	130.20	10.3								
						3+74.5 4" W 131.71	4+40.1 4" E 132.81	92-12983-7	96-10207-7	2717 Wild Rose	2710 N Wild Rose	7-10-92 6-27-96
	4+00	140.0	130.60	9.4		4+76.6 4" W 132.08		93-24606-7		2715 Wild Rose		9-14-93
	5+00	140.5	131.00	9.5								
		141.1	131.05	10.1	5+13.0							
						5+50.5 4" W 132.24	4" Lead line D 92-24806-7 5+97.7 4" E 130.50	93-24806-7	93-4377-7	2704 Wild Rose	2706 Wild Rose	2-23-93 3-8-93
	6+00	141.0	131.40	9.6		4" SDR 35 6+16.7		93-21244-7		2705 Wild Rose		12-20-93
	7+00	140.6	131.80	8.8								
		140.9	131.92	9.0	7+29.7	4" stub SW 4" SDR 35	4" LATE 133.93	93-22586-7	92-44137-7	2701 Wild Rose	2702 N Wild Rose	8-31-93 12-3-92
LINE 3	0+00		125.00		0+00							
	1+00	139.5	125.40	14.1								
	2+00	141.1	125.80	15.3								
						1+89.3 4" N 132.93 2+69.9 4" N 132.94	1+18.4 4" S 132.98 2+00 4" R/S S 133.80 2+69.9 4" E 132.94	92-24806-7	92-11046-7	2802 Wild Rose	2801 N Wild Rose	6-19-95 2-12-97 7-7-92 6-19-95
		141.6	126.16	15.4	2+90.7							
	3+00	141.1	126.20	14.9		4" SCH 40 3+16.7 4" N 132.55	3+25.4 4" R/S S 132.30	2001- 00556		2810 N Wild Rose		3-15-01
								92-45509-7		2805 Wild Rose		12-21-97
	4+00	140.9	126.60	14.3		4+05.2 4" N 132.35	4+35 F R/S S 132.74	92-8886-7		2814 Wild Rose		6-12-92
								92-8477-7		2809 Wild Rose		6-9-92

LINE 1

LINE 2

LINE 3

(CONT. N-32)

Form #192-020 (July, 1981)  
 92-24806-7 8127192-7314-w. Reflection cr - Conn to MH stub  
 4" PVC 40 (Lower 20')  
 4" SDR 35 (upper end to House)