PRIVATE SANITARY SEWER TO SERVE WESLEY MEDICAL CENTER EMERGENCY ROOM
PRIV. PROJ. NO. 332 PPS (607861)
BUILT BY WILDCAT CONST. CO.
BOOKED 2-16-94 FROM AS BUILTS

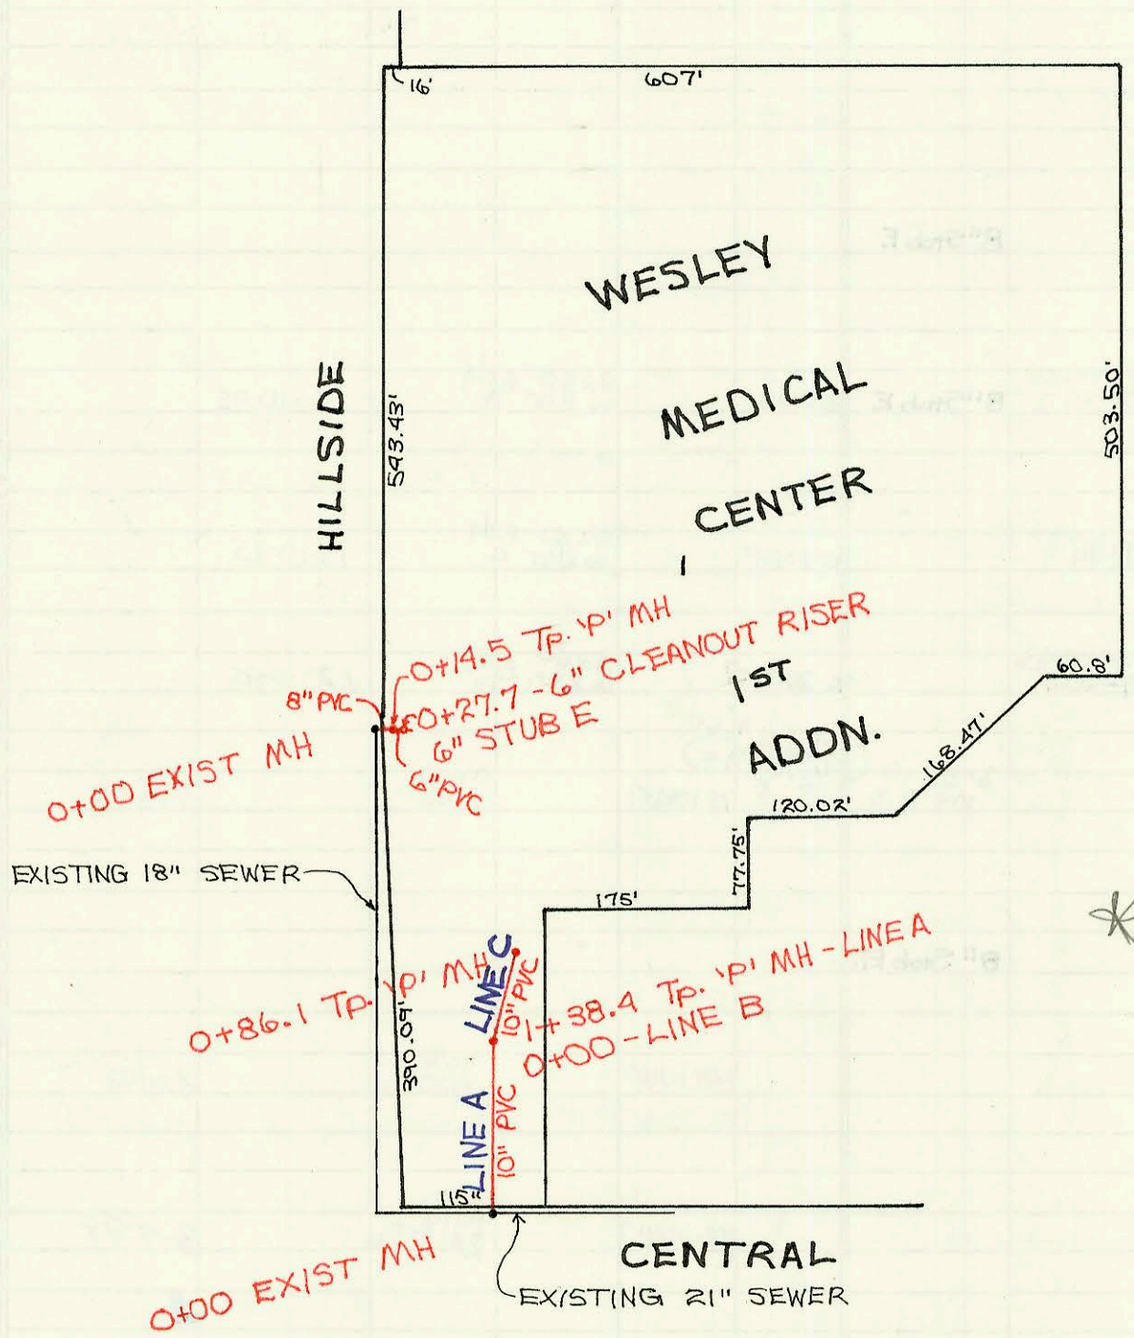


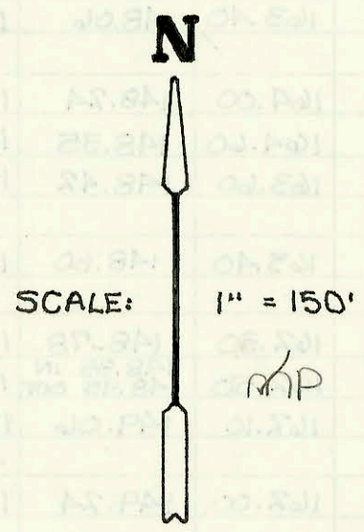


** NOTE: THIS PROJECT IS PRIVATELY OWNED AND MAINTAINED.

PRIVATE SANITARY SEWER TO SERVE QUIK TRIP 5TH ADDN.
PRIV. PROJ. NO. 411 PPS (607861)
BUILT BY DONDLINGER + SONS
BOOKED 2-17-94 FROM AS BUILTS

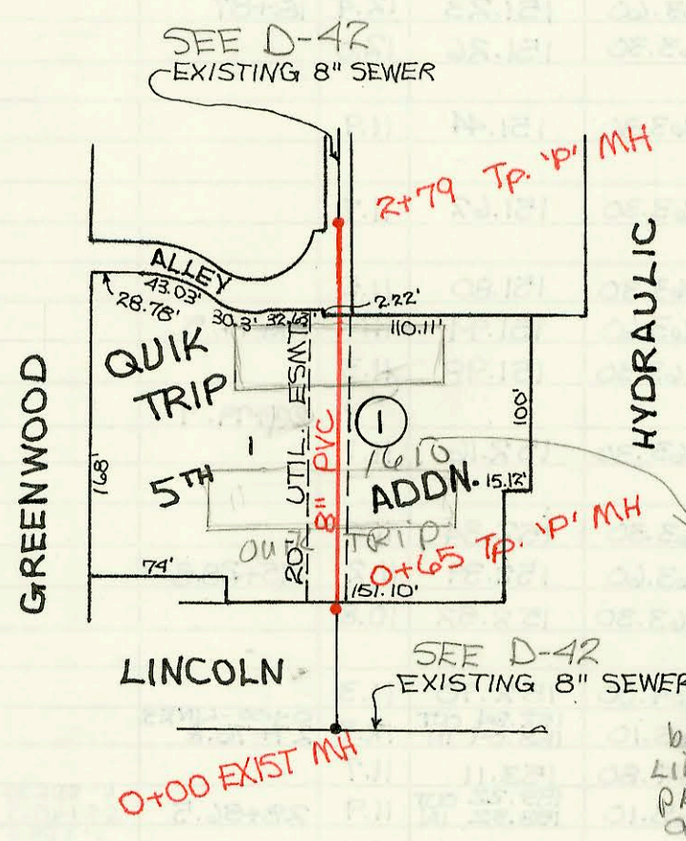


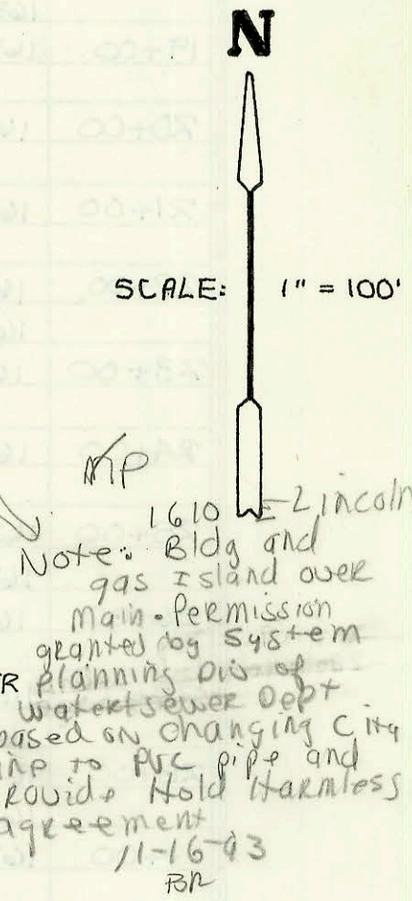


Note: 1610 E. Lincoln Bldg and gas Island over main. Permission granted by System Planning Div of Water+Sewer Dept based on changing City Line to PVC pipe and provide Hold Harmless agreement 11-16-93 BR

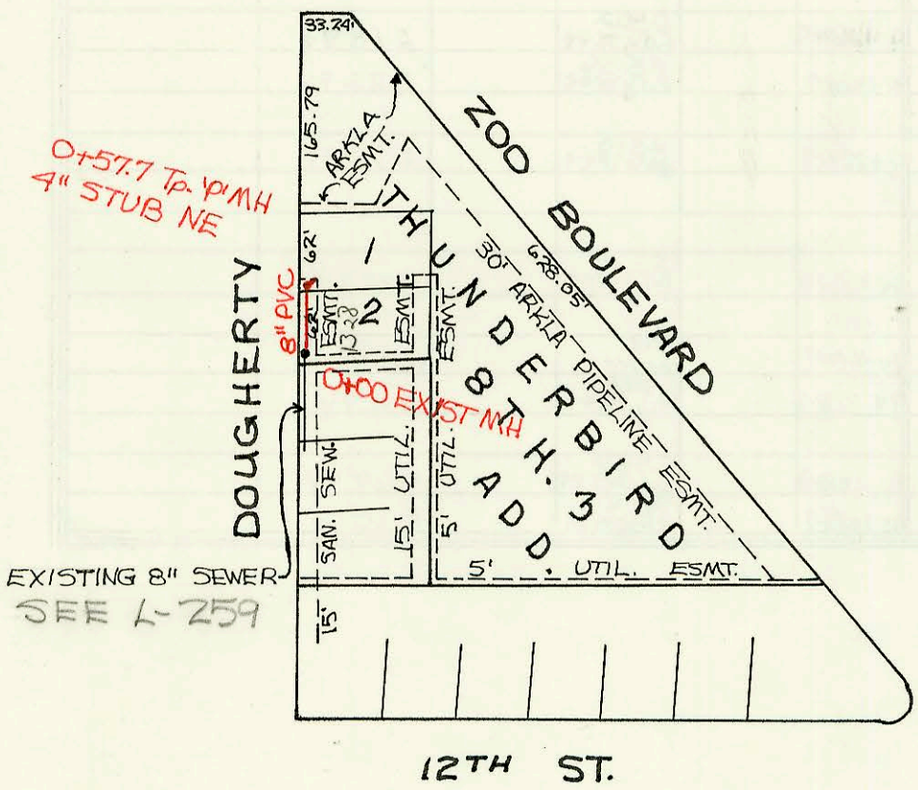


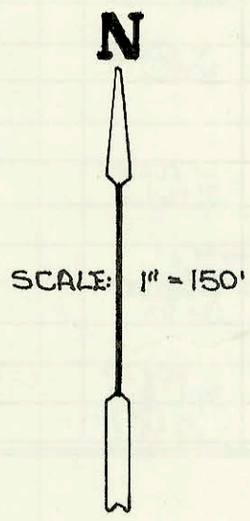


PRIVATE SANITARY SEWER EXTENSION TO SERVE THUNDERBIRD 8TH ADDN.
PRIV. PROJ. NO. 431 PPS (607861)
BUILT BY MIES CONST. CO.
BOOKED 4-11-94 FROM AS BUILTS

MP

N-96

| | CONSTRUCTION RECORD | | | | | | SERVICE RECORD | | | | | |
|---|---|---|---|---|---|---|---|---|---|---|---|---|
| | STATION | ELEVATION | | Depth | MANHOLE | 4-INCH "Y" BRANCHES | | No. of Permit | | House Number | | DATE OF PERMITS | |
| | | Ground | Grade | | | North West | South East | North West | South East | North West | South East | North West | South East |
| | Private Sanitary Sewer To Serve Wesley Medical Center Emergency Room | | | | | | | | | | | | |
| LINE A | 0+00 | 143.50 | 129.76 OUT 131.05 IN | 13.7 | 0+00 | | | | | | | | |
| | 1+00 | 148.50 | 135.15 | 13.4 | | | | | | | | | |
| | | 149.75 | 136.72 | 13.0 | 0+00 - LINE B 1+38.4 | | | | | | | | |
| LINE B | 0+00 | 150.30 | 140.60 OUT 143.76 IN | 9.7 | 0+00 | | | | | | | | |
| | | 150.30 | 144.15 OUT 144.60 IN | 6.2 | 0+14.5 | | | | | | | | |
| | 0+27.7 | 150.40 | 145.00 | 5.4 | | | 6" Stub E | | | | | | |
| LINE C | 0+00 | 149.75 | 136.72 OUT 139.82 IN | 13.0 | 1+38.4 - LINE A 0+00 | | | | | | | | |
| | | 150.98 | 141.19 | 9.8 | 0+86.1 | | | | | | | | |
| | Private Sanitary Sewer To Serve Quik Trip 5th Addn. | | | | | | | | | | | | |
| | 0+00 | 106.14 | 96.10 | 10.0 | 0+00 | | | | | | | | |
| | | 108.45 | 96.11 | 12.3 | 0+65 | | | | | | | | |
| | 1+00 | 108.00 | 96.28 | 11.7 | | | | | | | | | |
| | | | | | | 4" PVC 40 1+55.2 | | 93-31419-7 | | 1610 E Lincoln | | 11-16-93 | |
| | 2+00 | 109.00 | 96.78 | 12.2 | | | | | | | | | |
| | | 105.50 | 97.17 IN 97.30 OUT | 8.3 | 2+79 | | | | | | | | |
| | Private Sanitary Sewer Extension To Serve Thunderbird 8th Addn. | | | | | | | | | | | | |
| | 0+00 | 127.74 | 119.79 OUT 119.29 IN | 8.6 | 0+00 | | 4" SDR 35 0+12 | | 93-31247 | | 1320 Dougherty | | 12-30-93 |
| | | 127.54 | 119.44 | 8.1 | 0+57.7 | 4" Stub NE | | | 2002 55311 | | 1320 Dougherty | | 2-8-02 |
| | Lateral 109, Westlink Sewer (Continued from Page N-98) | | | | | | | | | | | | |
| LINE 6 (Cont'd.) | 3+00 | 166.90 | 156.16 | 10.7 | | 4" S.D.R. 35 3+01.5 N/C | | 95-39947-7 | | 9010 W Chartwell | | 3-22-95 | |
| | 4+00 | 167.50 | 156.46 | 11.0 | | | | 97-41287 | | 9014 Chartwell | | 3-18-97 | |
| | | 167.70 | 156.48 | 11.2 | 4+07.5 | 4" Stub NW | | 96-21066-7 | | 9018 Chartwell Ct | | 12-16-96 | |
| LINE 7 | 0+00 | 166.40 | 155.72 OUT 155.82 IN | 10.7 | 1+85.5 - LINE 6 0+00 | | | | | | | | |
| | | | | | | 4" S.D.R. 35 0+88 N/C | | 95-19677 | | 8920 Chartwell | | 2-13-95 | |
| | 1+00 | 165.90 | 156.12 | 9.8 | | | | | | | | | |
| | | | | | | 4" SDR 35 1+87.1 | | 95-43387 | | 8918 Chartwell | | 3-22-95 | |
| | 2+00 | 166.20 | 156.42 | 9.8 | | | | | | | | | |
| | | 166.50 | 156.44 | 10.1 | 2+08.1 | 4" SDR 35 4" Stub NO | | 94-20467-7 | | 8914 Chartwell | | 12-16-94 | |

Form #192-020 (July, 1981)