

MAIN 1, COWSKIN INTERCEPTOR SEWER- PHASE V
PROJECT NO. 468-82001 (725028)
BUILT BY UTILITY CONSTRUCTION CO.
BOOKED 03/06/95 AS PER PLAN


MAPLE

STREET

END OF PHASE IV

UNPLATTED TRACT

D-803-UP

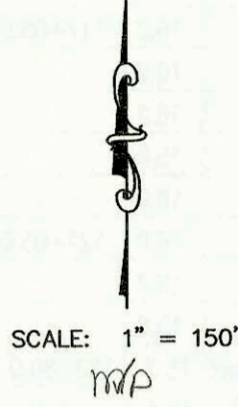

TAFT

ST.

1
⑥

119TH STREET WEST

D-566-UP

ABANDON EXIST 4" FORCE MAIN

EXIST 4" FORCE MAIN & 8" SAN SEW.
SEE K-247

STUBBS
①
ADDN.

EXIST LIFT STATION ABANDONED
MH TYP 'P' & TIE IN EXIST 8" MW

UNPLATTED TRACT

98+79.6 MH TYP 'P'
97+74.6- LINE 1 MH TYP 'P'
0+00.0- LINE 3
96+95 TO 97+60 - STEEL ENCASEMENT

40' SANITARY SEWER 'P' BY SEP. INST.
93+77.5 MH TYP 'P'
8" STUB N (12.8 L.F.)

UNPLATTED TRACT

D-569-UP

89+05.9 MH TYP 'P'

30' SAN. SEW. BY SEP. INST.

D-570-UP

3+50.0 MH TYP 'P'

ABANDON EXIST 4" FORCE MAIN
SEE L-229

UNPLATTED TRACT

D-568-UP

7+82.5 MH TYP 'P'

