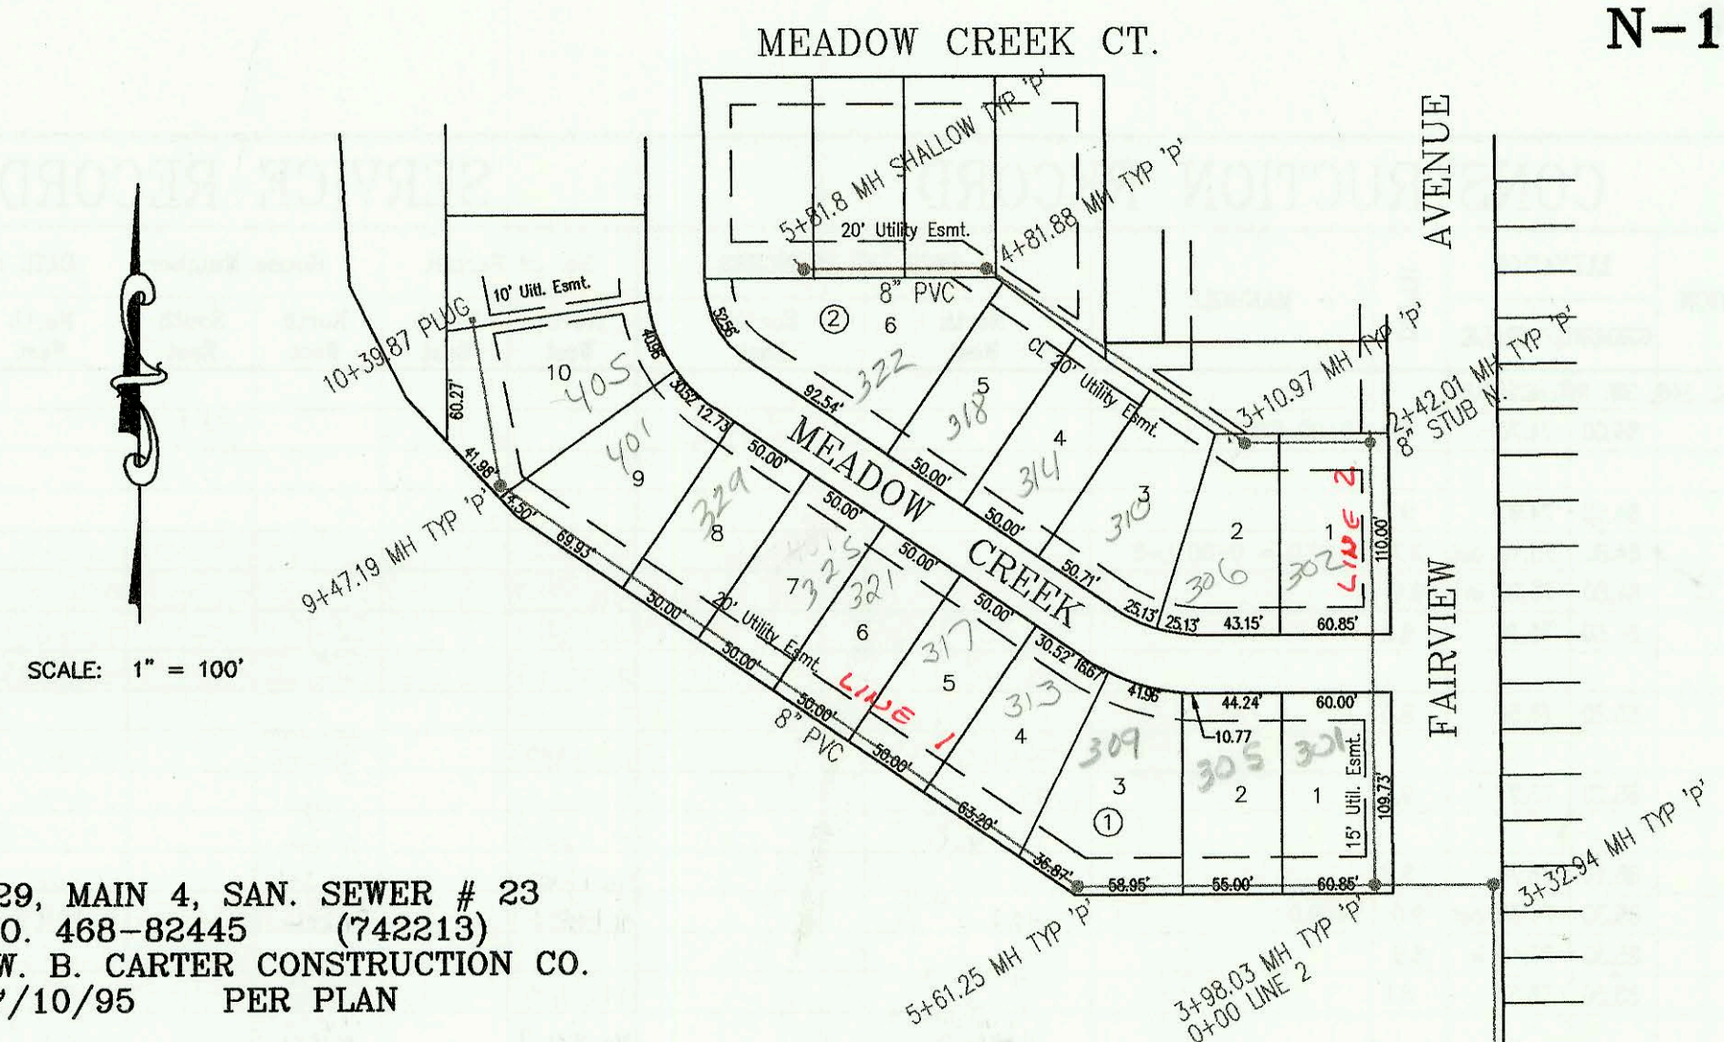

SCALE: 1" = 100'

LATERAL 129, MAIN 4, SAN. SEWER # 23
PROJECT NO. 468-82445 (742213)
BUILT BY W. B. CARTER CONSTRUCTION CO.
BOOKED 7/10/95 PER PLAN

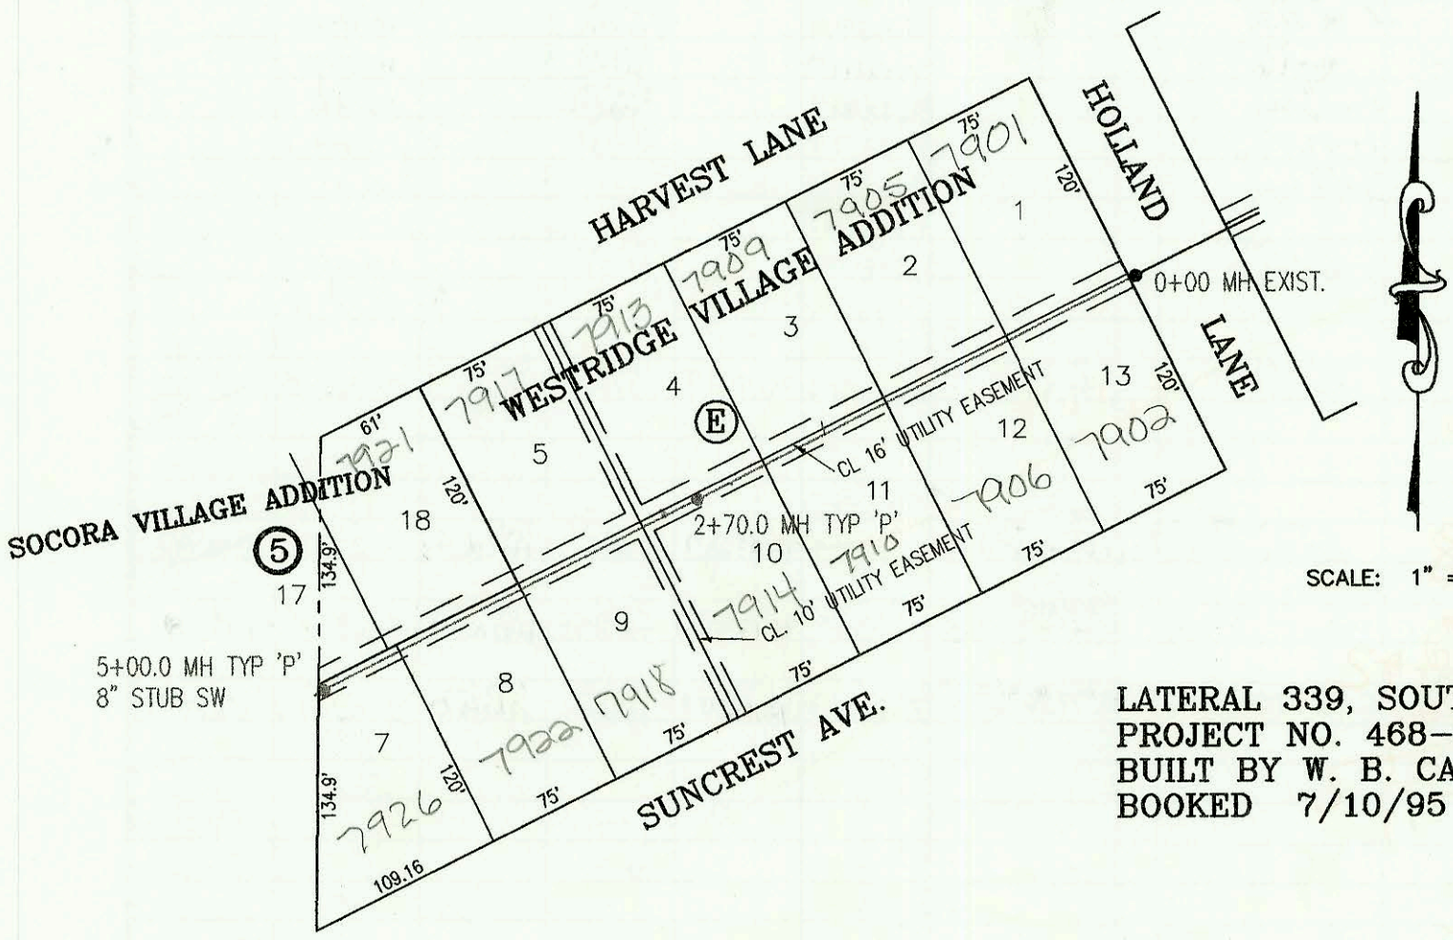

SCALE: 1" = 100'

LATERAL 339, SOUTHWEST INTERCEPTOR SEWER
PROJECT NO. 468-82421 (742148)
BUILT BY W. B. CARTER CONSTRUCTION CO.
BOOKED 7/10/95 PER PLAN

PRIVATE SANITARY SEWER TO SERVE LOTS 5 & 6,
REFLECTION RIDGE COMMERCIAL 2ND ADDITION
PROJECT NO. 545 PPS (607861)
BUILT BY MCCULLOUGH EXCAVATION CO.
BOOKED 07/17/95 AS PER PLAN

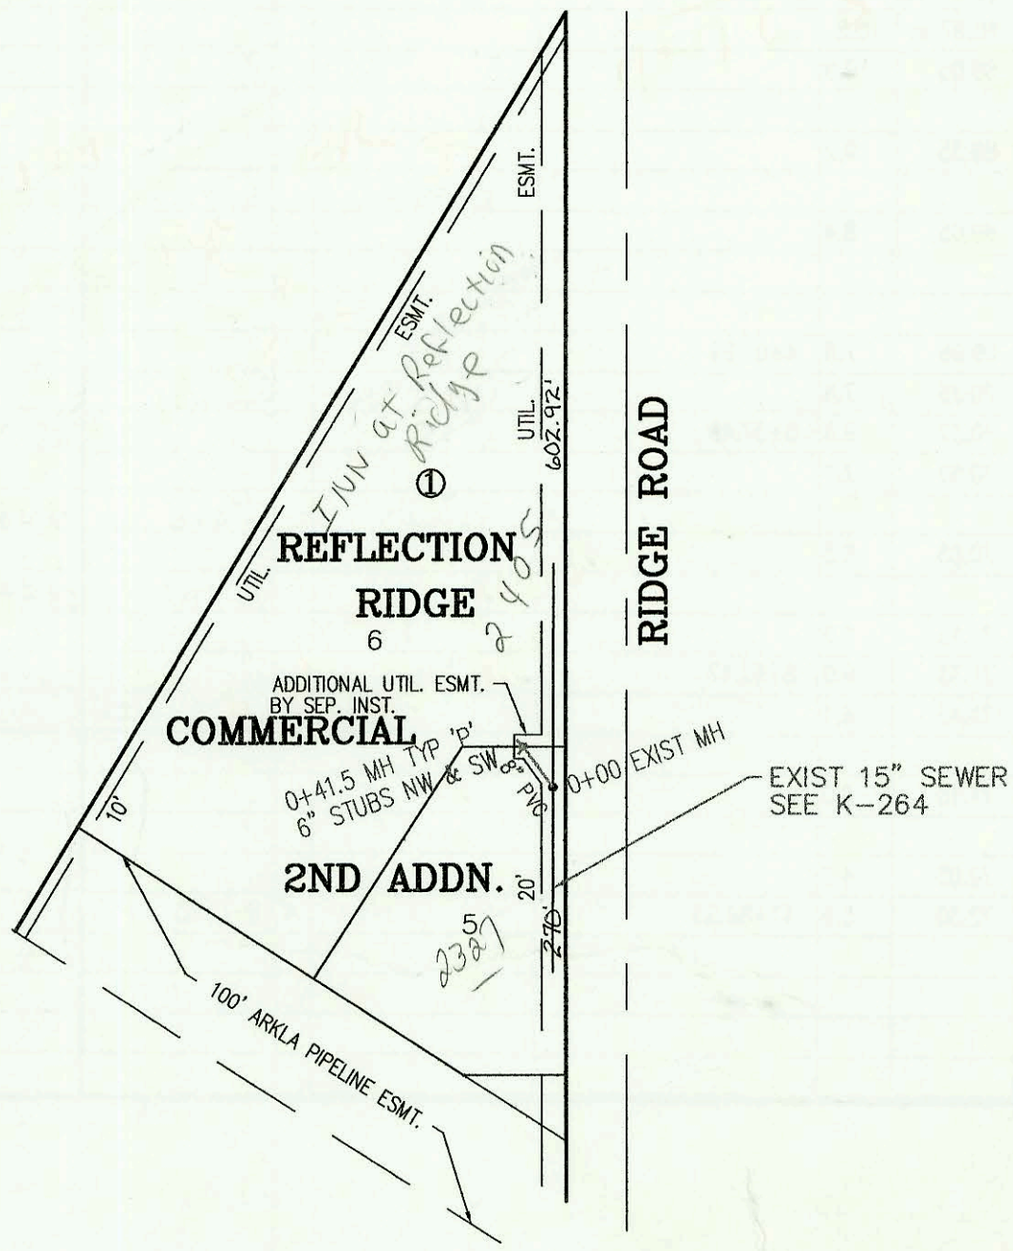

SCALE: 1" = 150'

N-169

	CONSTRUCTION RECORD							SERVICE RECORD					
	STATION	ELEVATION GROUND	ELEVATION GRADE	DEPTH	MANHOLE	4-INCH "Y" BRANCHES North West	4-INCH "Y" BRANCHES South East	No. of Permit North West	No. of Permit South East	House Number North West	House Number South East	DATE OF PERMITS North West	DATE OF PERMITS South East
	LATERAL 129, MAIN 4, SANITARY SEWER NO. 23												
L-1	0+00 L-1	127.05	118.45	8.6	0+00 EXIST								
		126.72	118.54 out	8.2	0+30.61								
		126.72	118.64 in	8.1									
	1+00	126.90	118.85	8.1									
	2+00	126.30	119.15	7.2									
	3+00	125.40	119.45	6.0									
		126.00	119.55 out	6.4	3+32.94								
		126.00	119.65 in	6.3									
		125.80	119.84	6.0	3+98.03 = 0+00 L-2								
	4+00					4" sch40 4+20.0		95-12529-7		301 W Meadowcreek		8-14-95	
						4" PVC40 4+76.3		95-12530-7		305 W Meadowcreek		8-14-95	
	5+00	126.20	120.15	6.0		4" PVC40 5+36.2		95-12531-7		309 W Meadowcreek		8-14-95	
		126.70	120.33	6.4	5+61.25								
	6+00	125.90	120.45	5.5		4" sch40 6+32.2		95-12533-7		313 W Meadowcreek		8-14-95	
						4" sch40 6+80.3		95-12534-7		317 W Meadowcreek		8-14-95	
	7+00	125.40	120.75	4.7		4" sch40 7+36.8		95-12535-7		321 W Meadowcreek		8-14-95	
	8+00	126.10	121.05	5.0		4" PVC40 7+78.7		95-12536-7		325 W Meadowcreek		8-14-95	
						4" PVC40 8+33.7		95-12537-7		329 W Meadowcreek		8-14-95	
	9+00	126.30	121.35	5.0		4" sch40 8+91.0		95-12538-7		401 W Meadowcreek		8-14-95	
		126.60	121.49	5.1	9+47.19		4" PVC40 9+76.7		95-12539-7		405 W Meadowcreek		8-14-95
	10+00	126.20	121.65	4.5									
	10+39.87	126.00	121.77	4.2									
L-2	0+00 L-2	125.80	119.94	5.9	0+00 = 3+98.03 L-1								
	1+00	124.50	120.24	4.3									
	2+00	125.60	120.54	5.1									
		125.50	120.67 out	4.8	2+42.01	8" N 120.67	4" PVC40 2+63.0		95-12540-7		302 W Meadowcreek		8-14-95
		125.50	120.77 in	4.7			4" sch40 3+20.9		95-12541-7		306 W Meadowcreek		8-14-95
	3+00						4" sch40 3+42.9		95-12542-7		310 W Meadowcreek		8-14-95
		126.20	120.98	5.2	3+10.97		4" sch40 3+98.3		95-12544-7		314 W Meadowcreek		8-14-95
	4+00	125.60	121.26	4.3			4" sch40 4+37.5		95-12546-7		318 W Meadowcreek		8-14-95
		126.70	121.49	5.2	4+81.88								
	5+00	126.60	121.56	5.0			4" PVC40 5+08.0		95-12554-7		329 W Meadowcreek		8-14-95
		126.50	121.79	4.7	5+81.8	4" NW 122.12							
	LATERAL 339, SW INTERCEPTOR												
	0+00	157.40	143.81	13.6	0+00 EXIST	4" SCH40 0+40 Predco	4" SCH40 0+63	2000 02531	2000 02640	7901 Harvest Ln	7902 Suncrest	11-17-00	12-1-00
	1+00	158.00	144.21	13.8		4" SCH40 1+13 SADDLE	4" SCH40 0+99 SADDLE	2000 02532	2000-02641	7905 Harvest Ln	7906 Suncrest	11-17-00	12-1-00
	2+00	158.60	144.61	14.0		4" SCH40 1+91 SADDLE	4" SCH40 1+70.2 SADDLE	2000-02533	2000-02387	7909 Harvest Ln	7910 Suncrest	11-17-00	11-2-00
		159.60	144.89	14.7	2+70.0	4" SCH40 2+91.0 SADDLE	4" SCH40 2+57.2 SADDLE	2000-02391	2000-02388	7913R Harvest Ln	7914 Suncrest	8-1-01 SEE BELOW 11-2-00	11-2-00
	3+00	159.40	145.01	14.4		4" SCH40 3+42.6 SADDLE	4" SCH40 4+43 SADDLE	2000-02392	2000-02389	7917 Harvest Ln	7918 Suncrest	11-2-00	11-2-00
	4+00	160.00	145.41	14.6		4" SCH40 4+92 SADDLE	4" SCH40 4+72 SADDLE	2000-02393	2000-02390	7921 Harvest Ln	7922 Suncrest	11-2-00	11-2-00
							4" SCH40 4+79 SADDLE		2000-02394		7926 Suncrest		11-2-00
	5+00	161.21	145.81	15.4	5+00		8" SW 145.81						
	PRIVATE SANITARY SEWER TO SERVE LOTS 5 & 6, REFLECTION RIDGE COMMERCIAL 2ND ADD.												
	0+00	140.50	128.33 OUT	12.2	0+00								
		140.50	129.79 IN	10.7									
		140.30	131.23	9.1	0+41.5	6" NW 131.4	6" SW 131.4	95-45257		2405 Ridge Rd		4-4-95	

2001-01894 - 8/1/01 - 7913 W. Harvest Ln - Padgett Exc - 4" SCH40 Repair 10' N of Main 2' PVC Pipe