PRIVATE SANITARY SEWER TO SERVE WILLOW POINT AT EAGLE LAKE ADDITION
PRIVATE PROJECT NO. 561PPS (607861)
BUILT BY MIES CONSTRUCTION CO.
BOOKED 10/12/95 FROM AS BUILTS

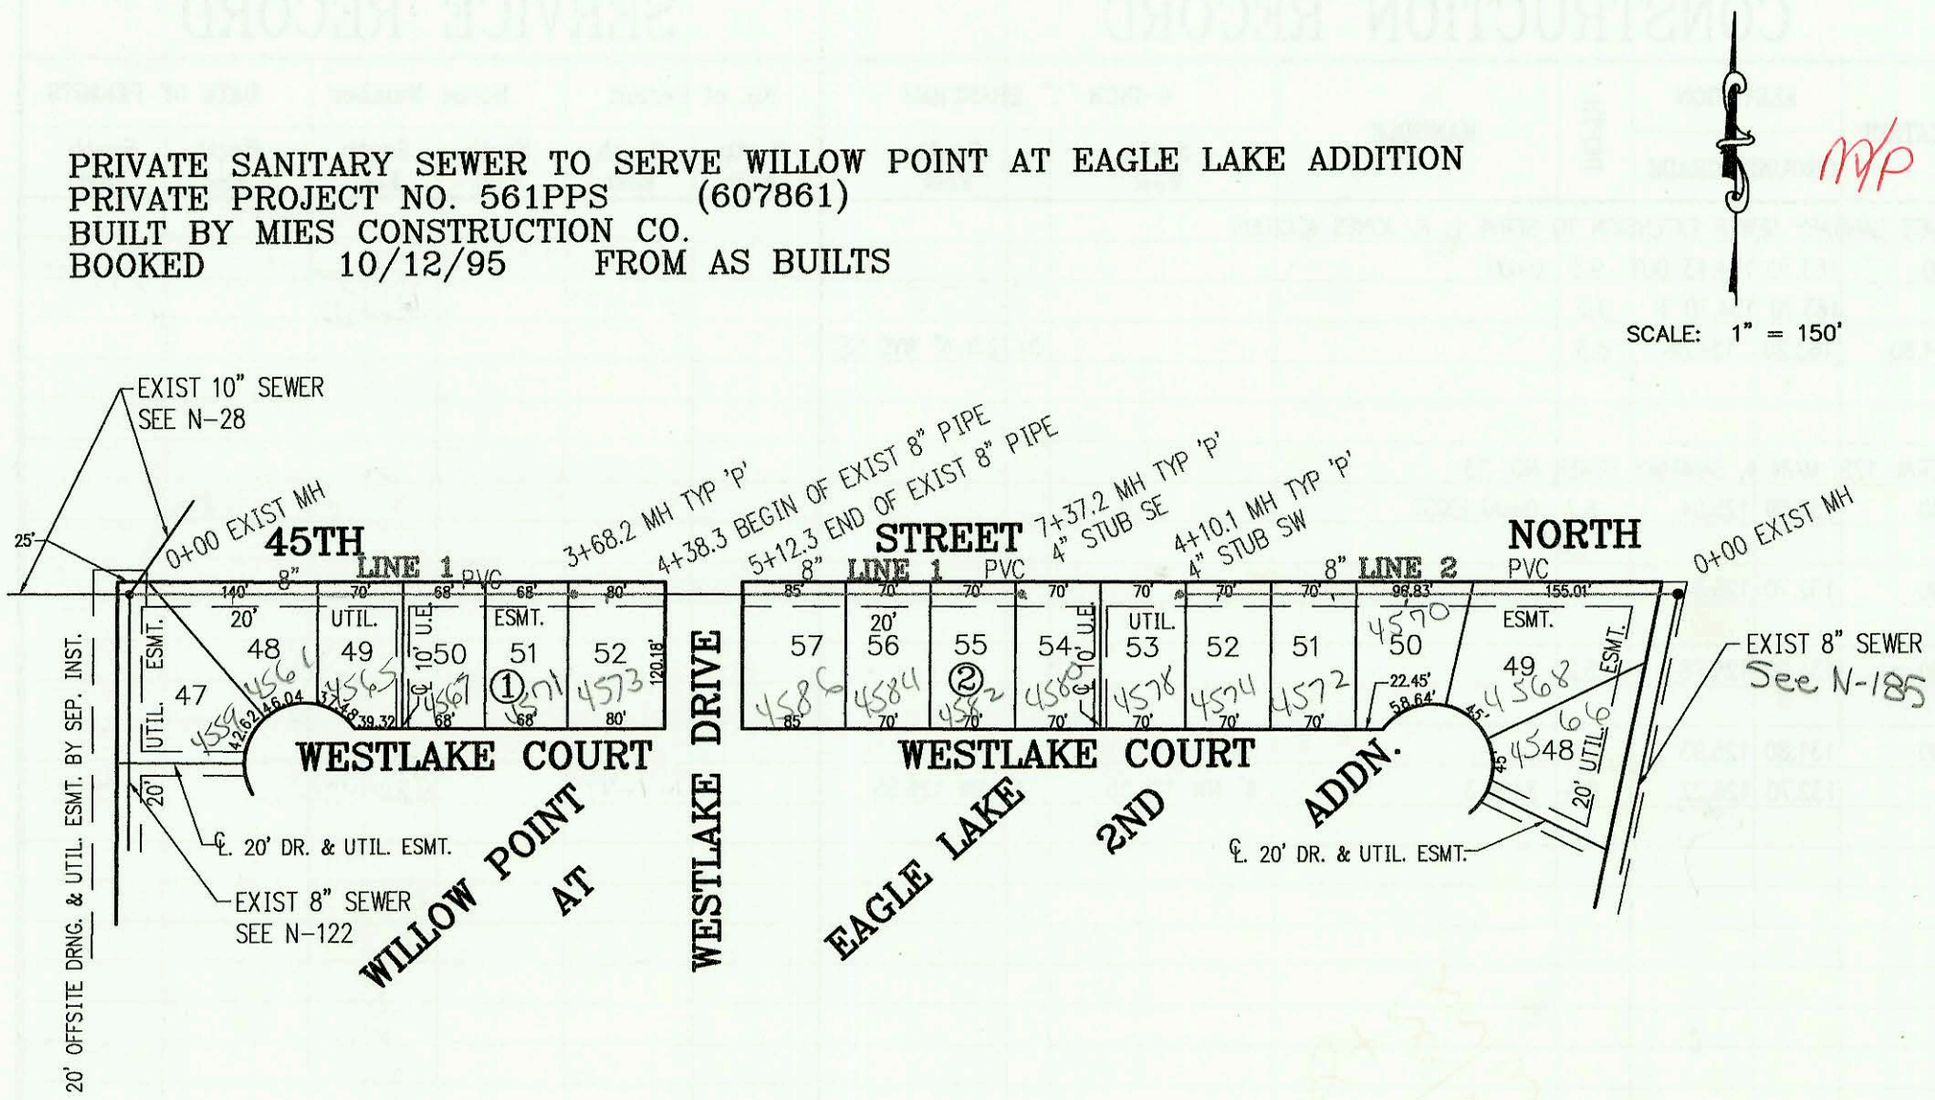

PRIVATE SANITARY SEWER EXTENSION TO SERVE LOT 8, SUNNYSIDE GARDENS THIRD ADDITION
PRIVATE PROJECT NO. 567PPS (607861)
BUILT BY W. B. CONSTRUCTION CO.
BOOKED 10/12/95 FROM AS BUILTS

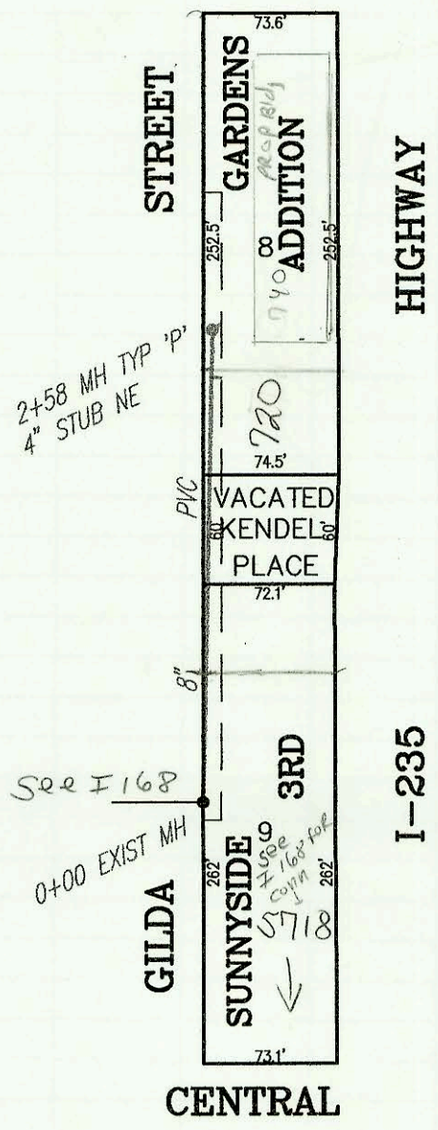

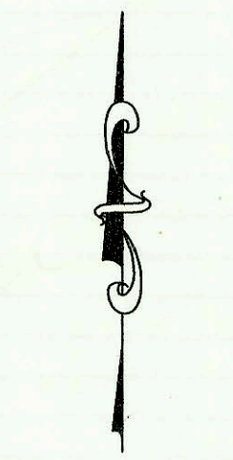

N-183

CONSTRUCTION RECORD

STATION	ELEVATION GROUND	ELEVATION GRADE	DEPTH	MANHOLE	4-INCH "Y" BRANCHES North West	4-INCH "Y" BRANCHES South East
PRIVATE SANITARY SEWER TO SERVE WILLOW POINT AT EAGLE LAKE SECOND ADDITION						
0+00 L-1	216.26	202.68 OUT	13.6	0+00		0+85.0 4" SCH 40
	216.26	204.46 IN	11.8			
1+00	215.20	206.32	8.9			
2+00	219.20	208.18	11.0			
3+00	220.60	210.04	10.6			
	222.21	211.31 OUT	10.9	3+68.2		
	222.21	211.41 IN	10.8			3+96.8 4"SDR 35
4+00	223.80	212.05	11.8			
4+38.3	224.20	212.83	11.4			
5+00	225.50	214.38	11.1			
5+12.3	225.90	214.33	11.6			
6+00	227.40	216.11	11.3			
7+00	228.70	218.14	10.6			
	228.81	218.89	9.9	7+37.2		4" SE 219.22
0+00 L-2	219.58	205.63 OUT	13.9	0+00		
	219.58	207.63	11.9			
1+00	224.60	210.28	14.3			4" SCH 40 1+19.0
2+00	226.20	212.92	13.3			4" SDR 35 2+25.0
3+00	227.60	215.57	12.0			4" SDR 35 2+85.1
4+00	228.50	218.22	10.3			4" SCH 40 3+80.1
	228.58	218.48	10.1	4+10.1		4" SW 218.48
PRIVATE SANITARY SEWER EXTENSION TO SERVE SUNNYSIDE GARDENS THIRD ADDITION						
0+00	122.12	116.85 OUT	5.3	0+00		
	122.12	116.95 IN	5.2			
1+00	122.60	117.35	5.3			
2+00	123.00	117.75	5.3			4" SDR 35 2+33.8
	122.90	117.98	4.9	2+58		4" SCH 40 4" STUB NE Flow 118.31

SERVICE RECORD

No. of Permit North West	No. of Permit South East	House Number North West	House Number South East	DATE OF PERMITS North West	DATE OF PERMITS South East
	3151		4561 Westlake		6-24-97
	3238		4565 Westlake		11-4-97
	3359		4567 Westlake		8-4-98
	3327		4571 Westlake		9-16-98
	3102		4573 Westlake		8-28-97
	3176		4586 Westlake		8-8-97
	3293		4584 Westlake		3-19-99
	3292		4582 Westlake		3-1999
	3367		4580 Westlake		8-27-98
	2945		4568 Westlake		1-22-96
	2999		4570 Westlake		6-5-96
	3466		4572 Westlake		3-9-98
	3377		4574 Westlake		6-19-98
	2002-00941		4578 Westlake		4-17-00
	95-16N9-1		720 N Gilda		9-27-95
	2001-00796		740 N Gilda		4-6-01