N-185A

PRIVATE SANITARY SEWER RELOCATION TO SERVE TYLER ACRES ADDITION
PRIVATE PROJECT NO. 574PPS (607861)
BUILT BY MIES CONSTRUCTION CO.
BOOKED 10/16/95 FROM AS BUILTS

m/p

SCALE: 1" = 150'

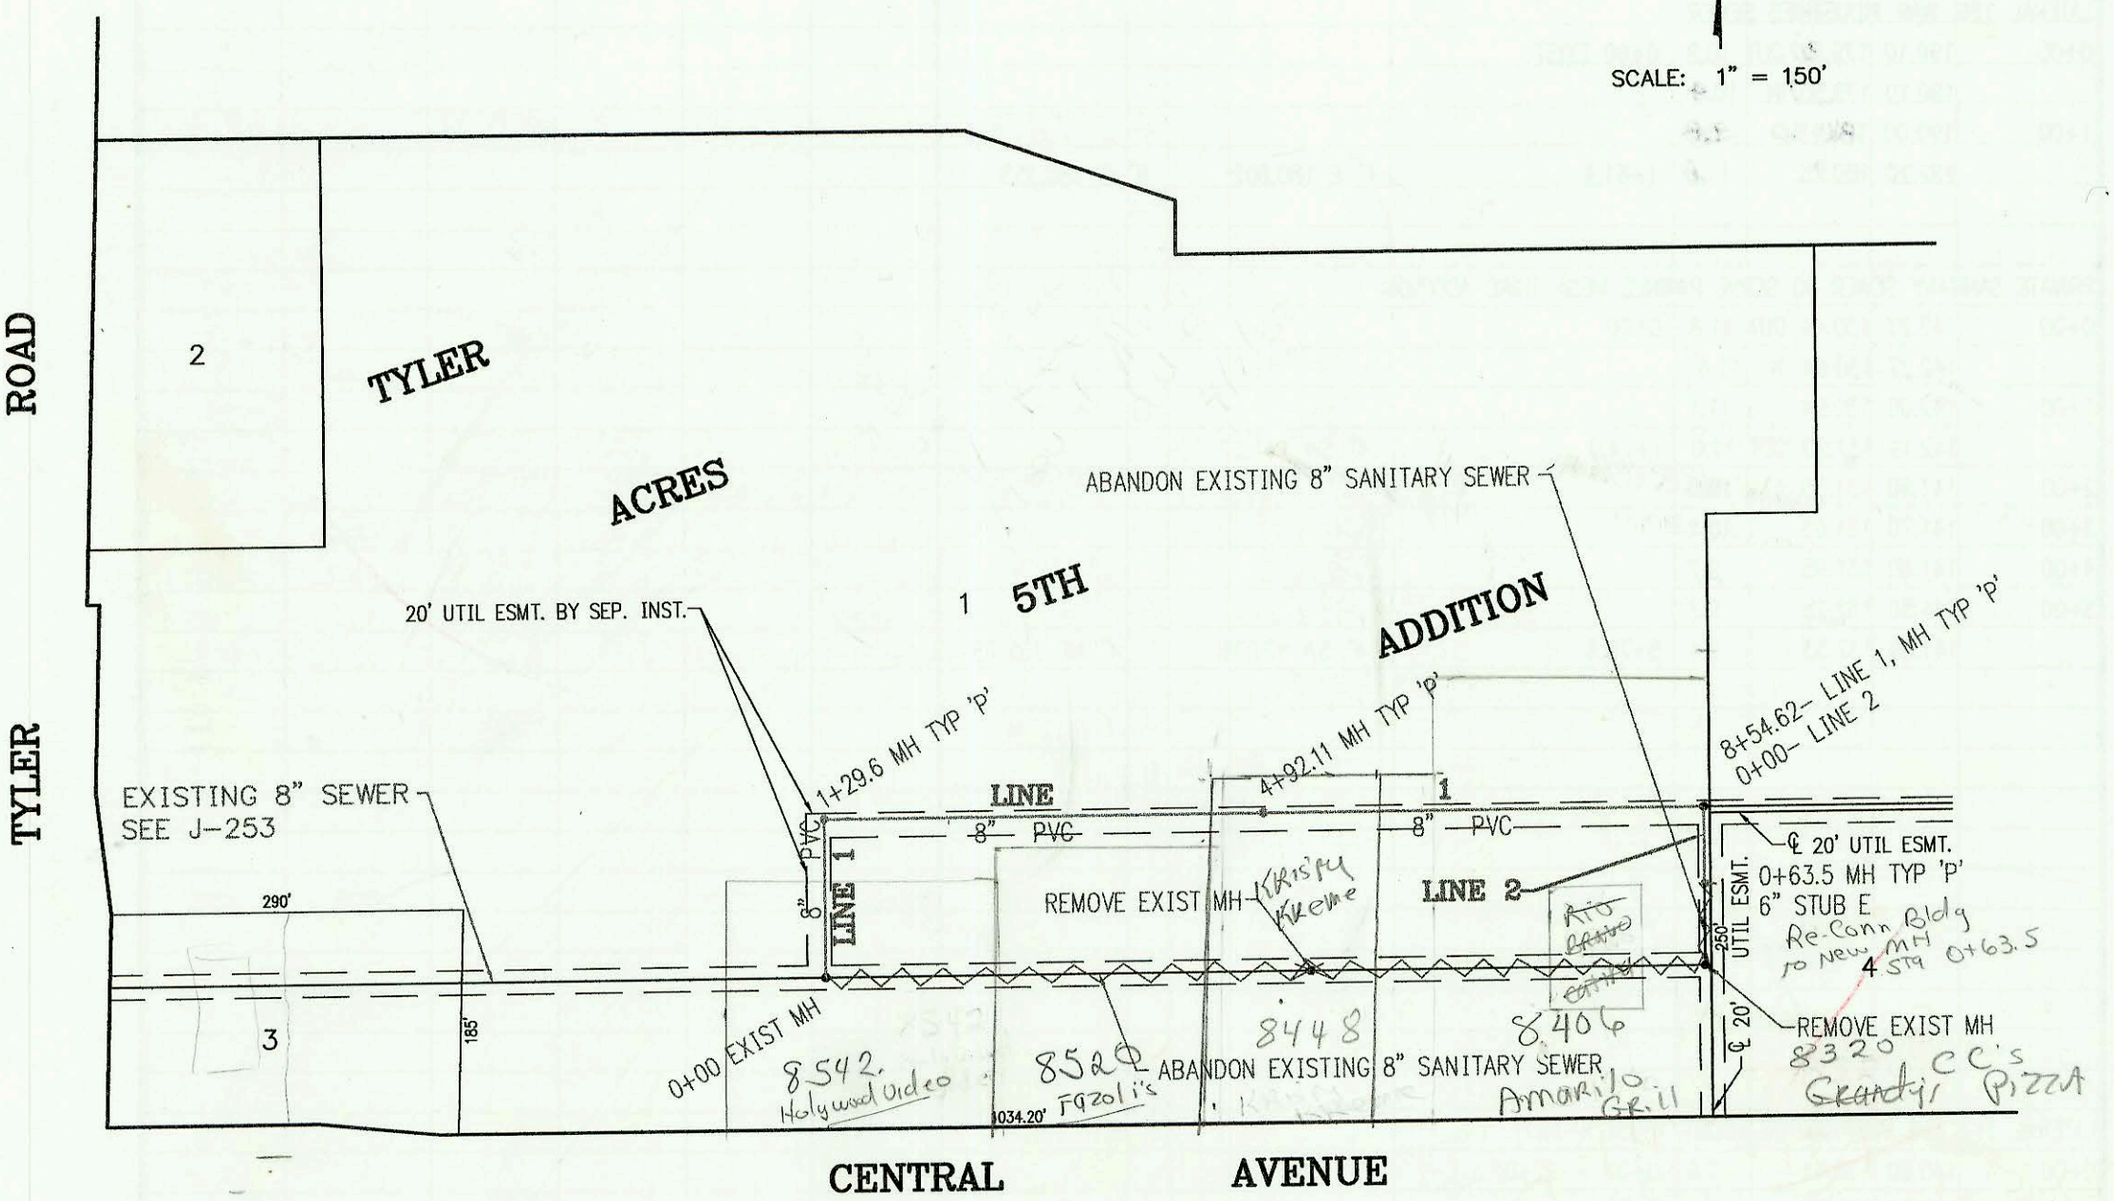

PRIVATE SANITARY SEWER TO SERVE WILLOW POINT AT EAGLE LAKE SECOND ADDITION
PRIVATE PROJECT NO. 543PPS (607861)
BUILT BY DULING CONSTRUCTION CO.
BOOKED 10/17/95 FROM AS BUILTS

mp

SCALE: 1" = 150'

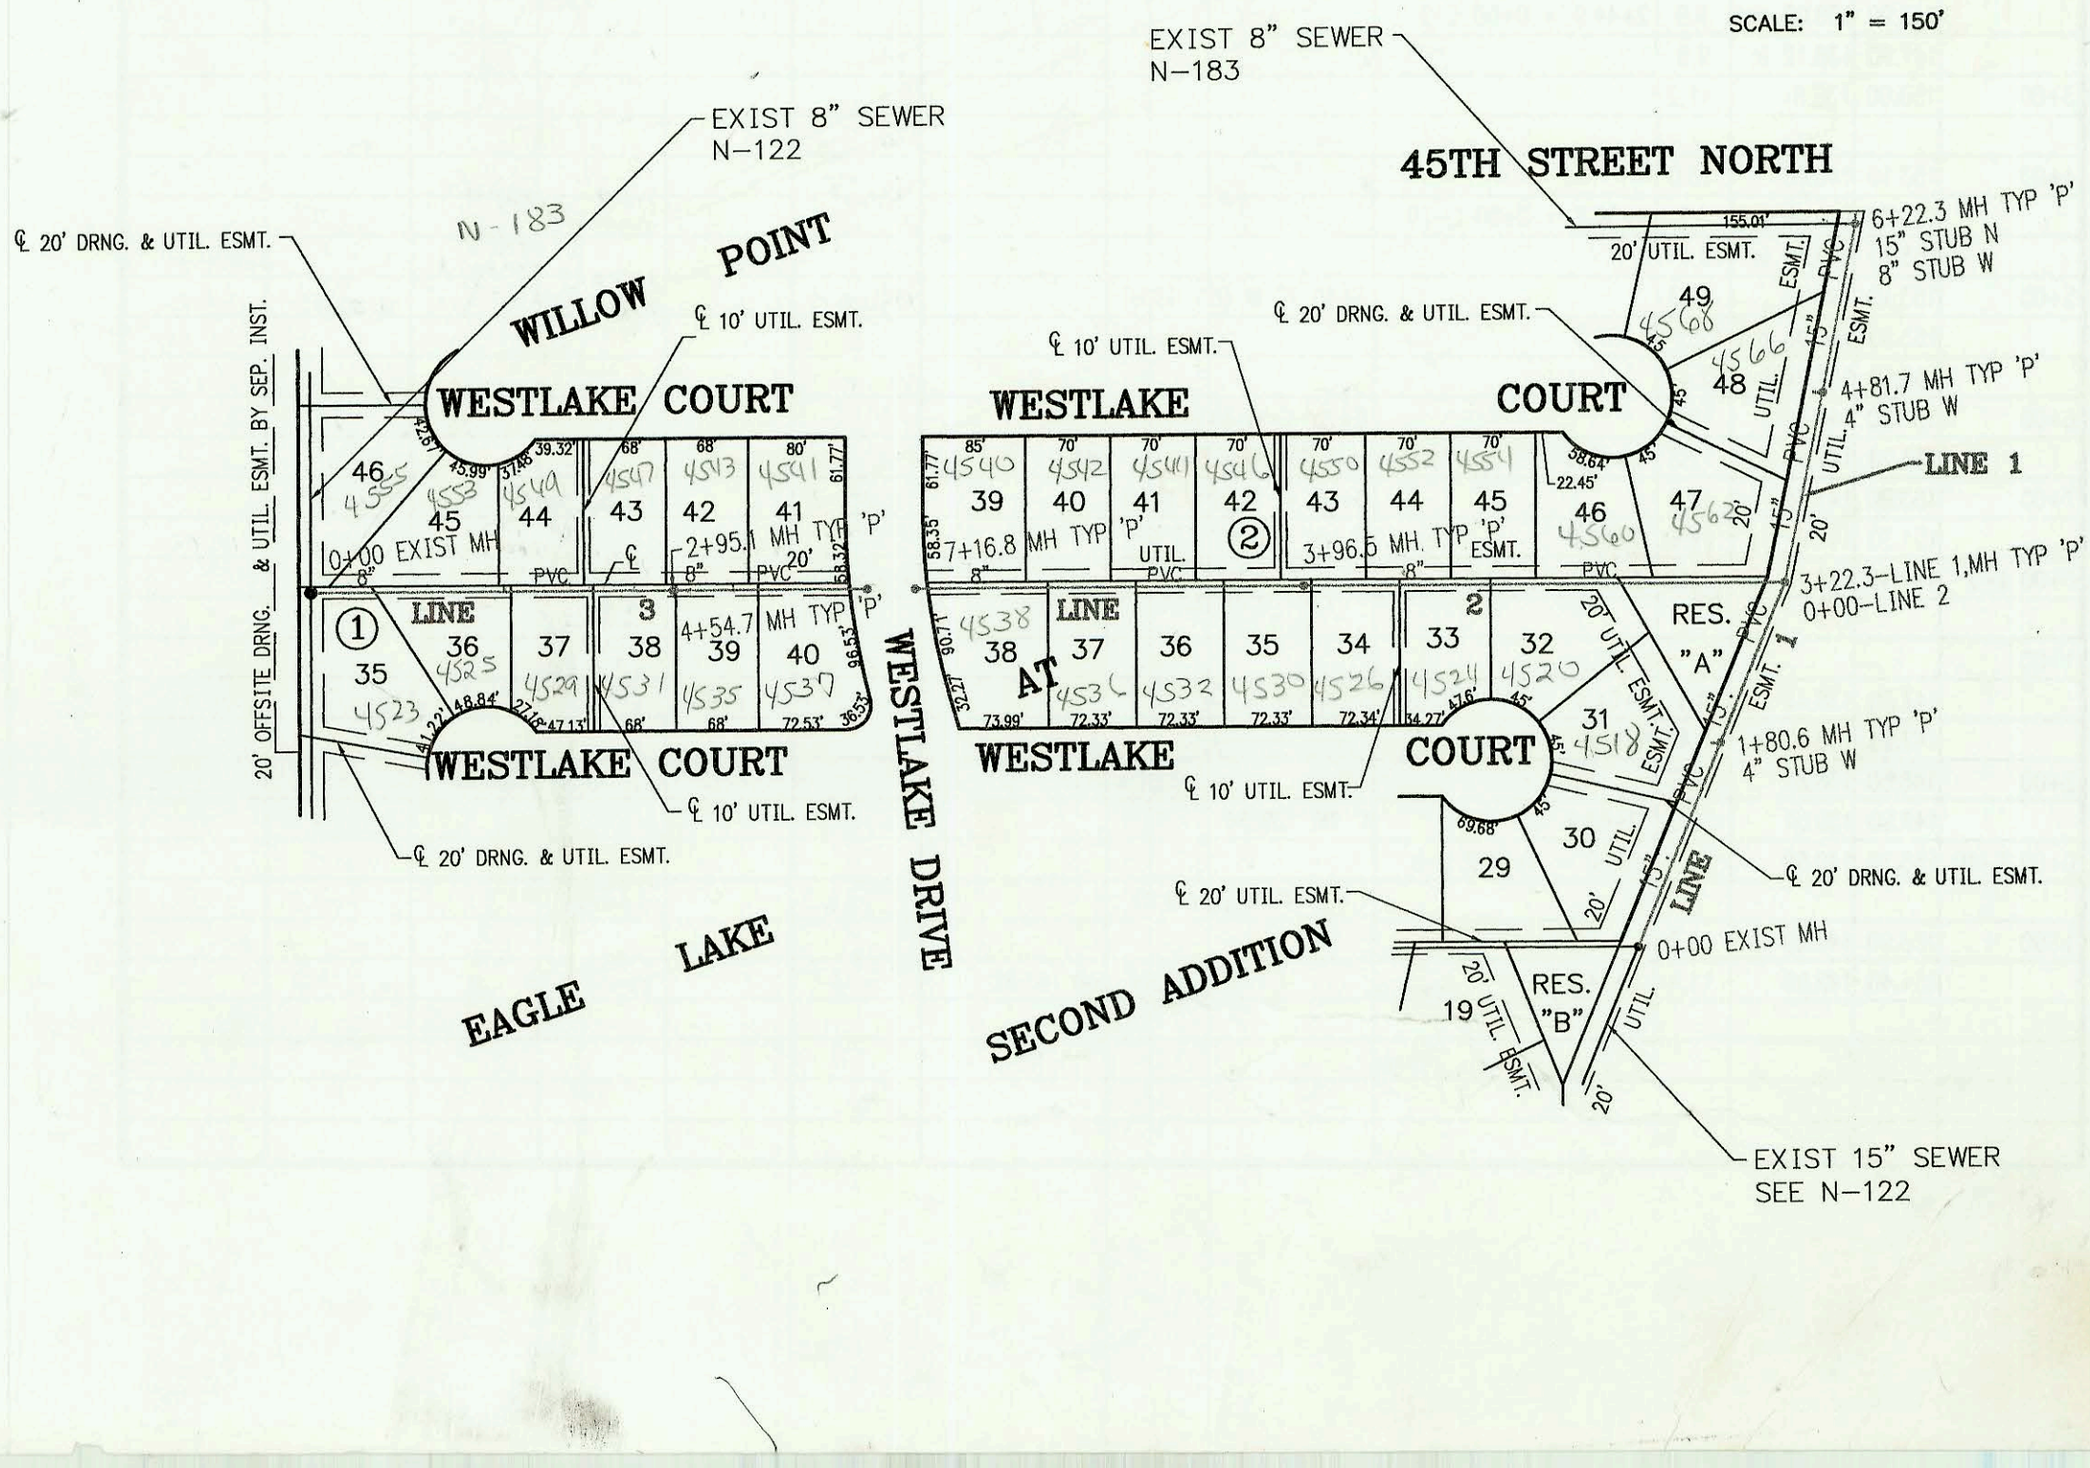

N-185

CONSTRUCTION RECORD

SERVICE RECORD

	STATION	ELEVATION GROUND / GRADE		DEPTH	MANHOLE	4-INCH "Y" BRANCHES North West	4-INCH "Y" BRANCHES South East	No. of Permit North West	No. of Permit South East	House Number North West	House Number South East	DATE OF PERMITS North West	DATE OF PERMITS South East
	PRIVATE SANITARY SEWER TO SERVE TYLER ACRES 5TH ADDITION												
Line 1	0+00 L-1	149.00	141.39 OUT	7.6	0+00								
		149.00	141.39 IN	7.6									
	1+00	147.90	141.83	6.1									
		148.44	141.84 OUT	6.6	1+29.6								
		148.44	141.90 IN	6.5									
	2+00	147.90	142.24	5.7		4" sch 40 2+34.6		96-203947 9513508?		8542 w Central	see below	12-6-96 8-29-95	
	3+00	147.70	142.55	5.1									
	4+00	147.20	142.86	4.3		4" PVC 40 4+00.1		96-119107		8520 Central		7-23-96	
		147.42	143.14	4.3	4+92.11				2003				
	5+00	147.50	143.16	4.3									
	6+00	146.60	143.47	3.1									
	7+00	147.40	143.78	3.6									
	8+00	147.80	144.09	3.7									
		149.50	144.26 OUT	5.2	8+54.62 = 0+00 L-2								
		149.50	144.36 IN	5.1									
Line 2	0+00 L-2	149.50	144.26 OUT	5.2	0+00 = 8+54.62 L-1								
		149.50	144.36 IN	5.1									
		148.84	144.56	4.3	0+63.5		6" E 144.56		95-136107		8320 w Central see below		8-30-95
	PRIVATE SANITARY SEWER TO SERVE WILLOW POINT AT EAGLE LAKE SECOND ADDITION												
Line 1	0+00 L-1	210.83	201.28 OUT	9.6	0+00								
		210.83	201.43 IN	9.4									
	1+00	212.50	202.03	10.5									
		214.26	202.51 OUT	11.8	1+80.6	4" W 204.06		2897		4518 Westlake		9-20-95	
		214.26	202.65 IN	11.6									
	2+00	214.00	202.79	11.2									
	3+00	215.50	203.48	12.0									
		216.20	203.64 OUT	12.6	3+22.3 = 0+00 L-2								
		216.20	203.74 IN	12.5									
	4+00	218.00	204.20	13.8									
		217.33	204.68 OUT	12.7	4+81.7	4" W 205.37		2994		4560 Westlake Ct		5-22-96	
		217.33	203.74 IN	13.6									
	5+00	217.10	204.84	12.3									
	6+00	219.90	205.49	14.4									
		219.58	205.63	13.9	6+22.3	8" W 207.63							
						15" N 205.78							
Line 2	0+00 L-2	216.20	203.64 OUT	12.6	0+00 = 3+22.6 L-1			2923		4562 Westlake Ct		12-5-95	
		216.20	204.39 IN	11.8									
	1+00	220.60	206.36	14.2		1+50.0 4" sch 40		3039		4560 Westlake		9-6-96	
	2+00	221.60	208.34	13.3		4" sch 40 2+58.9		2938	2881	4554 Westlake	4520 Westlake Ct	12-22-95	9-20-95
	3+00	223.80	210.31	13.5		4" sch 40 3+69.1		2939		4552 Westlake		12-22-95	
		225.74	212.22 OUT	13.5	3+96.5	4" sch 40 3+60.9	4" SDR 35 3+53.5	3032	2979	4550 Westlake	4526 Westlake	8-8-96	4-15-96
		225.74	212.26 IN	13.5		4" SDR 35 4+26.5 Tap	4" sch 40 4+09.5	2960	2982	4546 Westlake	4530 N Westlake Ct	3-7-96	5-1-96
	4+00	225.70	212.31	13.4									
	5+00	229.20	213.69	15.5		5+02.5 4" SDR 35 4" sch 40 5+97.8	4" SDR 35 5+21.5 4" sch 40 5+85.5	3036	2926	4544 Westlake	4532 Westlake	8-14-96	12-5-95
	6+00	228.20	215.07	13.1				2953	2909	4542 Westlake Ct	4536 Westlake Ct	2-21-96	10-26-95
	7+00	227.90	216.46	11.4									
		227.59	216.69	10.9	7+16.8				3000		4536? Westlake Ct		6-5-96
Line 3	0+00 L-3	219.08	206.39 OUT	12.7	0+00			3517	2955	4540 Westlake	4533 Westlake	5-5-99	2-21-96
		219.08	208.33 IN	10.8									
	1+00	222.00	210.33	11.7		1+38.0 4" sch 40	4" SDR 35 1+08.0	3070	3035	4553 Westlake	4525 Westlake	12-6-96	8-14-96
	2+00	224.00	212.33	11.7				3038	2973	4549 Westlake	4529 Westlake	9-6-96	4-8-96
		225.40	214.25 OUT	11.1	2+95.1	4" sch 40 2+59.5	4" SDR 35 2+69.6 tap	2928	2961	4547 Westlake	4531 Westlake	12-4-95	3-7-96
		225.40	214.30 IN	11.1				2978		4543 Westlake		4-15-96	
	3+00	224.20	214.37	9.8			4" SDR 35 3+37.1		2944		4535 Westlake Ct		1-22-96
	4+00	226.90	216.14	10.8		4" SDR 35 4+11.7	4" SDR 35 3+82.7	3063	3001	4541 Westlake	4537 Westlake Ct	11-19-96	6-5-96
		227.60	216.65	11.0	4+54.7								
	96-203947	12-6-96			8542 w Central Repair	Repl 30' to 35' of Exist 4" sch 40 across Black top		4" sch 40 with Drive					

95-136107 8-30-95 8320 W Central - Repl 108' of 6" PVC with 6" SDR 35 from New MH Stub to Bldg connecting to Exist Bldg Sewer. ORig Conn shown in Sewer Book J 253