N-187A

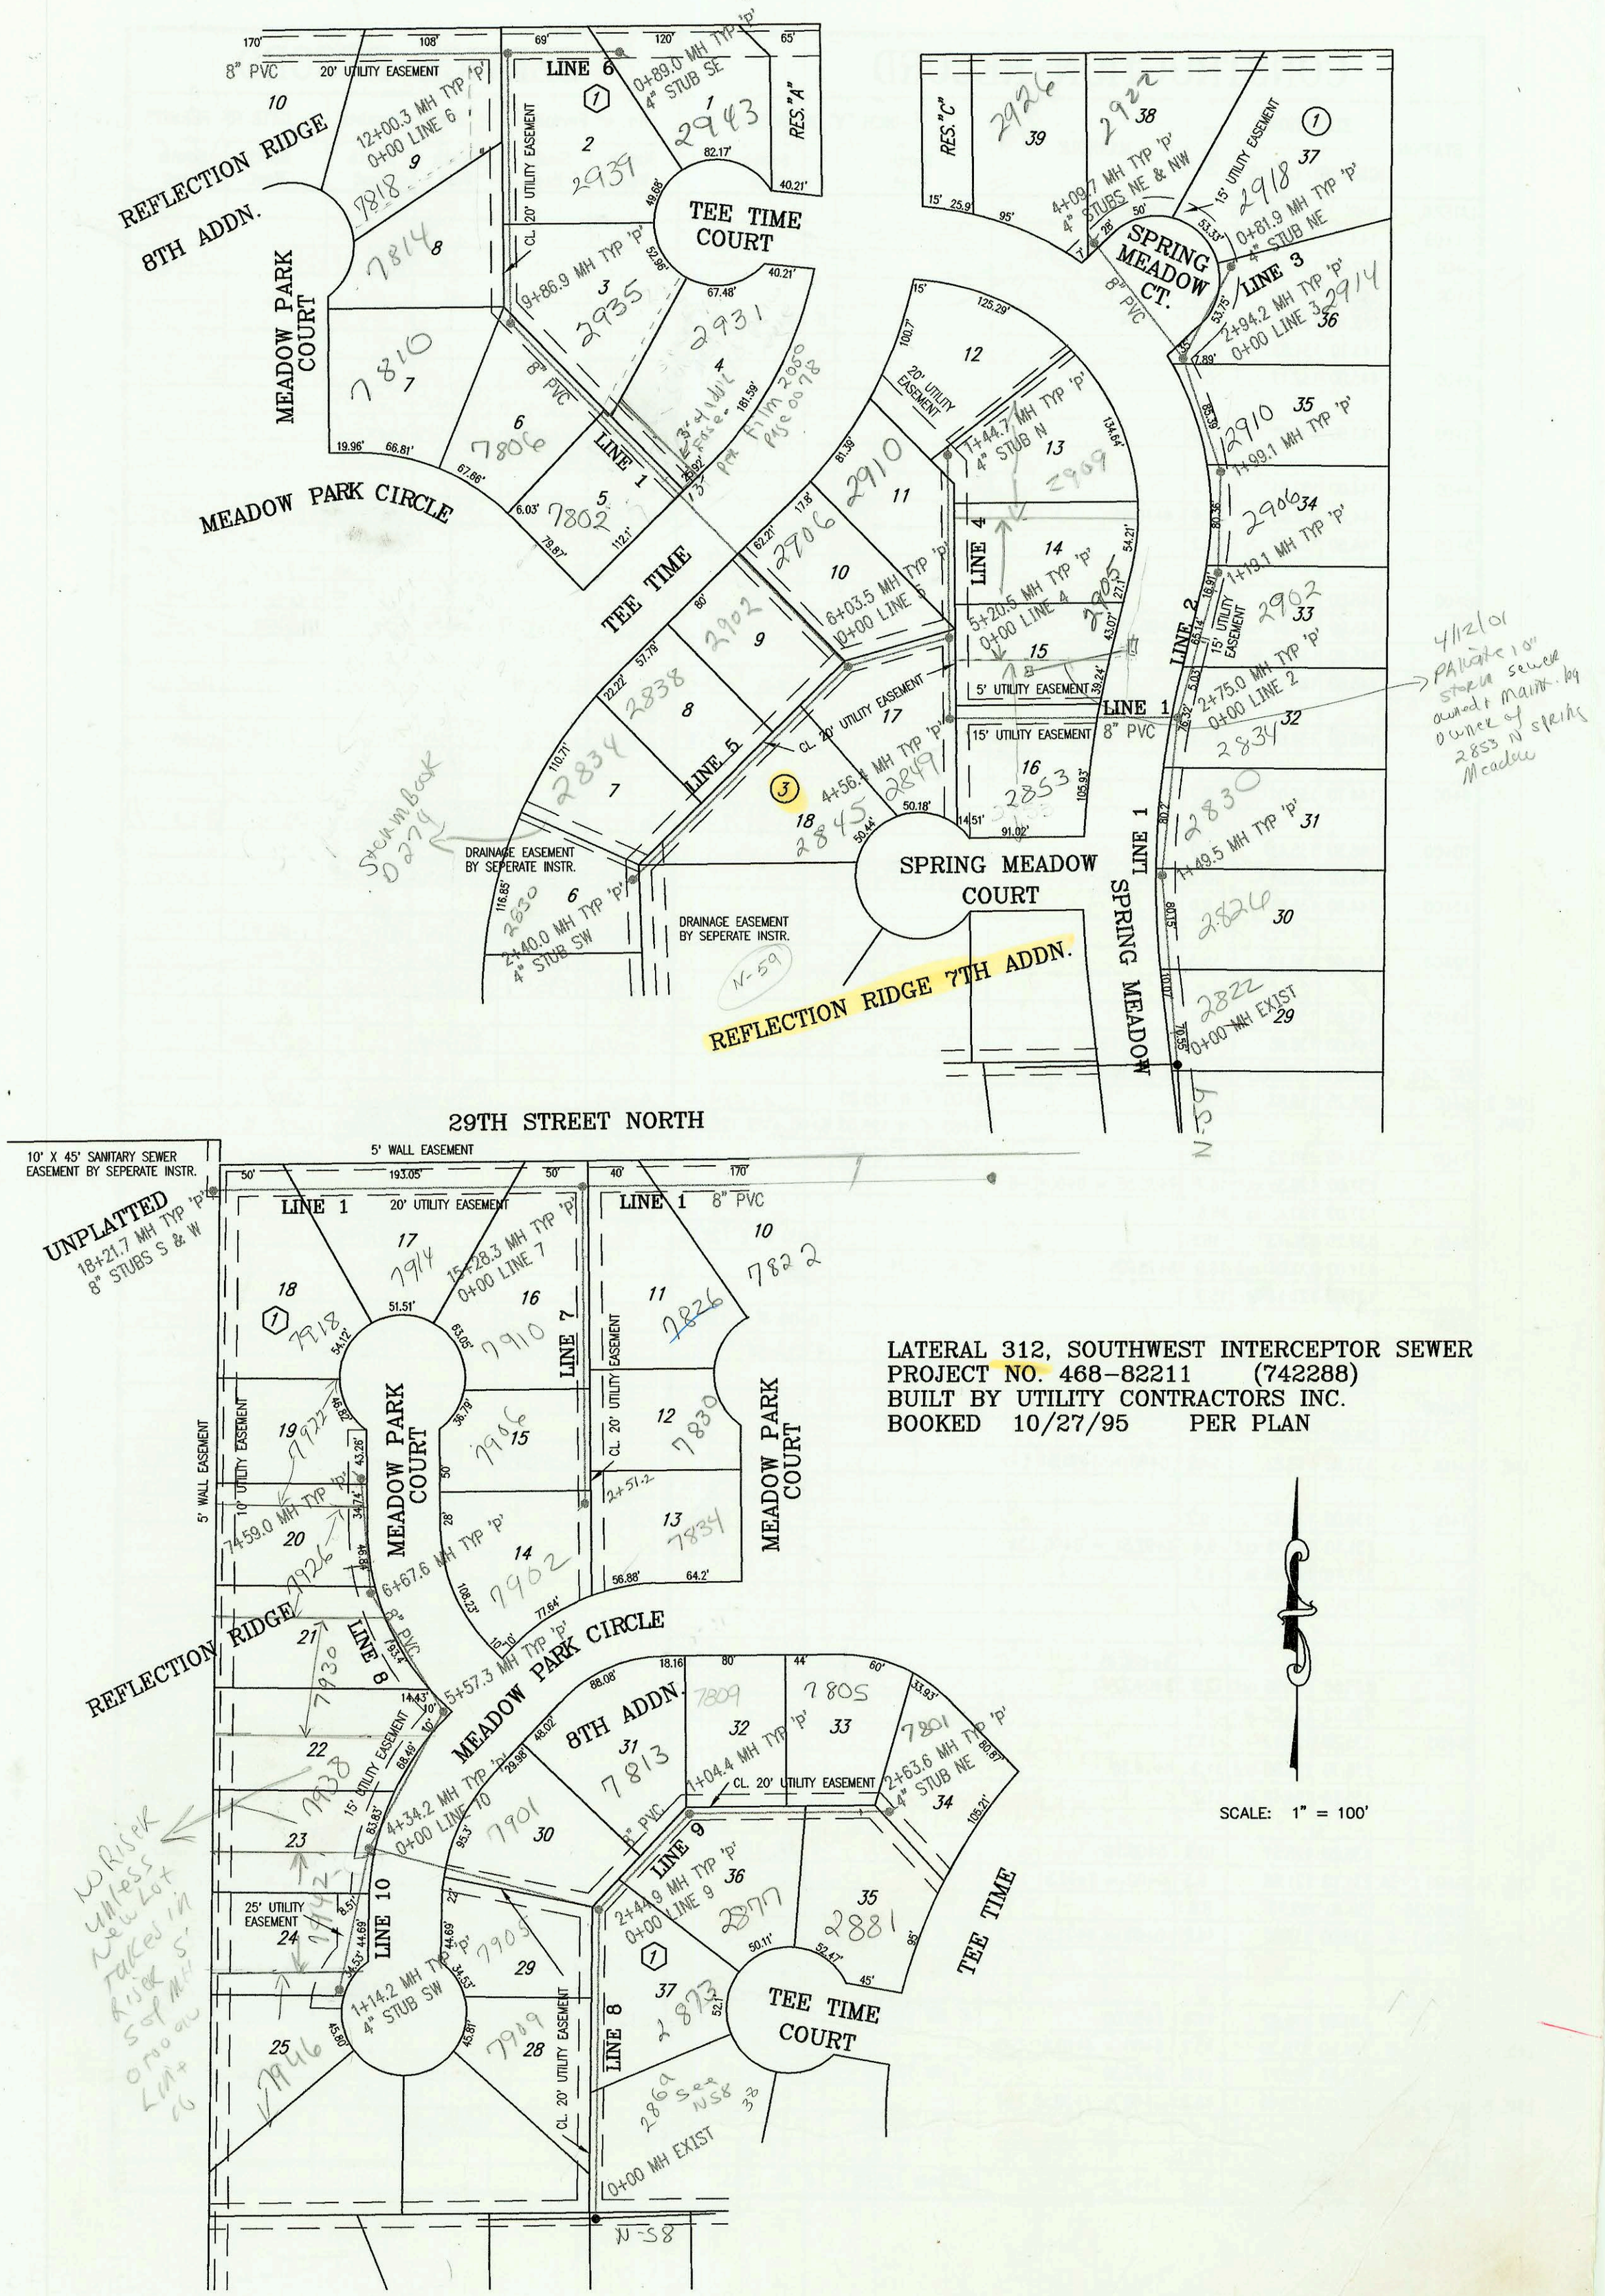
29TH STREET NORTH
REFLECTION RIDGE 8TH ADDN.
MEADOW PARK COURT
MEADOW PARK CIRCLE
TEE TIME COURT
TEE TIME
LINE 1
LINE 2
LINE 3
LINE 4
LINE 5
LINE 6
LINE 7
LINE 8
LINE 9
LINE 10
SPRING MEADOW CT.
SPRING MEADOW COURT
SPRING MEADOW
REFLECTION RIDGE 7TH ADDN.
DRAINAGE EASEMENT BY SEPERATE INSTR.
20' UTILITY EASEMENT
15' UTILITY EASEMENT
5' UTILITY EASEMENT
CL. 20' UTILITY EASEMENT
8" PVC
RES. "A"
RES. "C"
UNPLATTED
5' WALL EASEMENT
10' X 45' SANITARY SEWER EASEMENT BY SEPERATE INSTR.
25' UTILITY EASEMENT
LATERAL 312, SOUTHWEST INTERCEPTOR SEWER
PROJECT NO. 468-82211 (742288)
BUILT BY UTILITY CONTRACTORS INC.
BOOKED 10/27/95 PER PLAN
SCALE: 1" = 100'

N-187

	CONSTRUCTION RECORD							SERVICE RECORD					
	STATION	ELEVATION GROUND	ELEVATION GRADE	DEPTH	MANHOLE	4-INCH "Y" BRANCHES North West	4-INCH "Y" BRANCHES South East	No. of Permit North West	No. of Permit South East	House Number North West	House Number South East	DATE OF PERMITS North West	DATE OF PERMITS South East
	LATERAL 312, SW. INTERCEPTOR												
LINE 1	0+00 L-1	143.30	134.21	9.1	0+00 EXIST								
							4" SCH40 0+25 4" E (5'V 8'H)		98-10627-7		2822 Spring Meadow		6-2-98
	1+00	143.00	134.51	8.5			~~1+05 4" E (5'V 6'H)~~ 4" SCH40 TAP 1+35.5		98-14687		2826 Spring Meadow		8-10-98
		143.70	134.66	9.0	1+49.5								
	2+00	143.40	134.81	8.6			1+80 4" E (5'V 7'H)		99-16752		2830 Spring Meadow		1-11-99
		143.20	135.04 out	8.2	2+75.0 = 0+00 L-2		4" SCH40 2+55 4" E (4'V 8'H)		2000-02840		2834 Spring Meadow		8-16-00
		143.20	135.14 in	8.1									
	3+00	142.50	135.22	7.3									
							3+70 4" S (4'V 3'H)						
	4+00	143.30	135.52	7.8			4" SCH40 4+19. SADDLE		2000-02426		2853 Spring Meadow		11-7-00
		143.90	135.68 out	8.2	4+56.4								
		143.90	135.78 in	8.1									
	5+00	142.70	135.91	6.8									
		142.70	135.97 out	6.7	5+20.5 = 0+00 L-4	4" SCH40 4+94.5							
		142.70	136.07 in	6.6				99-01409	1999-004691	2906 TeeTime	2849 Spring Meadow	12-7-99	8-20-99
	6+00												
		144.80	136.32 out	8.5	6+03.9 = 0+00 L-5								
		144.80	136.42 in	8.4									
	7+00	146.80	136.71	10.1									
						4" SCH40 8+21.9 Saddle	4" SCH40 8+53.9	2000-02581	2000-00925	2931 TeeTime	7802 Meadow Pk	11-27-00	4-4-00
	8+00	147.40	137.01	10.4									
									99-23697		7806 Meadow Park		2-11-99
	9+00	146.10	137.31	8.8									
		145.40	137.57 out	7.8	9+86.9			99-34367		7814 Meadow Park		2-22-99	
		145.50	137.67 in	7.8		4" SCH40 10+11.5		2000-00510		7810 Meadow Pk		2-25-00	
	10+00	144.80	137.71	7.1									
	11+00	146.30	138.01	8.3					2001-03019		2935 TeeTime		11-29-01
	12+00								SWR 1999-00053		2939 TeeTime Ct		6-26-99
		145.80	138.31 out	7.5	12+00.3 = 0+00 L-6								
		145.80	138.41 in	7.4					99-16307		7818 Meadow Pk		1-11-99
	13+00	146.00	138.71	7.3									
									2003-01660		7822 Meadow Pk		6-24-03
	14+00	146.70	139.01	7.7									
	15+00	147.40	139.31	8.1									
		147.80	139.39	8.4	15+28.3 = 0+00 L-7								
	16+00	147.90	139.61	8.3									
	17+00	148.70	139.91	8.8									
	18+00	149.40	140.21	9.2					2004-01262		7918 Meadow Pk		5-4-04
		149.80	140.28	9.5	18+21.7	8" W 140.28	8" S 140.48						
LINE 2	0+00 L-2	143.20	135.14	8.1	0+00 = 2+75 L-1								
							0+65 4" E (4'V 7'H)						
	1+00	143.00	135.44	7.6			4" SCH40 1+05		2000-01562		2902 N Spring Meadow		7/6/00
		143.40	135.50	7.9	1+19.1		4" SCH40 1+88.1 Saddle		2001-00286		2906 N Spring Meadow		2-8-01
							1+60 4" E (4'V 7'H)						
		143.80	135.74	8.1	1+99.1		4" SCH40 2+21.1		99-01445		2910 Spring Meadow		12-13-99
	2+00												
		143.00	136.02	7.0	2+94.2 = 0+00 L-3								
	3+00	143.00	136.04	7.0									
	4+00	143.20	136.34	6.9		4" SCH40							
		143.30	136.37	6.9	4+09.7	4" NW 136.7	4" NE 136.7	98-38067	2003-00317	2924 Spring Meadow	2922 Spring Meadow	3-11-99	2-5-03
LINE 3	0+00 L-3	143.00	136.12	6.9	0+00 = 2+94.2 L-2				98-25797		2914 Spring Meadow		2-19-98
		143.90	136.37	7.5	0+81.9	~~4" NE 136.7~~ →	4" NE 136.7		99-39647		2918 Spring Meadow		2-19-98
LINE 4	0+00 L-4	142.70	136.07	6.6	0+00 = 5+20.5 L-1								
							4" SCH40 0+66		2000-02087		2905 Spring Meadow		9-21-00
	1+00	142.60	136.37	6.2		4" SCH40 1+14.7	4" SCH40 1+40.7 Saddle	2000-00801	2000-00716	2910 TeeTime	2909 Spring Meadow	3-24-00	3-30-01
		143.60	136.50	7.1	1+44.7	4" N 136.83							
LINE 5	0+00 L-5	144.80	136.42	8.4	0+00 = 6+03.9 L-1	4" SCH40 0+60.6		99-01537		2902 TeeTime		12-27-99	
	1+00	145.90	136.72	9.2		4" SCH40 1+40 TAP		98-10621-7		2838 TeeTime		6-2-98	
								98-11012-M		2834 TeeTime		6-19-98	
	2+00	145.00	137.02	8.0					99-59067		2845 Spring Meadow		4-1-99
		145.40	137.14	8.3	2+40.0	4" SCH40 4" Stub SW 137.47	~~4" SW 137.47~~	98-6249-7		2839 TeeTime		4/16/98	
	CONT. ON N-186												