N-198A

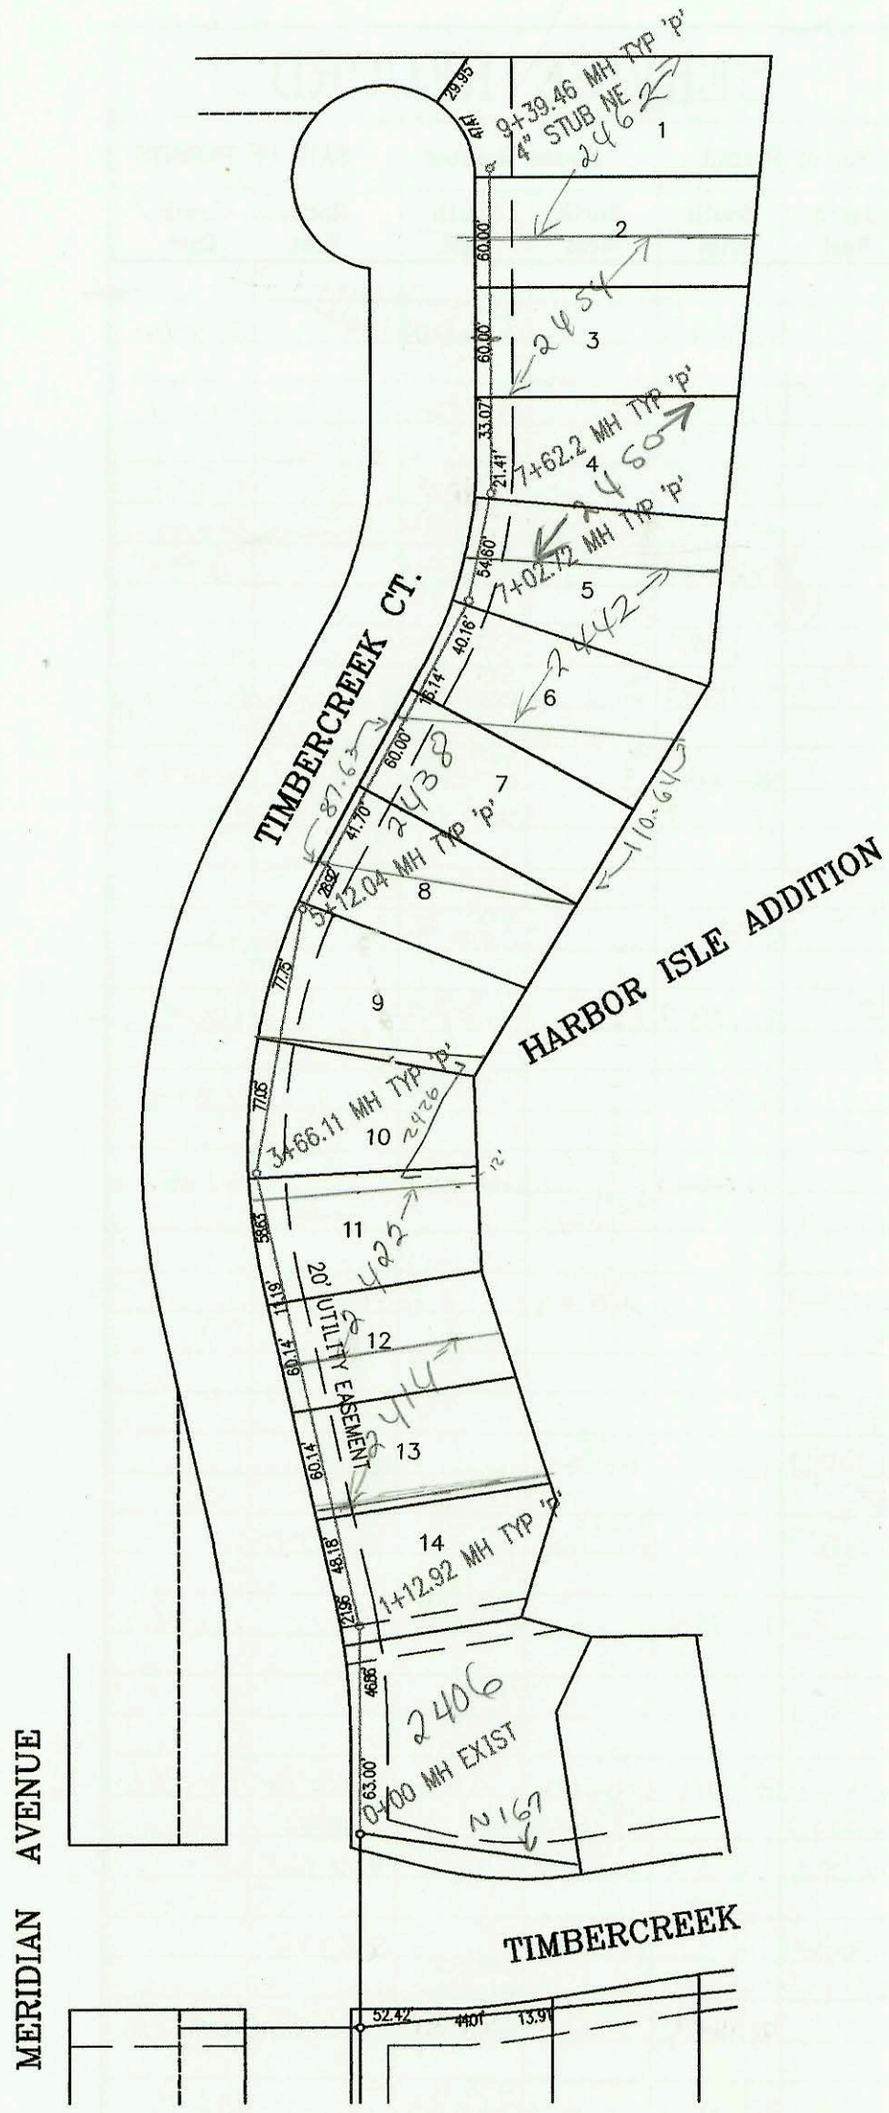

SCALE: 1" = 100'

LATERAL 84, SANITARY SEWER NO. 23
PROJECT NO. 468-82408 (742312)
BUILT BY W. B. CARTER CONSTRUCTION CO.
BOOKED 1/10/96 PER PLAN

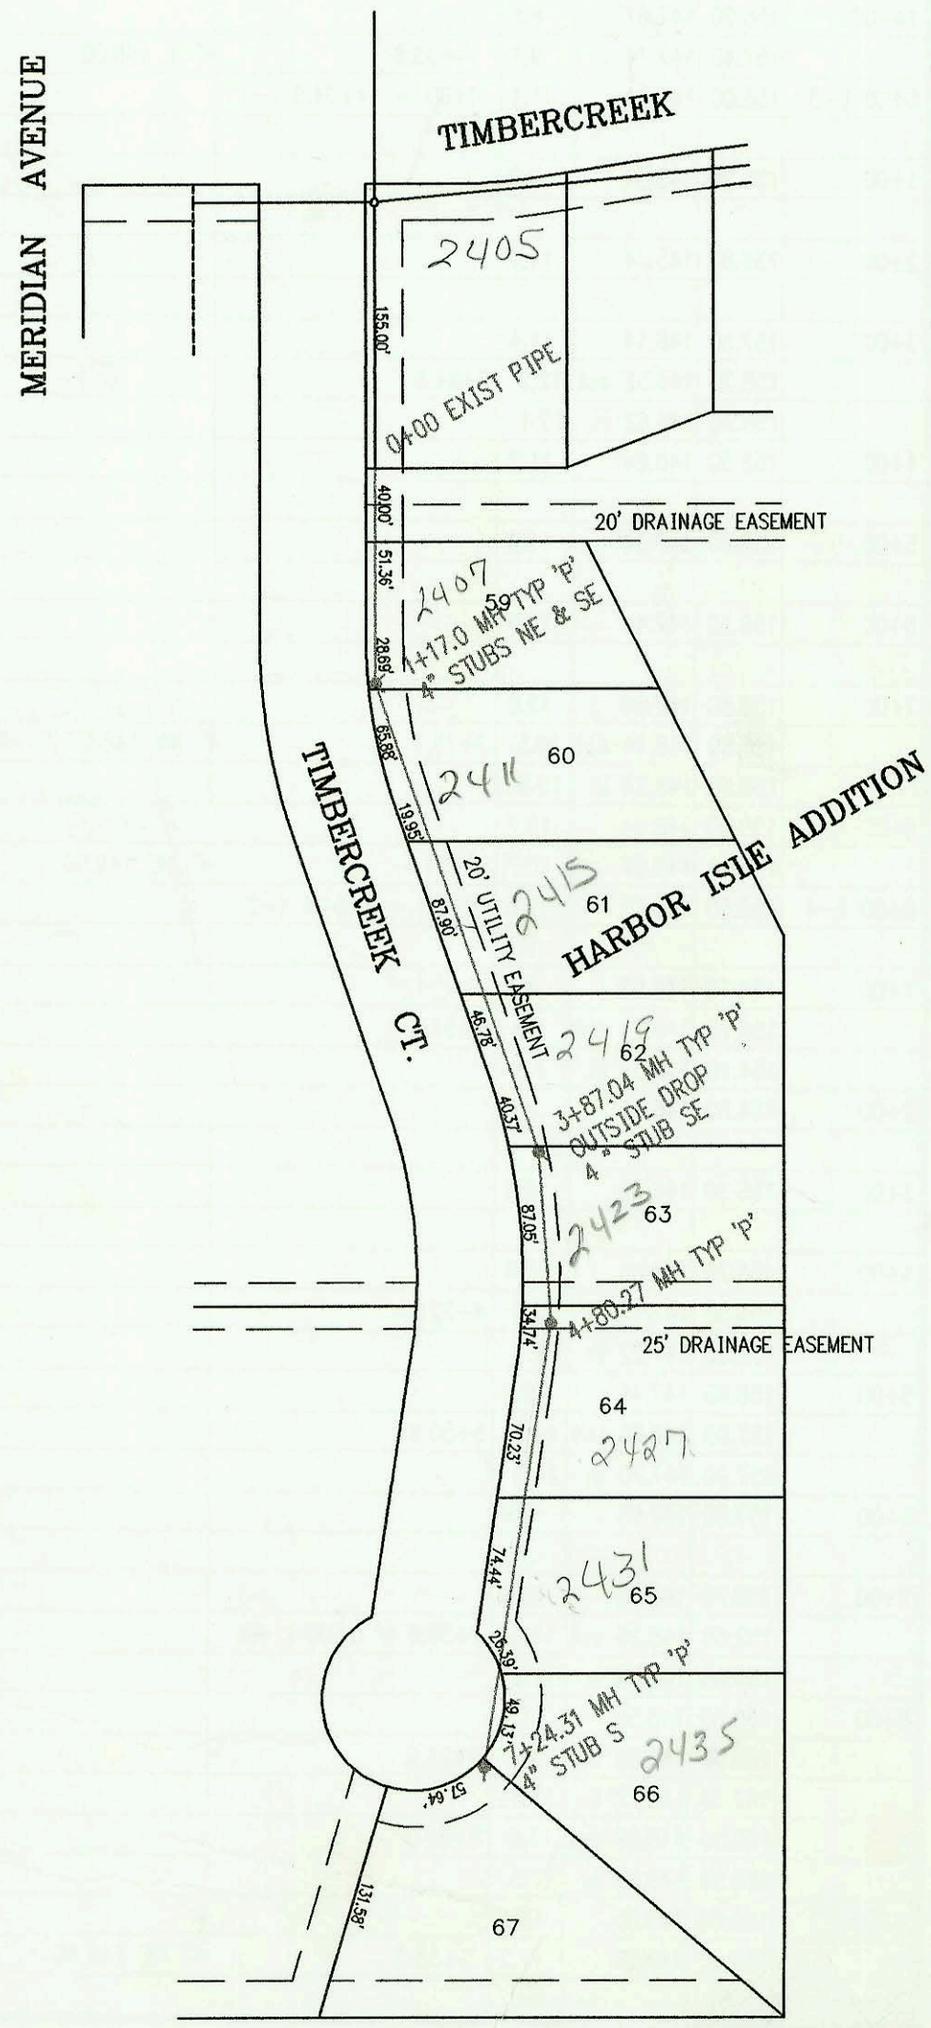

N-198

	CONSTRUCTION RECORD							SERVICE RECORD					
	STATION	ELEVATION GROUND	ELEVATION GRADE	DEPTH	MANHOLE	4-INCH "Y" BRANCHES North West	4-INCH "Y" BRANCHES South East	No. of Permit North West	No. of Permit South East	House Number North West	House Number South East	DATE OF PERMITS North West	DATE OF PERMITS South East
	LATERAL 84, SANITARY SEWER NO. 23												
LINE 1	0+00 L-1	142.50	131.50	11.0	0+00 EXIST								
	1+00	140.80	131.80	9.0									
		141.20	131.84 out	9.4	1+12.92								
		141.20	131.94 in	9.3					99-		2414 Timberlaneck	3-31-99	
	2+00	140.80	132.20	8.6									
									99-34337		2422 Timberlaneck	2-24-99	
	3+00	141.00	132.50	8.5									
		141.60	132.70 out	8.9	3+66.11				98-21450-7		2426 Timberlaneck	11-9-98	
		141.60	132.80 in	8.8									
	4+00	141.30	132.90	8.4									
	5+00	141.50	133.20	8.3									
		142.10	133.24 out	8.9	5+12.04								
		142.10	133.34 in	8.8			4" sch40 5+50		9755868-7		2438 Timberlaneck Ct	8-25-97	
	6+00	142.10	133.60	8.5									
									5-8 1999-00086		2442 Timberlaneck Ct	6-29-99	
	7+00												
		143.20	133.91 out	9.3	7+02.72								
		143.20	134.01 in	9.2									
		143.30	134.19 out	9.1	7+62.20				2000 09769		2450 Timberlaneck	9-5-00	
		143.30	134.29 in	9.0			4" SCH40 7+39.7						
	8+00	142.80	134.40	8.4			4" SCH40 8+47.5 Saddle		2000 02203		2454 Timberlaneck	10-9-00	
	9+00	143.20	134.70	8.5									
		143.80	134.82	9.0	9+39.46	4" NE 135.15 4" SCH 40		2000 00728		2462 Timberlaneck Ct		3-20-00	
LINE 2	0+00 L-2	141.20	126.67	14.5									
	1+00	139.60	126.97	12.6									
		139.30	127.02 out	12.3	1+17.0	4" NE 128.5	4" SE 128.5	98-20683-7	98-18231-7	2407 Timberlaneck Ct	2411 Timberlaneck Ct	10-22-98	9-24-98
		139.30	127.37 in	11.9									
	2+00	140.00	127.70	12.3									
							2+55 4" E 131.50		98-3778-7		2415 Timberlaneck	3-3-98	
	3+00	140.30	128.10	12.2					97-14966-7		2419 Timberlaneck	8/27/97	
		141.30	128.45 out	12.9	3+87.04		4" SE 130.5		99-8-7		2423 Timberlaneck Ct	12-21-98	
		141.30	133.37 in	7.9									
	4+00	140.70	133.42	7.3									
		141.80	133.74 out	8.1	4+80.27								
		141.80	133.84 in	8.0									
	5+00	141.50	133.92	7.6			4" sch40 5+33.3		96259-7		2427 Timberlaneck Ct	1-9-96	
	6+00	141.40	134.32	7.1					98-7504-7		2431 Timberlaneck	4-30-98	
									98-45546-7		2435 Timberlaneck Ct	3-25-98	
	7+00	141.40	134.32	7.1									
		142.20	134.82	7.4	7+24.31		4" S 135.15						
	LATERAL 349, SWI (Cont. from N-199)												
LINE 4A	0+00 L-4A	159.60	148.36	11.2	0+00 = 7+36.9 L-4								
	0+82.6	160.00	149.31	10.7	RISER W/ 4" DB. WYE			97-11470-7	97-18448-7	1018 Cedar Pk Dr	1014 Cedar Pk	7-1-97	10-9-97
LINE 5	0+00 L-5	158.70	146.62	12.1	0+00 = 3+94.6 L-3								
	1+00	158.70	146.92	11.8									
	2+00	158.70	147.22	11.5									
	2+20	158.70	147.28	11.4	PLUG								