N-226 A

LATERAL 69, MAIN 5, SANITARY SEWER NO. 23
PROJECT NO. 468-82570 (742684)
BUILT BY W. B. CARTER CONSTRUCTION CO.
BOOKED 9/26/96 PER PLAN

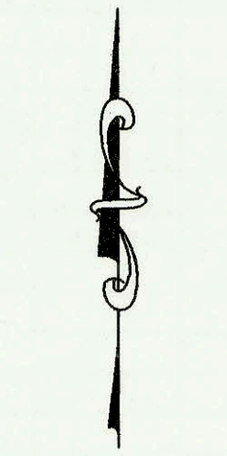

SCALE: 1" = 100'

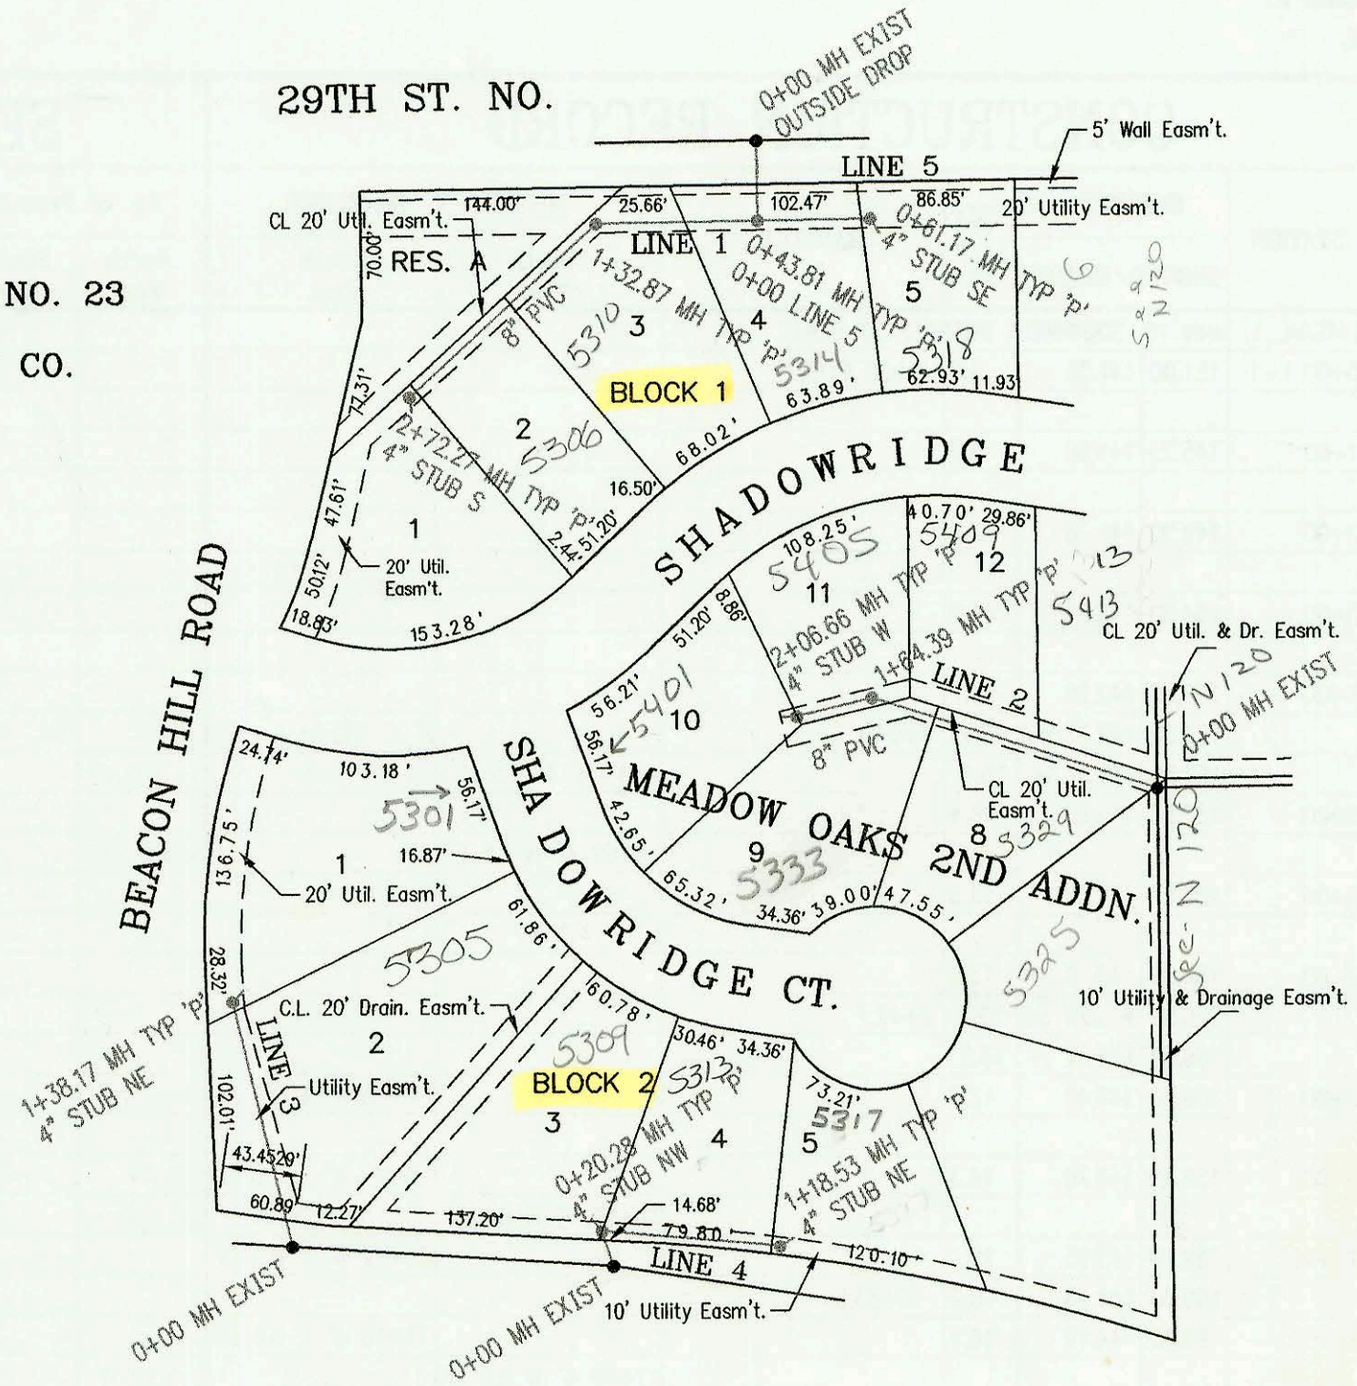

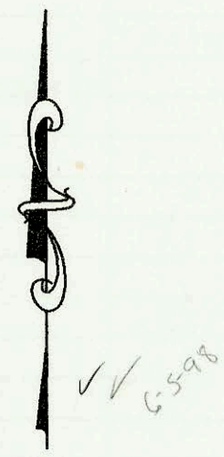

SCALE: 1" = 100'

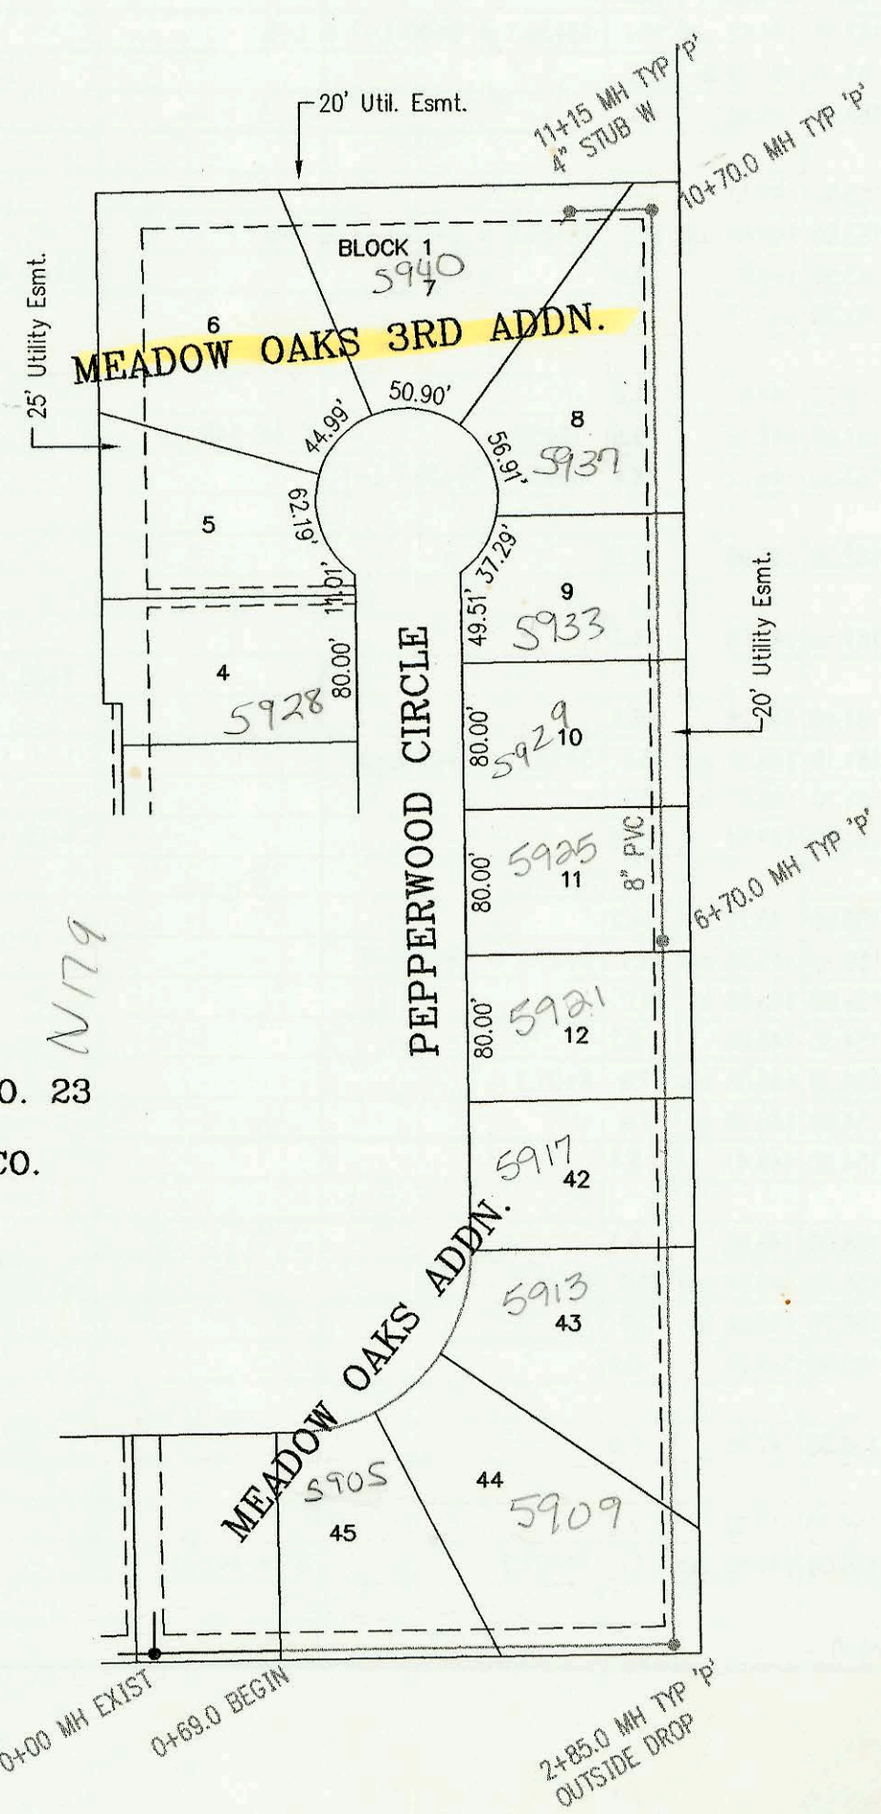

LATERAL 69, MAIN 5, SANITARY SEWER NO. 23
PROJECT NO. 468-82571 (742676)
BUILT BY W. B. CARTER CONSTRUCTION CO.
BOOKED 9/26/96 PER PLAN

N-226

CONSTRUCTION RECORD

SERVICE RECORD

	STATION	ELEVATION GROUND	ELEVATION GRADE	DEPTH	MANHOLE	4-INCH "Y" BRANCHES North West	4-INCH "Y" BRANCHES South East	No. of Permit North West	No. of Permit South East	House Number North West	House Number South East	DATE OF PERMITS North West	DATE OF PERMITS South East
	LATERAL 68,	MAIN 5,	SANITARY SEWER		NO. 23								
LINE 1	0+00 L-1	163.50	145.05 out	18.4	0+00 EXIST								
		163.50	153.38 in	10.1	OUTSIDE DROP								
		164.70	153.56 out	11.1	0+43.81 = 0+00 L-5								
		164.70	153.66	11.0									
	1+00	164.20	153.88	10.3									
		164.40	154.01 out	10.4	1+32.87		4" SCH40 PVC Saddle 1+59.87		2001-00259		5310 Shadowridge		2-6-01
		164.40	154.11 in	10.3									
	2+00	164.00	154.38	9.6					2001-02155		5306 Shadowridge		8-29-01
		164.00	154.67	9.3	2+72.27		4" S 157.00		2001 02718		5302 Shadowridge		10-29-01
LINE 2	0+00 L-2	163.50	156.93	6.6	0+00 EXIST								
								97140797		5329 E Shadowridge		8-12-97	
	1+00	163.60	157.33	6.3				2001-00177		5401 Shadowridge Ct		5-2-03	
		164.40	157.59	6.8	1+64.39			1999-431		5405 Shadowridge		8-16-99	
	2+00								98-3877		5333 Shadowridge Ct		2-19-98
		164.60	157.76	6.8	2+06.66	4" W 158.09 4" SCH40		2001-00260		5401E Shadowridge		2-6-01	
LINE 3	0+00 L-3	161.60	148.95 out	12.7	0+00 EXIST								
		161.60	150.95 in	10.7									
	1+00	162.50	152.95	9.6					2001-02154		5305 E Shadowridge		8-29-01
		163.10	153.71	9.4	1+38.17	4" NE 154.04		2001 0277		5301 Shadowridge		10-29-01	
LINE 4	0+00 L-4	162.60	149.63 out	13.0	0+00 EXIST								
		162.60	151.63 in	11.0									
		163.00	152.24 out	10.8	0+20.28	4" NW 154.94		98-110157		5309 E Shadowridge Ct		6-14-98	
		163.00	153.24 in	9.8									
	1+00	163.00		163.0		4" SCH40 0+52.28		2000-00087		5313 Shadowridge Ct		1-12-2000	
		163.60	155.00	8.6	1+18.53	4" NE 155.33		99-00666		5317 Shadowridge Ct		9-14-99	
LINE 5	0+00 L-5	164.70	153.66	11.0	0+00 = 0+43.81 L-1				2000-02278		5314 Shadowridge		10-17-00
		164.90	155.50	9.4	0+61.17		4" SE 155.83		2002 02175		5318 Shadowridge		8-12-02
	LATERAL 69,	MAIN 5,	SANITARY SEWER		NO. 23								
	0+00 L-1	173.00	163.41	9.6	0+00 EXIST								
	0+69.0	173.00	163.69	9.3	BEGIN	4" SCH40 1+22		2000-00071		5905 Pepperwood		11-2000	
	1+00	173.30	163.81	9.5									
						4" SCH40 2+10.4		2000-00072		5909 Pepperwood		11-2000	
	2+00	174.60	164.21	10.4									
		179.90	164.55 out	15.3	2+85.0								
		179.90	167.75 in	12.1									
	3+00	179.60	167.83	11.8		4" SCH40 4+29.0		2000-016667		5913 Pepperwood		7-20-00	
	4+00	179.90	168.33	11.6									
	5+00	179.70	168.83	10.9									
						4" SCH40 5+26.0		2000-016668		5917 Pepperwood		7-20-00	
	6+00	179.80	169.33	10.5		4" SCH40 6+31.0		2000-016669		5921 Pepperwood		7-20-00	
		180.30	169.68	10.6	6+70.0	4" SCH40 6+78.0		2000-01670		5925 Pepperwood		7-20-00	
	7+00	180.30	169.83	10.5									
	8+00	181.50	170.33	11.2									
	9+00	182.00	170.83	11.2									
	10+00	181.00	171.33	9.7				97-103407		5933 Pepperwood		6-1897	
		180.40	171.68	8.7	10+70.0								
		180.40	171.78	8.6				97-10335-7		5937 E Pepperwood		6-18-97	
	11+00	180.00	171.93	8.1									
		180.30	172.00	8.3	11+15.0	4" W 173.31		97-10333-7		5940 Pepperwood Ct		6-18-97	