N-241A

LATERAL 13, MAIN 13, SOUTHWEST INTERCEPTOR SEWER
PROJECT NO. 468-82611 (742734)
BUILT BY NOWAK CONSTRUCTION CO.
BOOKED 1/21/97 PER PLAN

N 265

SCALE: 1" = 100'

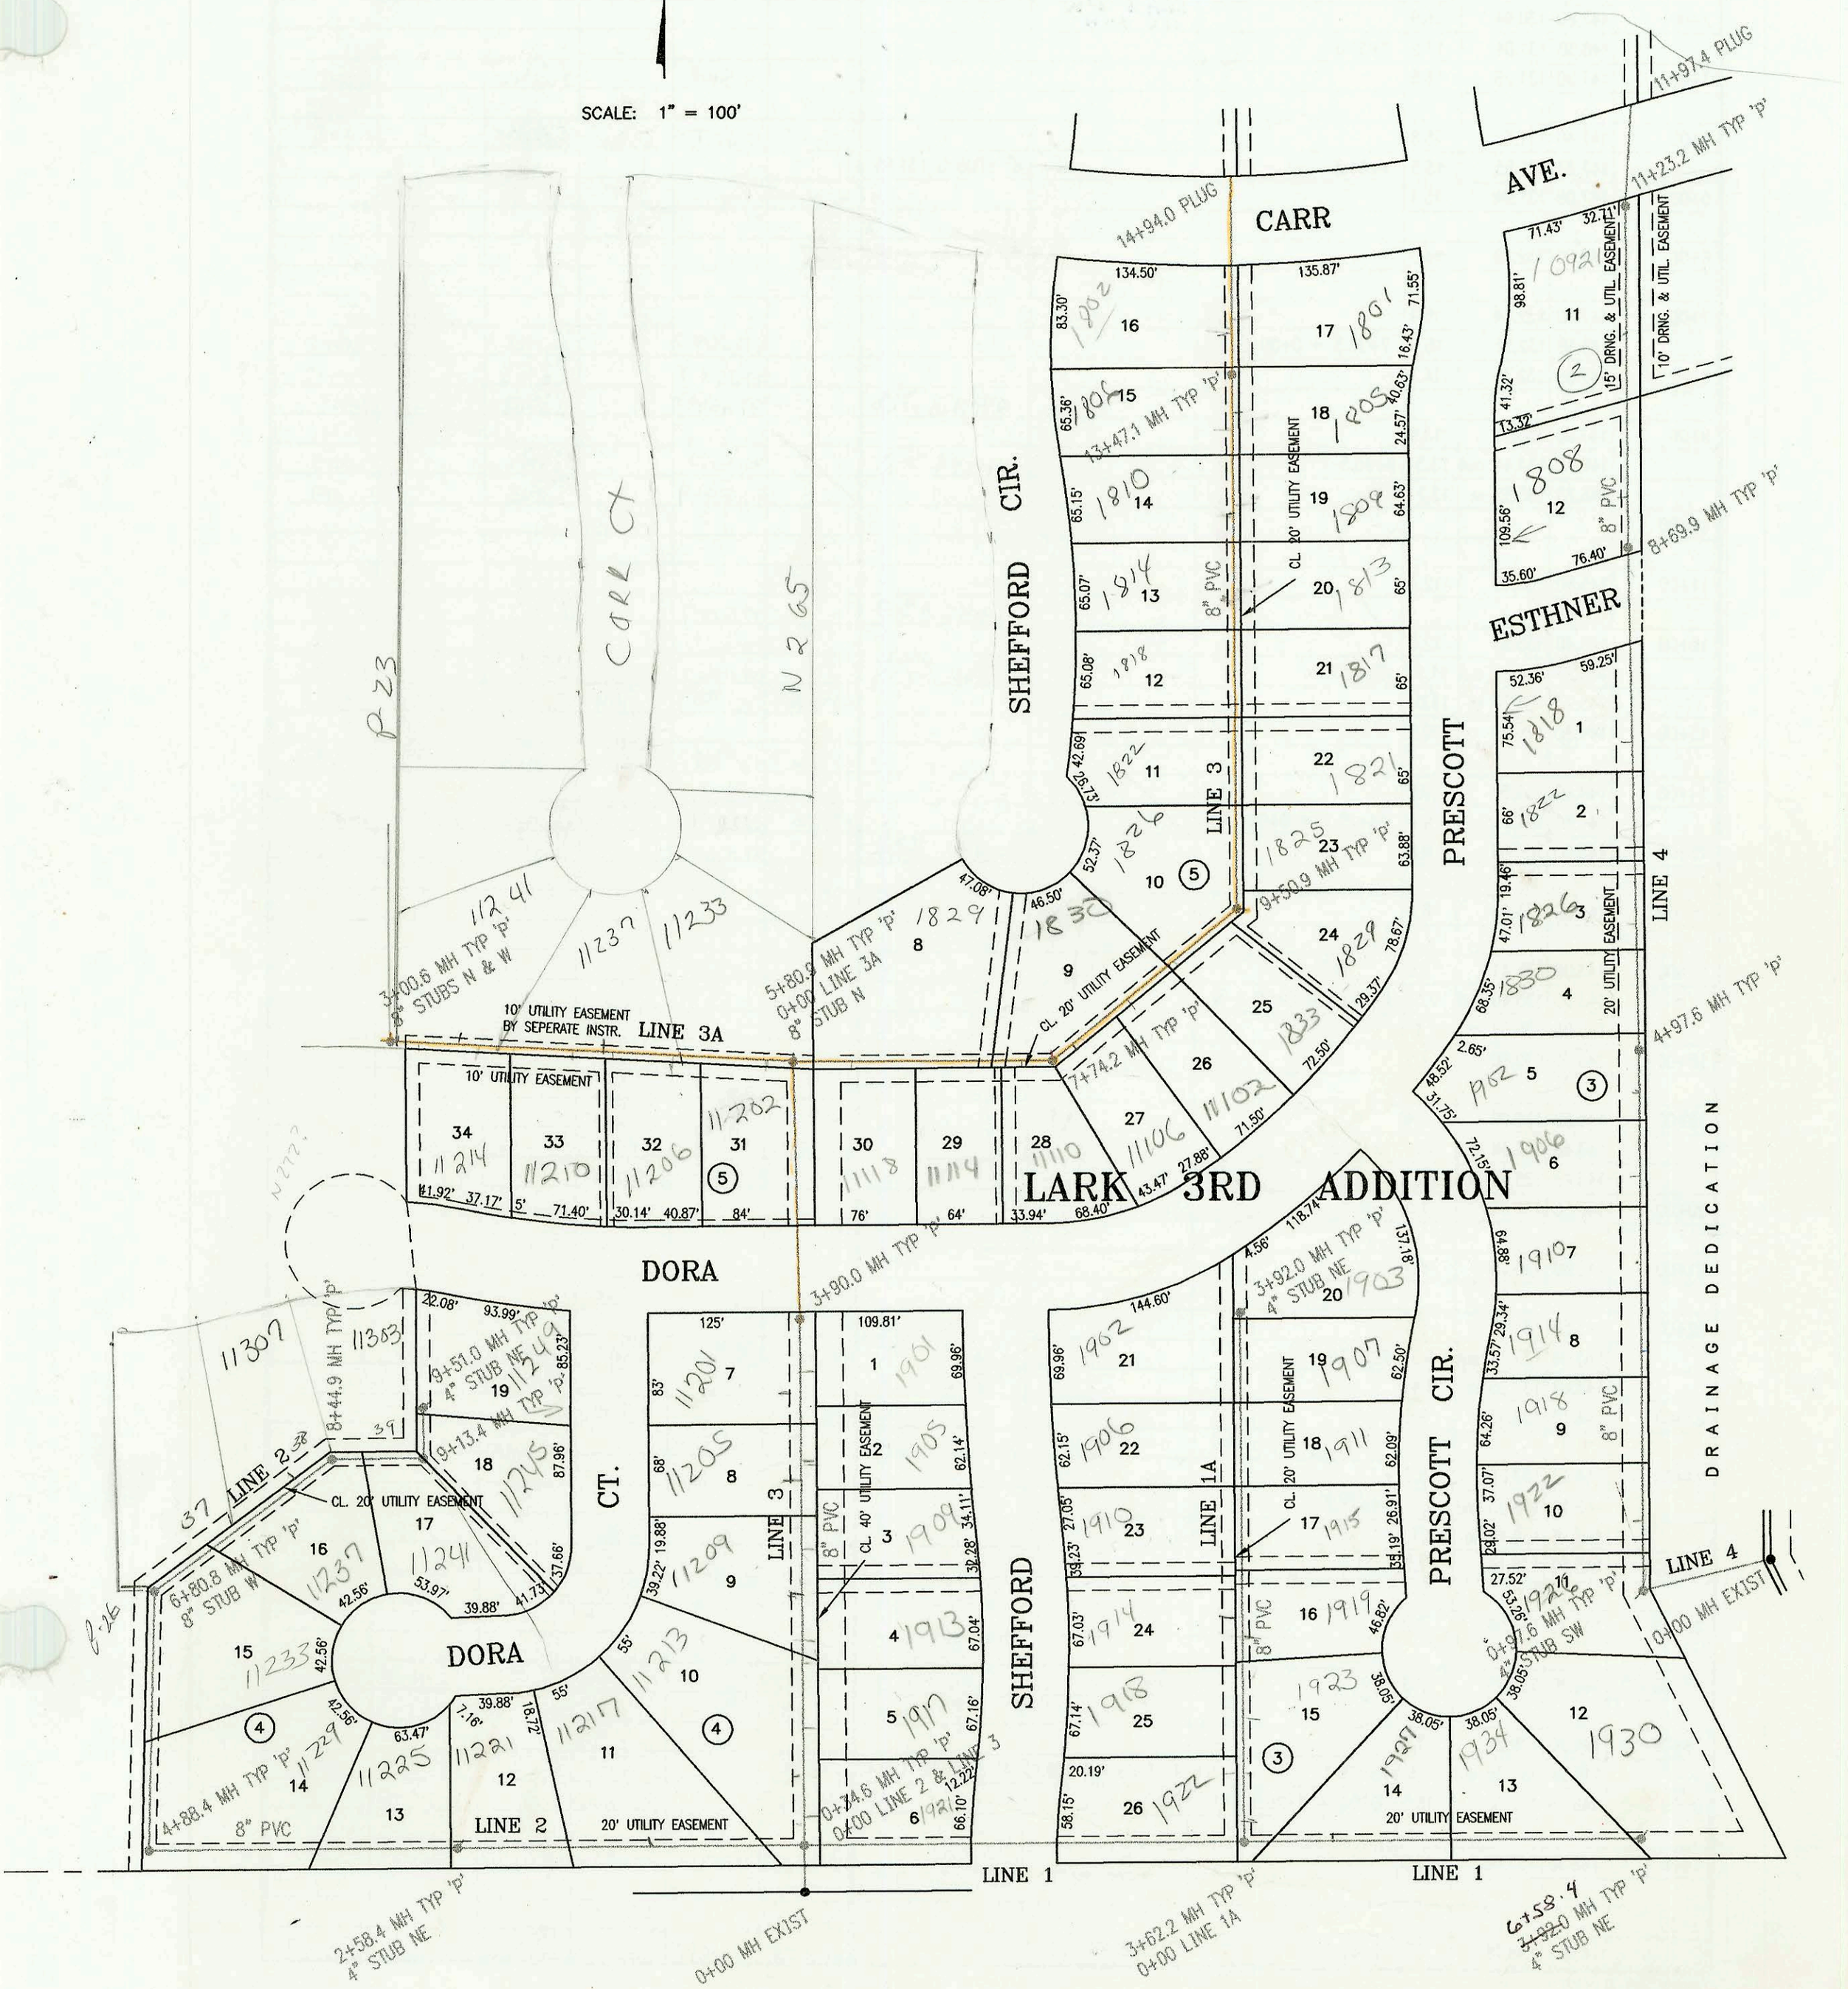

N-241

CONSTRUCTION RECORD							SERVICE RECORD					
STATION	ELEVATION GROUND	ELEVATION GRADE	DEPTH	MANHOLE	4-INCH "Y" BRANCHES North West	4-INCH "Y" BRANCHES South East	No. of Permit North West	No. of Permit South East	House Number North West	House Number South East	DATE OF PERMITS North West	DATE OF PERMITS South East
LATERAL 13, MAIN 13, SOUTHWEST INTERCEPTOR SEWER (CONT. FROM N-240)												
8+00	144.00	132.61	11.4			7+93 4" S 136.1 4" sch 40		97-8930-7		1106 Dora		6-2-97
						8+46 4" S 136.3		97-11445-7		1107 Dora		7-1-97
9+00	144.90	132.91	12.0			8+87.3 TAP 4" sch 40	98-5808-7	97-92547	1826 Sheffield	1833 Prescott	4-9-98	6-2-97
	145.80	133.06 out	12.7	9+50.9	4" E 145.80 4" sch 40			97-88867		1829 Prescott		6-2-97
	145.80	133.16 in	12.6									
10+00	144.90	133.31	11.6				98-7442-7	97-113660-7	1822 Sheffield	1821 Prescott	4-30-98	7-1-97
								97-13209-7		1825 Prescott		7-30-97
11+00	144.40	133.61	10.8			11+07.9 4" sch 40	97-19764-7	97-92127	1818 Sheffield	1811 Prescott	11-4-97	6-2-97
					11+79 4" W 137.4	11+89 4" E 137.4 4" sch 40	97-21370-7	97-113641-7	1814 Sheffield	1813 Prescott	12-5-97	7-1-97
12+00	145.40	133.91	11.5									
					12+44 4" W 138.0	12+54 4" E 138.0 4" sch 40	97-19795-7	97-105837	1810 Sheffield	1809 Prescott	11-4-97	6-24-97
13+00	145.40	134.21	11.2		13+09 4" W 138.7	13+19 4" E 138.7	98-3677-7	97-184587	1806 Sheffield	1805 Prescott	12-31-97	10-9-97
	145.60	134.35 out	11.3	13+47.1								
	145.60	134.45 in	11.2									
14+00	144.50	134.61	9.9		13+77 4" W 139.0	13+87 4" E 139.0 4" sch 40	97-22160-7	97-58757	1802 Sheffield Ct	1801 Prescott	12-17-97	4-16-97
14+94.0	143.80	134.89	8.9	PLUG								
0+00 L-3A	143.60	126.61	17.0	0+00 = 5+80.9 L-3								
					0+35 4" N 135.7	0+20 4" S 136.2 4" sch 40		97-54097		11202 Dora		6-10-97
1+00	143.20	126.91	16.3			0+90 4" S 135.9		97-18457		11206 Dora		10-9-97
					1+41 4" N 135.5	1+65 4" S 135.6		97-114467		11210 Dora		7-1-97
2+00	143.50	127.22	16.3									
					2+50 4" N 135.9	2+36 4" S 135.8 Riser 2+40.6 4" sch 40	99-5281-7	97-96411-7	11241 Carrot	11214 Dora	3-25-99	6-11-97
3+00												
	144.10	127.52	16.6	3+00.6	8" N 127.62	8" W 127.62						
0+00 L-4	144.50	126.10	18.4	0+00 EXIST								
	142.50	126.40 out	16.1	0+97.6	4" STUB SW 136.0 4" sch 40		97-11371-7		1926 Prescott		7-1-97	
	142.50	126.50 in	16.0									
1+00												
					1+50 4" W 136.1		97-18460-7		1922 Prescott Cir		10-9-97	
2+00	142.10	126.70	15.4		2+14 4" W 136.2							
					2+77 4" W 135.9 4" sch 40		97-12050-7		1914 Prescott		7-18-97	
3+00	142.10	126.90	15.2	Riser	3+39 4" W 135.5 4" sch 40		97-8886-7		1910 Prescott		6-2-97	
					4+03 4" W 135.1		98-3773-7		1906 Prescott		3-11-98	
4+00	142.10	127.10	15.0		4+67 4" W 135.2		97-18456-7		1902 Prescott Dr		10-9-97	
	142.50	127.30	15.2	4+97.6								
5+00					5+31 4" W 136.0		98-2026-7		1830 Prescott		2-9-98	
					5+93 4" W 136.1 4" sch 40		97-114113-7		1826 Prescott		7-1-97	
6+00	142.10	127.60	14.5									
					6+59 4" W 136.2		98-5496-9		1822 Prescott		4-8-98	
7+00	142.10	127.80	14.3									
					7+25 4" W 136.4		97-13971-7		1818 Prescott		8-11-97	
8+00	144.20	128.00	16.2									
	145.50	128.14 out	17.4	8+69.9								
	145.50	128.24 in	17.3									
9+00	145.20	128.30	16.9		9+08 4" W 137.3		97-18448-7		1808 Prescott		10-9-97	
10+00	145.50	128.50	17.0		10+29 4" W 138.6		97-11459-7		10921 Lark		7-1-97	
11+00	145.30	128.70	16.6									
	145.60	128.75 out	16.9	11+23.2								
	145.60	128.85 in	16.8									
11+97.4	145.20	129.00	16.2	PLUG								