N-257A

LATERAL 7, MAIN 16, SOUTHWEST INTERCEPTOR SEWER
PROJECT NO. 468-82622 (742908)
BUILT BY UTILITY CONTRACTORS, INC.
BOOKED 5/30/97 PER PLAN

SCALE: 1" = 100'

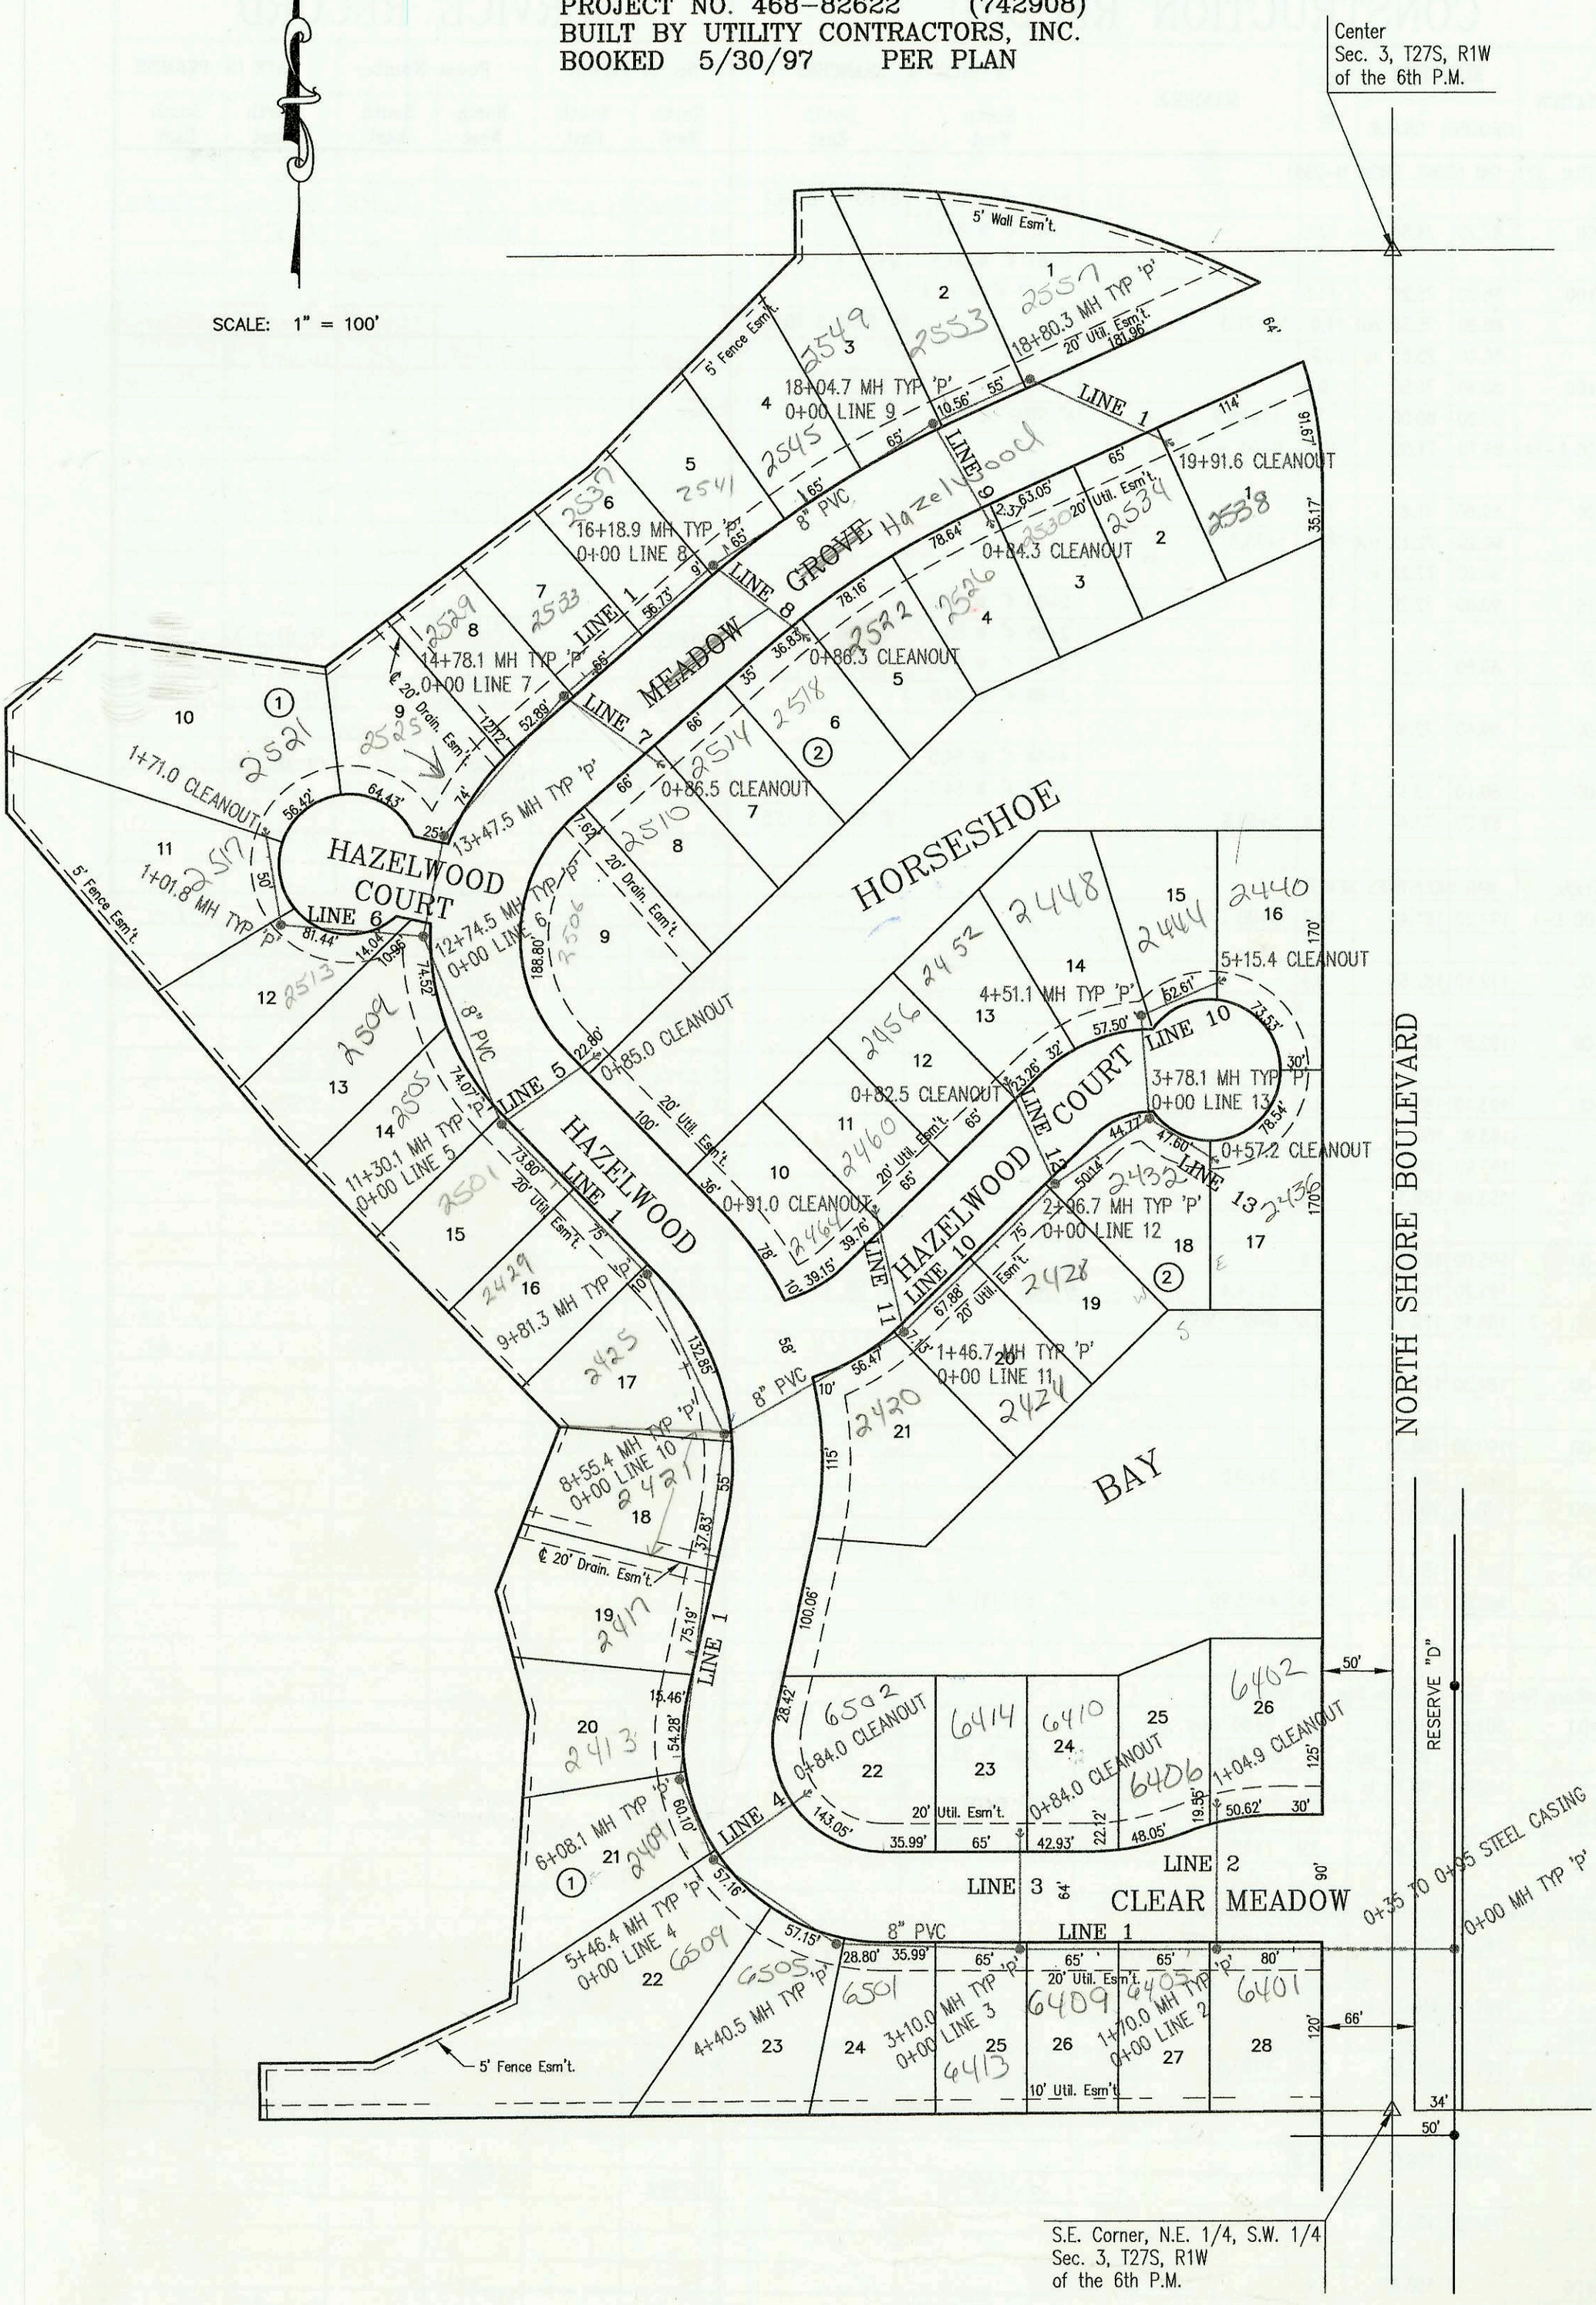

N-257

	CONSTRUCTION RECORD						SERVICE RECORD					
	STATION	ELEVATION GROUND / GRADE		DEPTH	MANHOLE	4-INCH "Y" BRANCHES North West	4-INCH "Y" BRANCHES South East	No. of Permit North West	No. of Permit South East	House Number North West	House Number South East	DATE OF PERMITS North West	DATE OF PERMITS South East
	LATERAL 7, MAIN 16, SOUTHWEST INTERCEPTOR SEWER												
LINE 1	0+00 L-1	135.70	120.87 out	14.8	0+00								
		135.70	122.87 in	12.8									
	1+00	135.80	123.27	12.5			~~1+14~~ ~~1+20~~ 4" S 10V,14H		2001-01058		6401 W Clear Meadow		5-1-01
		138.10	123.55	14.6	1+70.0 = 0+00 L-2								
	2+00	138.30	123.67	14.6			1+90 4" S 11V,14H		99-10199-7		6405 Clear Meadow		5-13-99
							2+55 4" S 12V,14H						
	3+00	140.40	124.07	16.3									
		140.80	124.11	16.7	3+10.0 = 0+00 L-3								
							3+25 4" S 13V,14H		99-10207		6413 Clear Meadow		5-13-99
	4+00	140.50	127.47	13.0			3+85 4" S 13V,16H		99-11854-7		6501 Clear Meadow		6-3-99
		141.10	124.63	16.5	4+40.5								
	5+00	140.60	124.87	15.7			4+55 4" S 13V,19H		97-170627		6505 Clear Meadow		9-29-97
							5+30 4" S 12V,19H		98-147197		6509 Clear Meadow		8-10-98
		141.00	125.06	15.9	5+46.4 = 0+00 L-4	5+50 4" SCH40							
	6+00	140.40	125.27	15.1		~~5+60~~ 4" W 12V,16H was cut 10'		97-170657		2409 Hazelwood		9-29-97	
		140.80	125.30	15.5	6+08.1								
	7+00	140.20	125.67	14.5		6+25 4" W 12V,18H		98-240977		2413 Hazelwood		12-16-98	
						7+00 4" W 11V,18H							
	8+00	140.40	126.07	14.3		7+75 4" W 11V,11H		97-16899-7		2421 N. Hazelwood		9-26-97	
		140.90	126.29	14.6	8+55.4 = 0+00 L-10								
	9+00	140.90	126.47	14.4		9+10 4" W 11V,3H		98-59165-7		2425 Hazelwood		4-7-98	
					9+81.3								
	10+00	141.50	126.87	14.6		10+00 4" W 11V14H		98-5183-7		2429 Hazelwood		4-7-98	
						10+75 4" W 11V14H		98-157337		2501 Hazelwood		8-25-98	
	11+00	141.50	127.27	14.2		11+45 4" W 10V20H		99-493-7		2505 Hazelwood		1-12-99	
					11+30.0 = 0+00 L-5								
	12+00	140.60	127.67	12.9		12+20 4" W 9V27H		98-3802-7		2509 Hazelwood		3-11-98	
		141.00	127.97	13.0	12+74.5 = 0+00 L-6								
	13+00	140.00	128.07	11.9									
		140.80	128.26	12.5	13+47.5								
						13+65 4" NW 8V18H		2000-00978		2525 Hazelwood		3-27-00	
	14+00	140.00	128.47	11.5		14+45 4" NW 7V18H		2000-00234		2529 Hazelwood		1-25-2000	
		140.40	128.78	11.6	14+78.1 = 0+00 L-7								
	15+00	140.40	128.87	11.5		15+00 4" NW 7V14H							
						15+65 4" NW 7V14H		SUB 1999-00166		2537 Hazelwood		6-9-99	
	16+00	140.50	129.27	11.2		16+35 4" N 7V15H		2000-00823		2541 Hazelwood		3-8-00	
		141.20	129.35	11.8	16+18.9 = 0+00 L-8								
	17+00	140.80	129.67	11.1		17+00 4" N 7V19H		99-01316		2545 Hazelwood		11-24-99	
						17+65 4" N 8V17H		2001-01362		2549 Hazelwood		6-4-01	
	18+00												
		141.70	130.09	11.6	18+04.7 = 0+00 L-9								
						18+25 4" N 8V14H		1999-432		2553 Hazelwood		8-6-99	
		141.40	130.39 out	11.0	18+80.3	4" NE 7V46H		SUB 1999-00184		2557 Hazelwood		7-14-99	
	19+00	140.40	130.67	9.7									
					19+91.6	19+85 4" E 5V19H	19+84 4" S 5V19H		2004-01197		2538 Hazelwood		4-8-24
	19+91.6	140.10	131.04	9.1	CLEANOUT								
LINE 2	0+00 L-2	138.10	123.55 out	14.6	0+00 = 1+70.0 L-1								
		138.10	128.55 in	9.6	OUTSIDE DROP								
	1+00					0+97 4" NE 3V14H	0+98 4" SE 3V12H	2001-02924	SUB 1999-00166	6406 Clear Meadow	6403 Clear Meadow	11-15-01	6-7-99
	1+04.9	137.40	130.65	6.8	CLEANOUT								
LINE 3	0+00 L-3	140.80	124.11 out	16.7	0+00 = 3+10 L-1								
		140.80	128.11 in	12.7	OUTSIDE DROP								
	0+84.0	140.70	129.79	10.9	CLEANOUT	0+76 4" NE 2V15H	0+78 4" SE 2V11H	2000-00817		6414 Clear Meadow		1-24-2000	
LINE 4	0+00 L-4	141.00	125.06 out	15.9	0+00 = 5+46.4 L1								
		141.00	129.06 in	11.9	OUTSDIE DROP								
	0+84.0	141.00	130.74	10.3	CLEANOUT		0+78 4" E 2V12H						
LINE 5	0+00 L-5	141.70	127.39 out	14.3	0+00 = 11+30.1 L-1								
		141.70	127.79 in	13.9									
	0+85.0	141.80	130.41	11.4	CLEANOUT	0+79 4" N 2V11H		97-28120-7		2546 Hazelwood		11-7-97	
LINE 6	0+00 L-6	141.00	127.97 out	13.0	0+00 = 12+74.5 L-1								
		141.00	128.17 in	12.8									
	1+00						0+75 4" S 9V19H		99-5558-7		2513 Hazelwood		3-19-99
		142.00	128.58 out	13.4	1+01.8								
		142.00	128.68 in	13.3		1+50 4" W 9V12H		97-14928-7		2517 Hazelwood		8-27-97	
	1+71.0	141.80	129.25	12.6	CLEANOUT	1+65 4" W 9V5H		97-30122-7		2521 Hazelwood		11-7-97	
LINE 7	0+00 L-7	140.60	128.78 out	11.8	0+00 = 14+78.1 L-1								
		140.60	129.18 in	11.4			0+78 4" S 6V14H	99-1237-7		2510 Hazelwood		7-25-99	
	0+86.5	140.70	130.74	10.0	CLEANOUT		0+80 4" E 6V10H		98-157367		2514 Hazelwood		8-25-98
	CONT. ON N-256												