N-280, N-281 & N-282 are related to the same project.
(and combined in this file)

N-281A

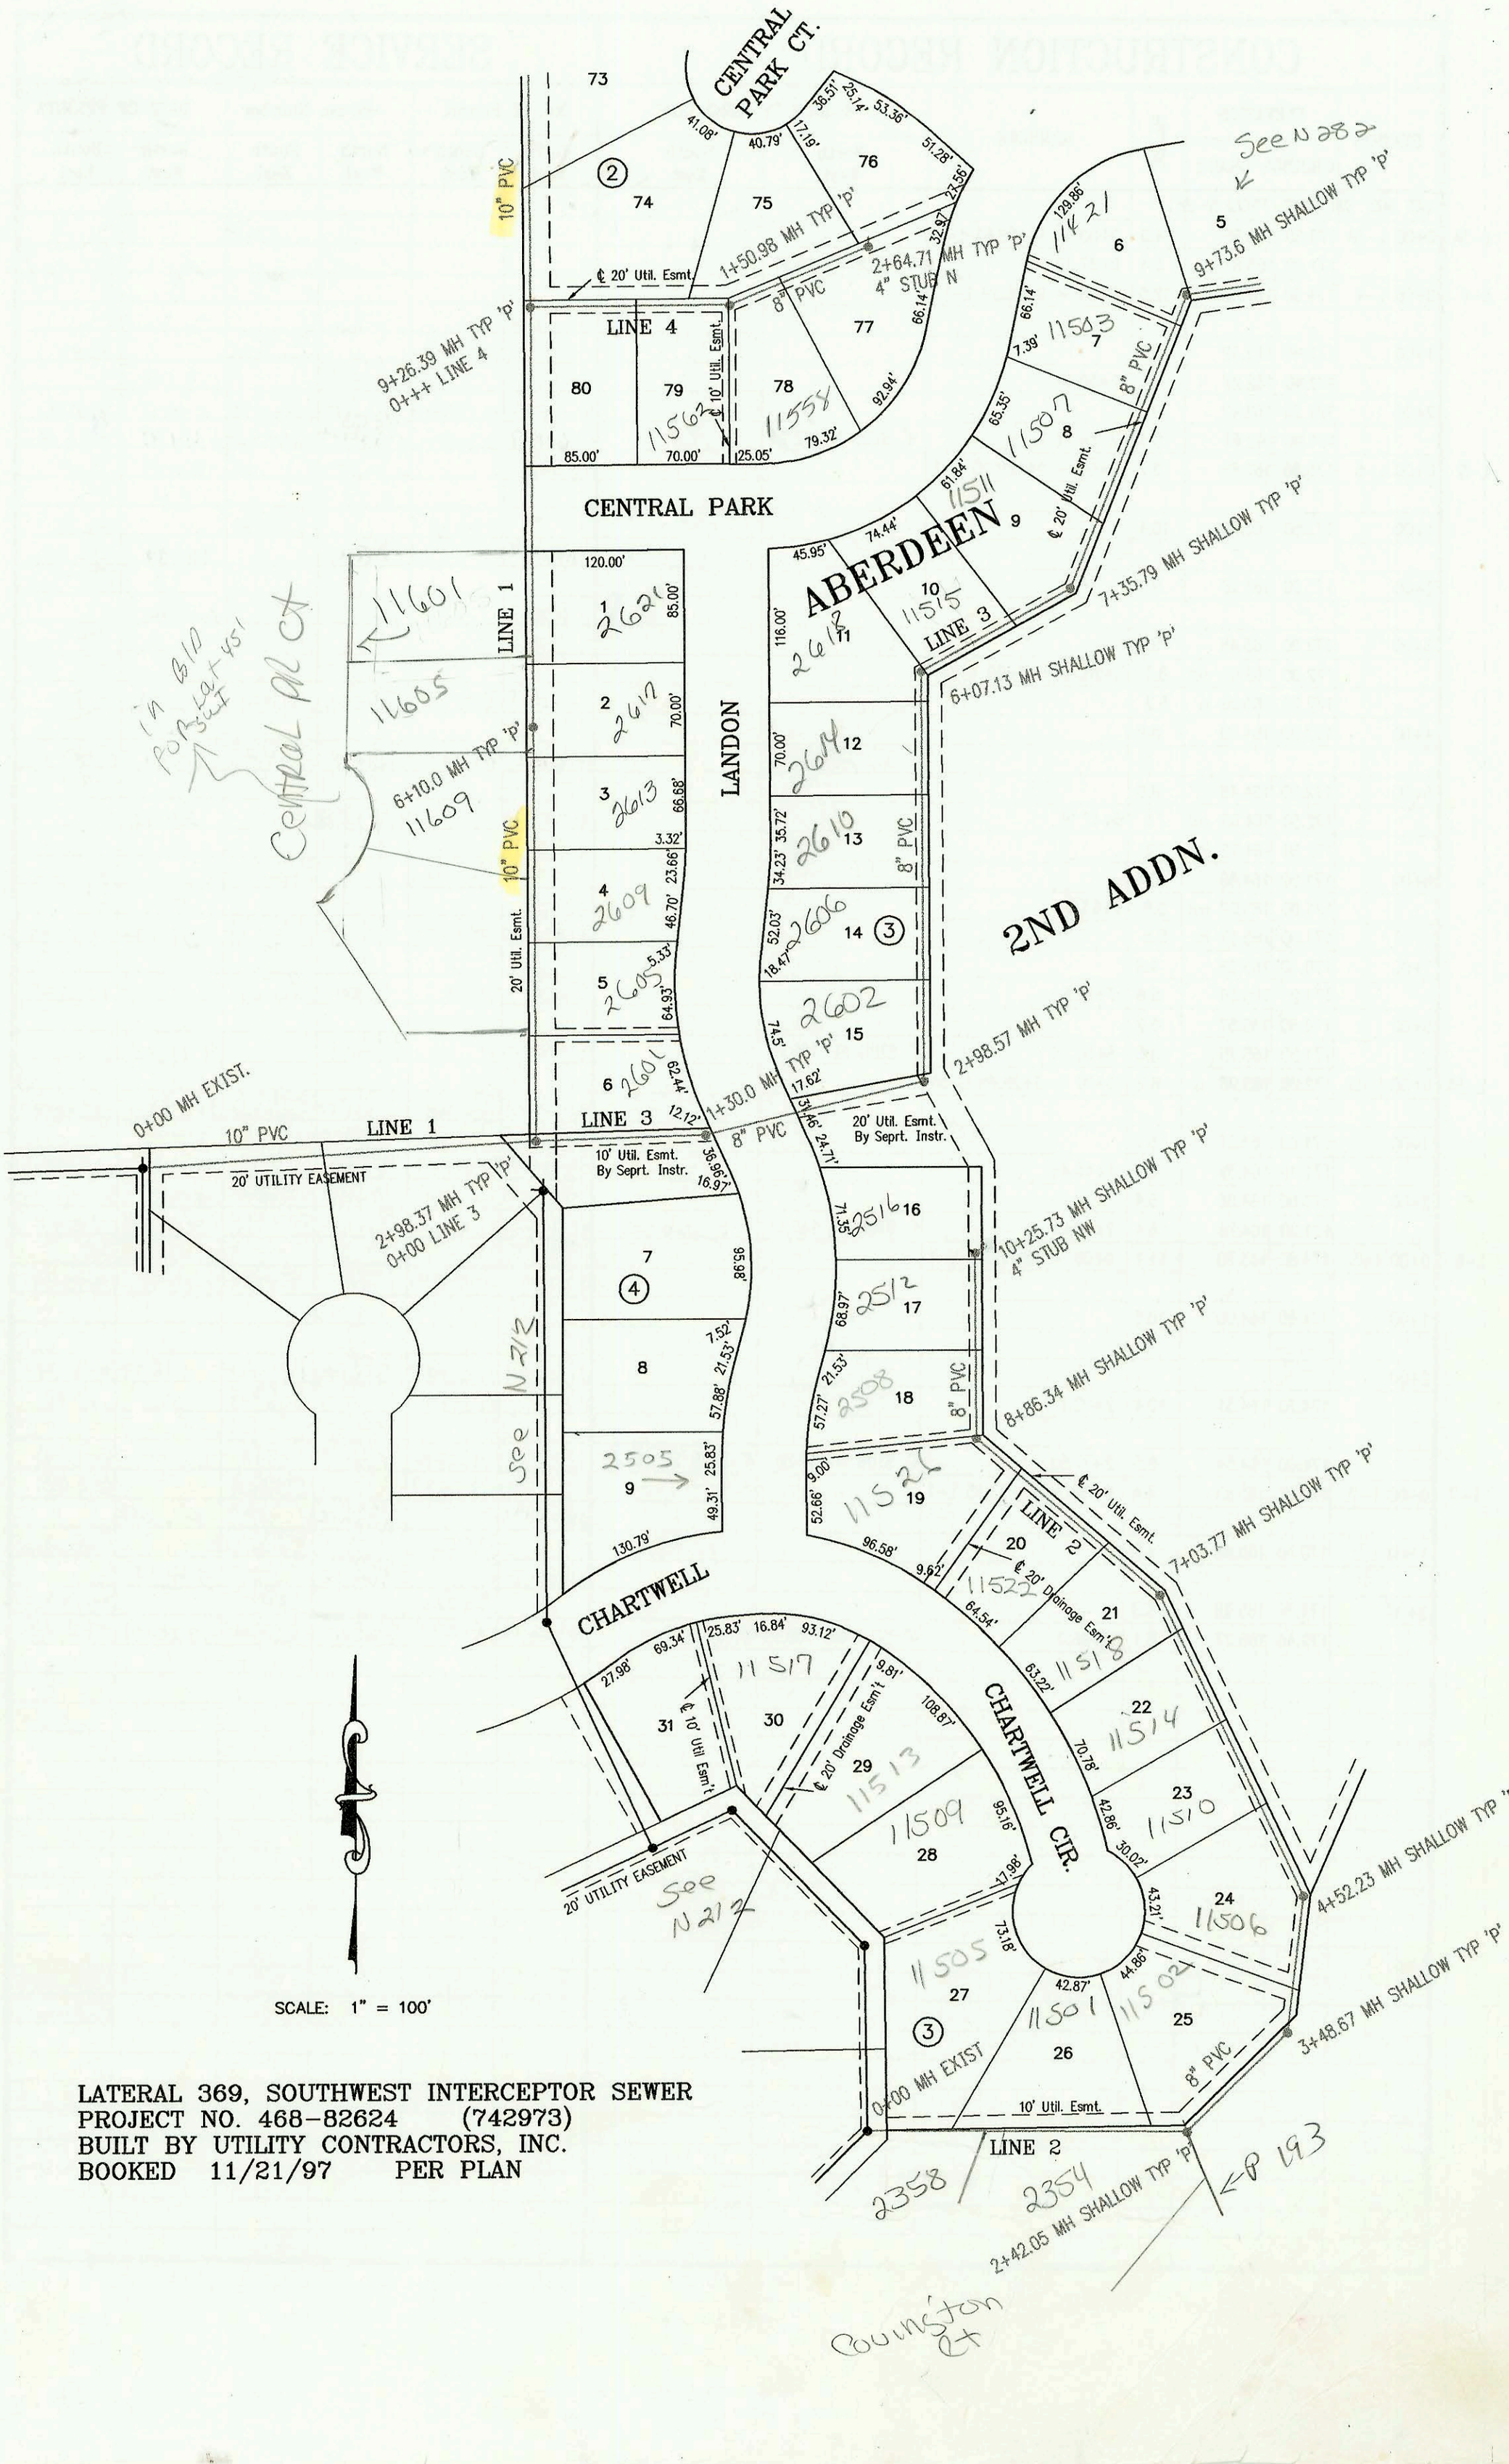

SCALE: 1" = 100'

LATERAL 369, SOUTHWEST INTERCEPTOR SEWER
PROJECT NO. 468-82624 (742973)
BUILT BY UTILITY CONTRACTORS, INC.
BOOKED 11/21/97 PER PLAN

There is no map page for N-280

N-280

CONSTRUCTION RECORD

	STATION	ELEVATION GROUND	ELEVATION GRADE	DEPTH	MANHOLE	4-INCH "Y" BRANCHES North West	4-INCH "Y" BRANCHES South East
	LATERAL 369, SOUTHWEST INTERCEPTOR SEWER						
L-1	0+00 L-1	171.10	159.70	11.4	0+00 EXIST		
	1+00	170.90	159.90	11.0			
	2+00	171.00	160.10	10.9			
		168.40	160.30 out	8.1	2+98.37		
		168.40	160.40 in	8.0			
	3+00						
	4+00	170.20	160.60	9.6			
	5+00	170.70	160.80	9.9			4" SCH40 5+39 Saddle
	6+00	171.70	161.00	10.7			
		172.30	161.02	11.3	6+10.0		
	7+00	173.20	161.20	12.0		4" SCH40 6+21 Saddle	
	8+00	173.80	161.40	12.4		4" SCH40 6+72 Predco	
	9+00	174.00	161.60	12.4			
		174.30	161.65	12.7	9+26.39 = 0+00 L-4		
	10+00	174.20	161.80	12.4			
	11+00	174.60	162.00	12.6			10+80 4" E 7V14H
		175.40	162.15	13.3	11+75.0		11+80 4" E 6V14H
	12+00	175.10	162.20	12.9			12+47 4" E 6V14H
	13+00	175.70	162.40	13.3			13+30 4" E 7V14H
	14+00	175.70	162.60	13.1		14+22.5 4" W 8V 26 H	
		175.60	162.78	12.8	14+89.15 = 0+00 L-5		
	15+00	175.20	162.80	12.4			
	16+00	175.50	163.00	12.5			16+65 4" E 7V14H
	17+00	175.40	163.20	12.2		17+78 4" W 7.5' V 26' H	
	18+00	175.10	163.41	11.7			
		174.80	163.43	11.4	18+12.15 = 0+00 L-6		
	19+00	174.60	163.60	11.0			
	20+00	174.20	163.80	10.4		20+94 4" W 6'V 26 H	
	21+00	173.90	164.00	9.9		21+09 4" W 6V 26 H	
		174.30	164.05 out	10.3	21+25.15		
		174.30	164.15 in	10.2			
	22+00	172.00	164.30	7.7			
	23+00	170.90	164.50	6.4			
		171.10	164.60	6.5	23+50.0		
	24+00	170.50	164.70	5.8			
	25+00	170.00	164.90	5.1		4" SCH40 25+37.15	4" SCH40 25+36.15
	26+00	169.80	165.10	4.7			
		170.20	165.21	5.0	26+53.15 = 0+00 L-7		
	27+00	169.40	165.30	4.1			
	28+00	169.40	165.50	3.9			
	29+00	169.90	165.71	4.2			
		170.70	165.86 out	4.8	29+77.16	8" STUB N 166.13	8" STUB E 166.13
		170.70	166.13 in	4.6			
	30+00	170.60	166.20	4.4			4" SCH40 30+93.16
	31+00	171.70	166.50	5.2			4" SCH40 31+29.37
		172.90	166.75	6.1	31+82.37	4" SCH40 32+12.33	4" SCH40 32+27.33
	32+00	172.50	166.80	5.7			
		173.40	167.04	6.4	32+79.33		4" SCH40 4" STUB SW 167.23
	CONT. ON N-281						

SERVICE RECORD

No. of Permit North West	No. of Permit South East	House Number North West	House Number South East	DATE OF PERMITS North West	DATE OF PERMITS South East
	9883687		2604 London		5-5-98
	1999-00398		2605 London		8-6-99
			2609 London		5-28-99
	2000 02604		2613 London		11-29-00
2001-02128	9854327	11609 W Central Pkwy	2617 London	8-27-01	4-8-98
2001-01093	9835367	11605 W Central Pkwy	2621 London	5-3-01	3-6-98
2001-01376		11601 W Central Pkwy		6-6-01	
	99-34467		11538 Central Pk Ct		2-24-99
2601 02552		2718 ParkRidge		10-5-01	
	98 8354-7		11534 Central Pk Ct		5-5-98
	98-15077		11526 Central Pk Ct		2-24-98
2002 02054		2754 Parkridge		7-24-02	
2002-01481		11610 W Ryan Pl		5-24-02	
2002-01441		11614 W RYAN PL		5-22-02	
	9869857		11551 Ryan Cir		4-2098
2002-02246		11626 Ryan Pl		8-5-02	
2002 01724		11630 Ryan Pl		6-19-02	
	98-18887		11528 Ryan Cir		10-2-98
2002-02546		11624 RYAN		8-15-02	
	98-17673-7		11524 Ryan Cir		9-21-98
	98240867		11522 Ryan Cir		12-17-98
	98149987		11518 Ryan Cir		8-6-98
2000-00191	2000-00190	11510 RYAN CR	11514 Ryan Cir	1-21-00	1-21-00
	98-8135-7		2820 Sheffield Dr		5-5-98
98-	99-007287	2816 Sheffield	2813 Caredington	6-16-98	9-21-99
98 6980-7	99-009947	2812 Sheffield Dr	2807 Caredington	4-20-98	10-21-99
	2000-01485		2805 Caredington		6-2-00
9900976	2000-01484	2806 Sheffield	2801 Caredington	10-21-99	6-2-00
	2000-01893		2804 Caredington		8-24-00

N-281

CONSTRUCTION RECORD

	STATION	ELEVATION GROUND	ELEVATION GRADE	DEPTH	MANHOLE	4-INCH "Y" BRANCHES North West	4-INCH "Y" BRANCHES South East
	LAT 369, SWI CONT.	FROM N-280					
L-2	0+00 L-2	168.40	159.61	8.8	0+00 EXIST		
	1+00	167.20	159.91	7.3			
	2+00	166.60	160.21	6.4			
		166.90	160.34 out	6.6	2+42.05		
		166.90	160.44 in	6.5			
	3+00	166.20	160.61	5.6			
		166.30	160.76	5.5	3+48.67		
	4+00	165.90	160.91	5.0			
		166.40	161.07	5.3	4+52.23		
	5+00	166.00	161.21	4.8			
	6+00	166.00	161.51	4.5			
	7+00						
		166.40	161.82	4.6	7+03.77	4" SCH40 7+13.77 Saddle	
	8+00	166.00	162.11	3.9		4" SCH40 8+03.77 Saddle	
		166.40	162.37 out	4.0	8+86.3		
		166.40	162.47 in	3.9			
	9+00	166.00	162.51	3.5			
	10+00	167.30	162.81	4.5			
		168.90	162.89	6.0	10+25.73	4" STUB NW 163.22	
L-3	0+00 L-3	168.40	160.57	7.8	0+00 = 2+98.37 L-1		
	1+00	170.70	160.87	9.8			
		172.00	160.96	11.0	1+30.0		
	2+00	171.50	161.17	10.3			
		168.50	161.47 out	7.0	2+98.57		
		168.50	161.57 in	6.9			
	3+00					4" SCH40 3+12.5	
	4+00	168.00	161.88	6.1		4" SCH40 4+80.13	
	5+00	168.00	162.18	5.8			
	6+00	168.00	162.48	5.5		4" SCH40 5+60.13	
		168.40	162.50 out	5.9	6+07.13		
		168.40	162.60 in	5.8		4" SCH40 6+41.13	
	7+00	168.00	162.88	5.1			
		168.40	162.99	5.4	7+35.79	4" SCH40 7+12.79	
	8+00	168.00	163.18	4.8			
						4" SCH40 9+30.6	
	9+00	168.00	163.48	4.5			
		168.40	163.70 out	4.7	9+73.6		
		168.40	163.80 in	4.6			
	10+00	168.00	163.88	4.1			
		168.40	164.06 out	4.3	10+59.44		
		168.40	164.16 in	4.2			
	11+00	168.50	164.28	4.2			
		169.60	164.43 out	5.2	11+50.34		
		169.60	164.53 in	5.1			
	12+00	169.30	164.68	4.6			4" SCH40 12+65.3
	13+00	169.60	164.98	4.6			
	14+00	169.90	165.28	4.6			4" SCH40 14+04.51
		170.50	165.45	5.1	14+58.51 = 0+00 L-3A		
	15+00	169.70	165.58	4.1			
		171.10	165.82 out	5.3	15+79.77		
		171.10	165.92 in	5.2			
	16+00	170.50	165.98	4.5			4" SCH40 16+88.8
	17+00	170.00	166.28	3.7			
		170.10	166.44 out	3.7	17+53.29		
		170.10	166.54 in	3.6			
		170.30	166.65 out	3.7	17+90.43	8" STUB NE 166.75	
		170.30	166.75 in	3.6			
	18+00	170.00	166.78	3.2			
		170.60	166.99	3.6	18+71.87	4" STUB NW 167.32	
	CONT. ON N-282						

SERVICE RECORD

No. of Permit North West	No. of Permit South East	House Number North West	House Number South East	DATE OF PERMITS North West	DATE OF PERMITS South East
	2353 Old Field		2358 Courtney		3-12-02
			2354 Courtney		6-24-02
99-31387		11501 Chartwell		2-24-99	
98-17012-7		11503 Chartwell		9-9-98	
98-11824-7		11506 Chartwell Dr		7-2-98	
98-23522-7		11510 Chartwell		5-15-98	
98-23122-7		11514 Chartwell Dr		11-30-98	
2001-00575		11518 Chartwell		3-15-01	
2001-01672		11522 W Chartwell		7-9-01	
98-23329-7		11506 Chartwell		1-30-98	
98-11033-7		2508 Landon		6-19-98	
1999-00318		2512 Landon		9-2-99	
98-5431-7		2516 Landon		4-8-98	
98-16082-7		2602 Landon		8/27/98	
99-00685		2606 Landon		9-16-99	
2000-00192		2610 Landon		1-21-2000	
2000-00193		2614 Landon		1-21-2000	
99-5574-7		2618 Landon		3-19-99	
2000-01396		11515 W Central Pk		6-12-00	
99-00686		11511 Central Pk		9-16-99	
2000-01397		11503 W Central Pk		6-12-00	
98-21693-7		11421 Central Park		10-26-98	
2002-02245		11417 W Central Pk		8-15-02	
	2000-02414		11409 W Central Pk		11-3-00
98-11359-7			11405 Central Pk		6-24-98
2000-00855			2709 N Sheffield		5-11-00
	2000-02134		11308 Central Pkwy		9-27-00
99-5583-7		11312 Central Pk E		3-19-99	
98-14034-7		2714 Sheffield		7-23-98	
2000-00696		2718 Sheffield		3-15-00	

N-282A

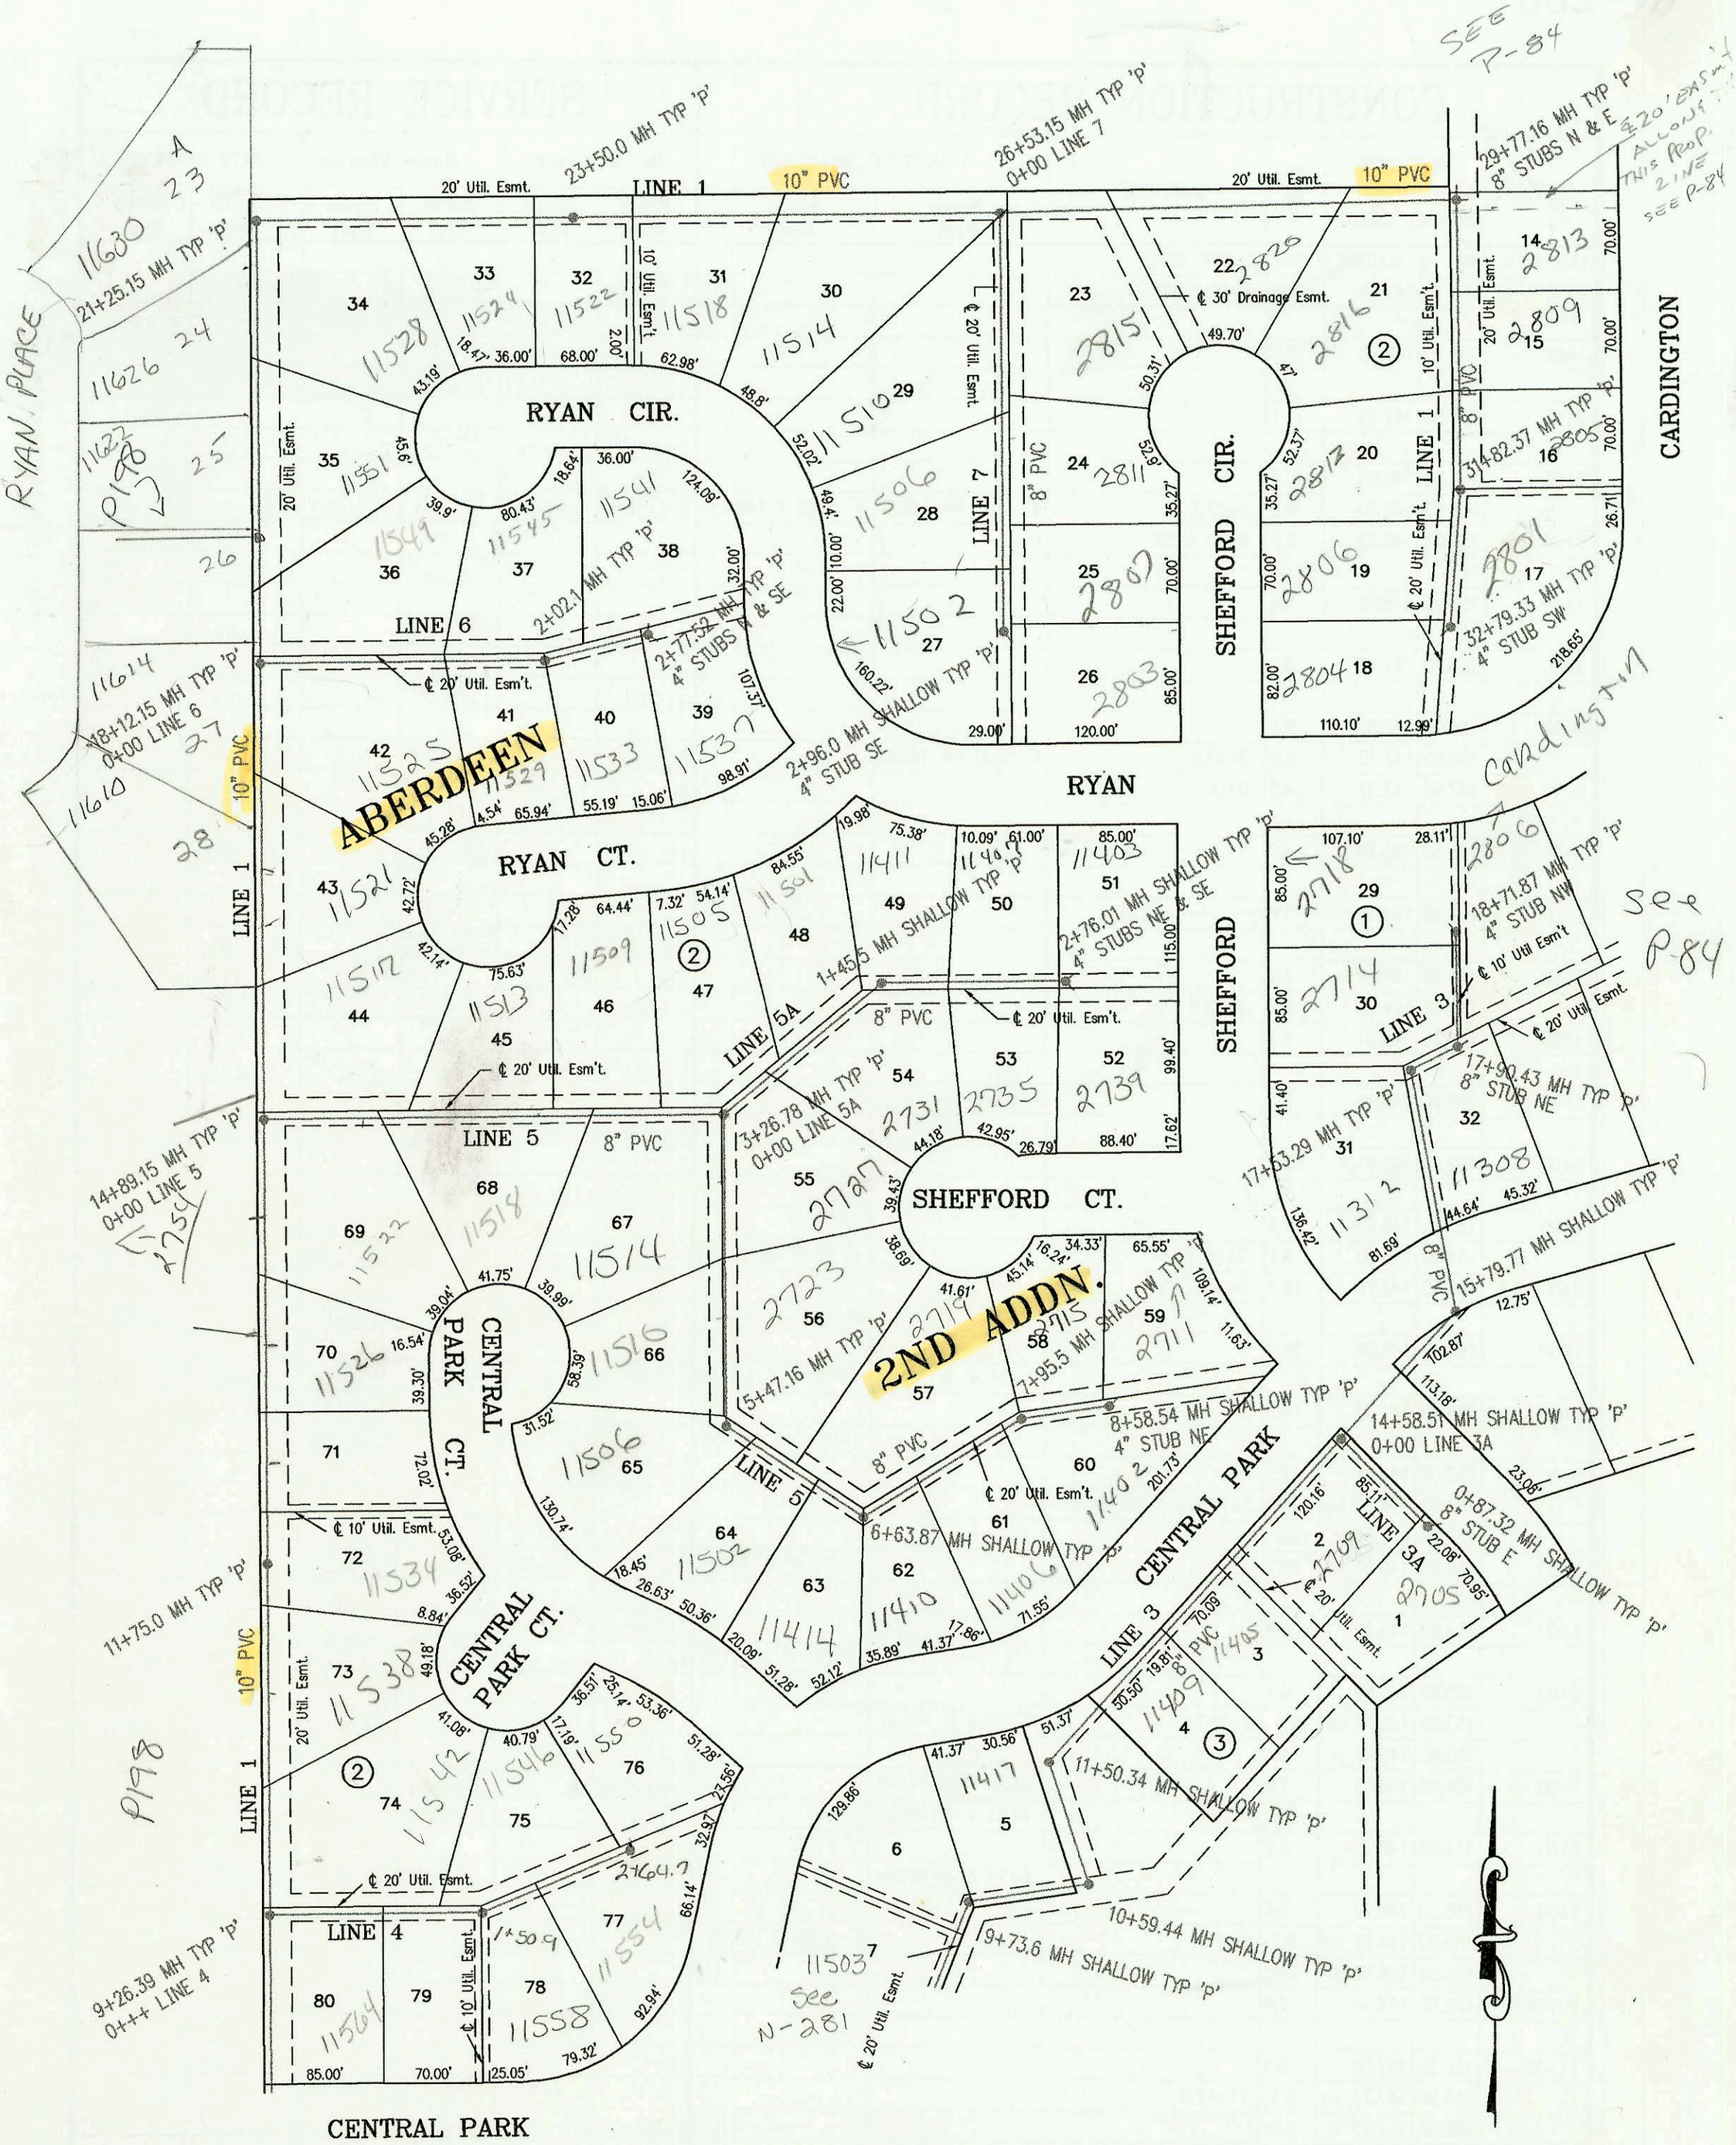

LATERAL 369, SOUTHWEST INTERCEPTOR SEWER
PROJECT NO. 468-82624 (742973)
BUILT BY UTILITY CONTRACTORS, INC.
BOOKED 11/21/97 PER PLAN

N-282

CONSTRUCTION RECORD

	STATION	ELEVATION GROUND	ELEVATION GRADE	DEPTH	MANHOLE	4-INCH "Y" BRANCHES North West	4-INCH "Y" BRANCHES South East
	LAT 369, SWI CONT. FROM N-281						
L-3A	0+00 L-3A	170.50	165.55	4.9	0+00 = 14+58.51 L-3		
		171.20	165.81	5.4	0+87.32	8" STUB E 165.91	
L-4	0+00 L-4	174.30	161.82	12.5	0+00 = 9+26.39 L-1		
	1+00	172.40	162.12	10.3			4" SCH 40 1+06.3
		172.40	162.27	10.1	1+50.98		
	2+00	171.70	162.42	9.3			
		171.90	162.61	9.3	2+64.71	4" STUB N 162.94	
L-5	0+00 L-5	175.60	162.88	12.7	0+00 = 14+89.15 L-1		
	1+00	173.50	163.08	10.4			4" SCH 40 0+70
						4" SCH 40 1+48	
	2+00	173.00	163.28	9.7			
	3+00	172.00	163.48	8.5			
		172.20	163.86 out	8.3	3+26.78 = 0+00 L-5A		
		172.20	163.96 in	8.2		4" SCH 40 3+73.78	
	4+00	172.20	164.18	8.0			
						4" SCH 40 4+67.78	
	5+00	172.50	164.48	8.0			
		172.50	164.62 out	7.9	5+47.16		
		172.50	164.72 in	7.8			
	6+00	171.50	164.88	6.6		4" SCH 40 6+55.87 Saddle	
		171.00	165.07 out	5.9	6+63.87		
		171.00	165.17 in	5.8			
	7+00	170.10	165.28	4.8			
		171.20	165.56	5.6	7+95.5		
	8+00	170.80	165.57	5.2			
		171.50	165.75	5.8	8+58.54	4" STUB NE 165.75	
L-5A	0+00 L-5A	172.20	163.96	8.2	0+00 = 3+26.78 L-5A		
							4" SCH 40 3+79.78
	1+00	171.00	164.26	6.7			
		171.10	164.39	6.7	1+45.45		
	2+00	170.00	164.56	5.4			
		171.20	164.78	6.4	2+76.01	4" STUB NE 165.11	4" Stub SE
L-6	0+00 L-6	174.80	163.70	11.1	0+00 = 18+12.15 L-1		
	1+00	174.60	164.00	10.6			
	2+00						
		174.70	164.31	10.4	2+02.1		
		174.00	164.54	9.5	2+77.52	4" STUB N 164.86	4" STUB SE 164.86
L-7	0+00 L-7	170.20	165.83	4.4	0+00 = 26+53.15 L-1		
	1+00	170.50	165.68	4.8			4" SCH 40 1+59.0
	2+00	171.30	165.98	5.3			
		172.40	166.27	6.1	2+96.0	4" ~~STUB NE 166.53~~	4" SE

SERVICE RECORD

No. of Permit North West	No. of Permit South East	House Number North West	House Number South East	DATE OF PERMITS North West	DATE OF PERMITS South East
	9831082		11562 Central PK		3-2-98
99-58797		11542 Central PK		3-31-99	
98-233237	98-166066-7	11546 Central PK	11558 Central PARK	12-3-98	4-28-98
99-61447	98-230437	11559 Central PK	11554 Central park	4-1-99	11-16-98
98-18107		11514 Ryan ct		2-2-98	
	9900690		11522 Central PK		9-16-99
99-006089		11513 Ryan ct		9-16-99	
98-187087		11509 Ryan ct		10-2-98	
99-01121	99-01411	11514 Central PK	2727 Sheffield	11-5-99	12-7-99
99-01122	Scan 9999-00051	11519 Central PK	2723 Sheffield ct	11-5-99	6-28-99
98-18957		11506 Central PK		2-9-98	
	2001-00871		11414 W Central PK		4-12-01
9996307	99-05975	2719 Sheffield ct	11410 W Central PK	5-10-99	10-21-99
2002-00518	98983-7	2715 Sheffield	11402 Central Park K	3-4-02	1-23-98
98-176747		2711 Sheffield ct		9-21-98	
98-216087	99-01411	11505 Ryan ct	2727 N SHEFFORD	11-11-98	12-7-99
99-55597		11501 Ryan ct		3-19-99	
98-18367	98-6979-7	11411 Ryan	2731 Sheffield ct	7-2-98	4-20-98
99 3859-7	99-60457	11487 Ryan	2735 Sheffield	3-3-99	1-11-99
98-155627	98 9066-7	11403 Ryan	2739 Sheffield ct	8-21-98	5-21-98
98-112597	99-96317	11544 Ryan	11525 Ryan ct	6-24-98	5-10-99
99-68307	99-68297	11545 Ryan ct	11529 Ryan ct	4-16-99	4-16-99
	99-109587		11533 Ryan ct		5-24-99
99-92477	99-00974	11541 Ryan ct	11537 Ryan Sheffield ct	5-4-99	10-21-99
	98-29677				2-19-98
2000-00191		11510 Ryan ct		7-21-2000	
	2000-01892		2811 Sheffield ct		8-24-00
989068-7		11506 Ryan ct		5-21-98	
	2002-02821		2807 Sheffield		10-4-02
99-34457	98-18377	11502 Ryan	2803 Sheffield	12-25-99	7-2-98