N-286A

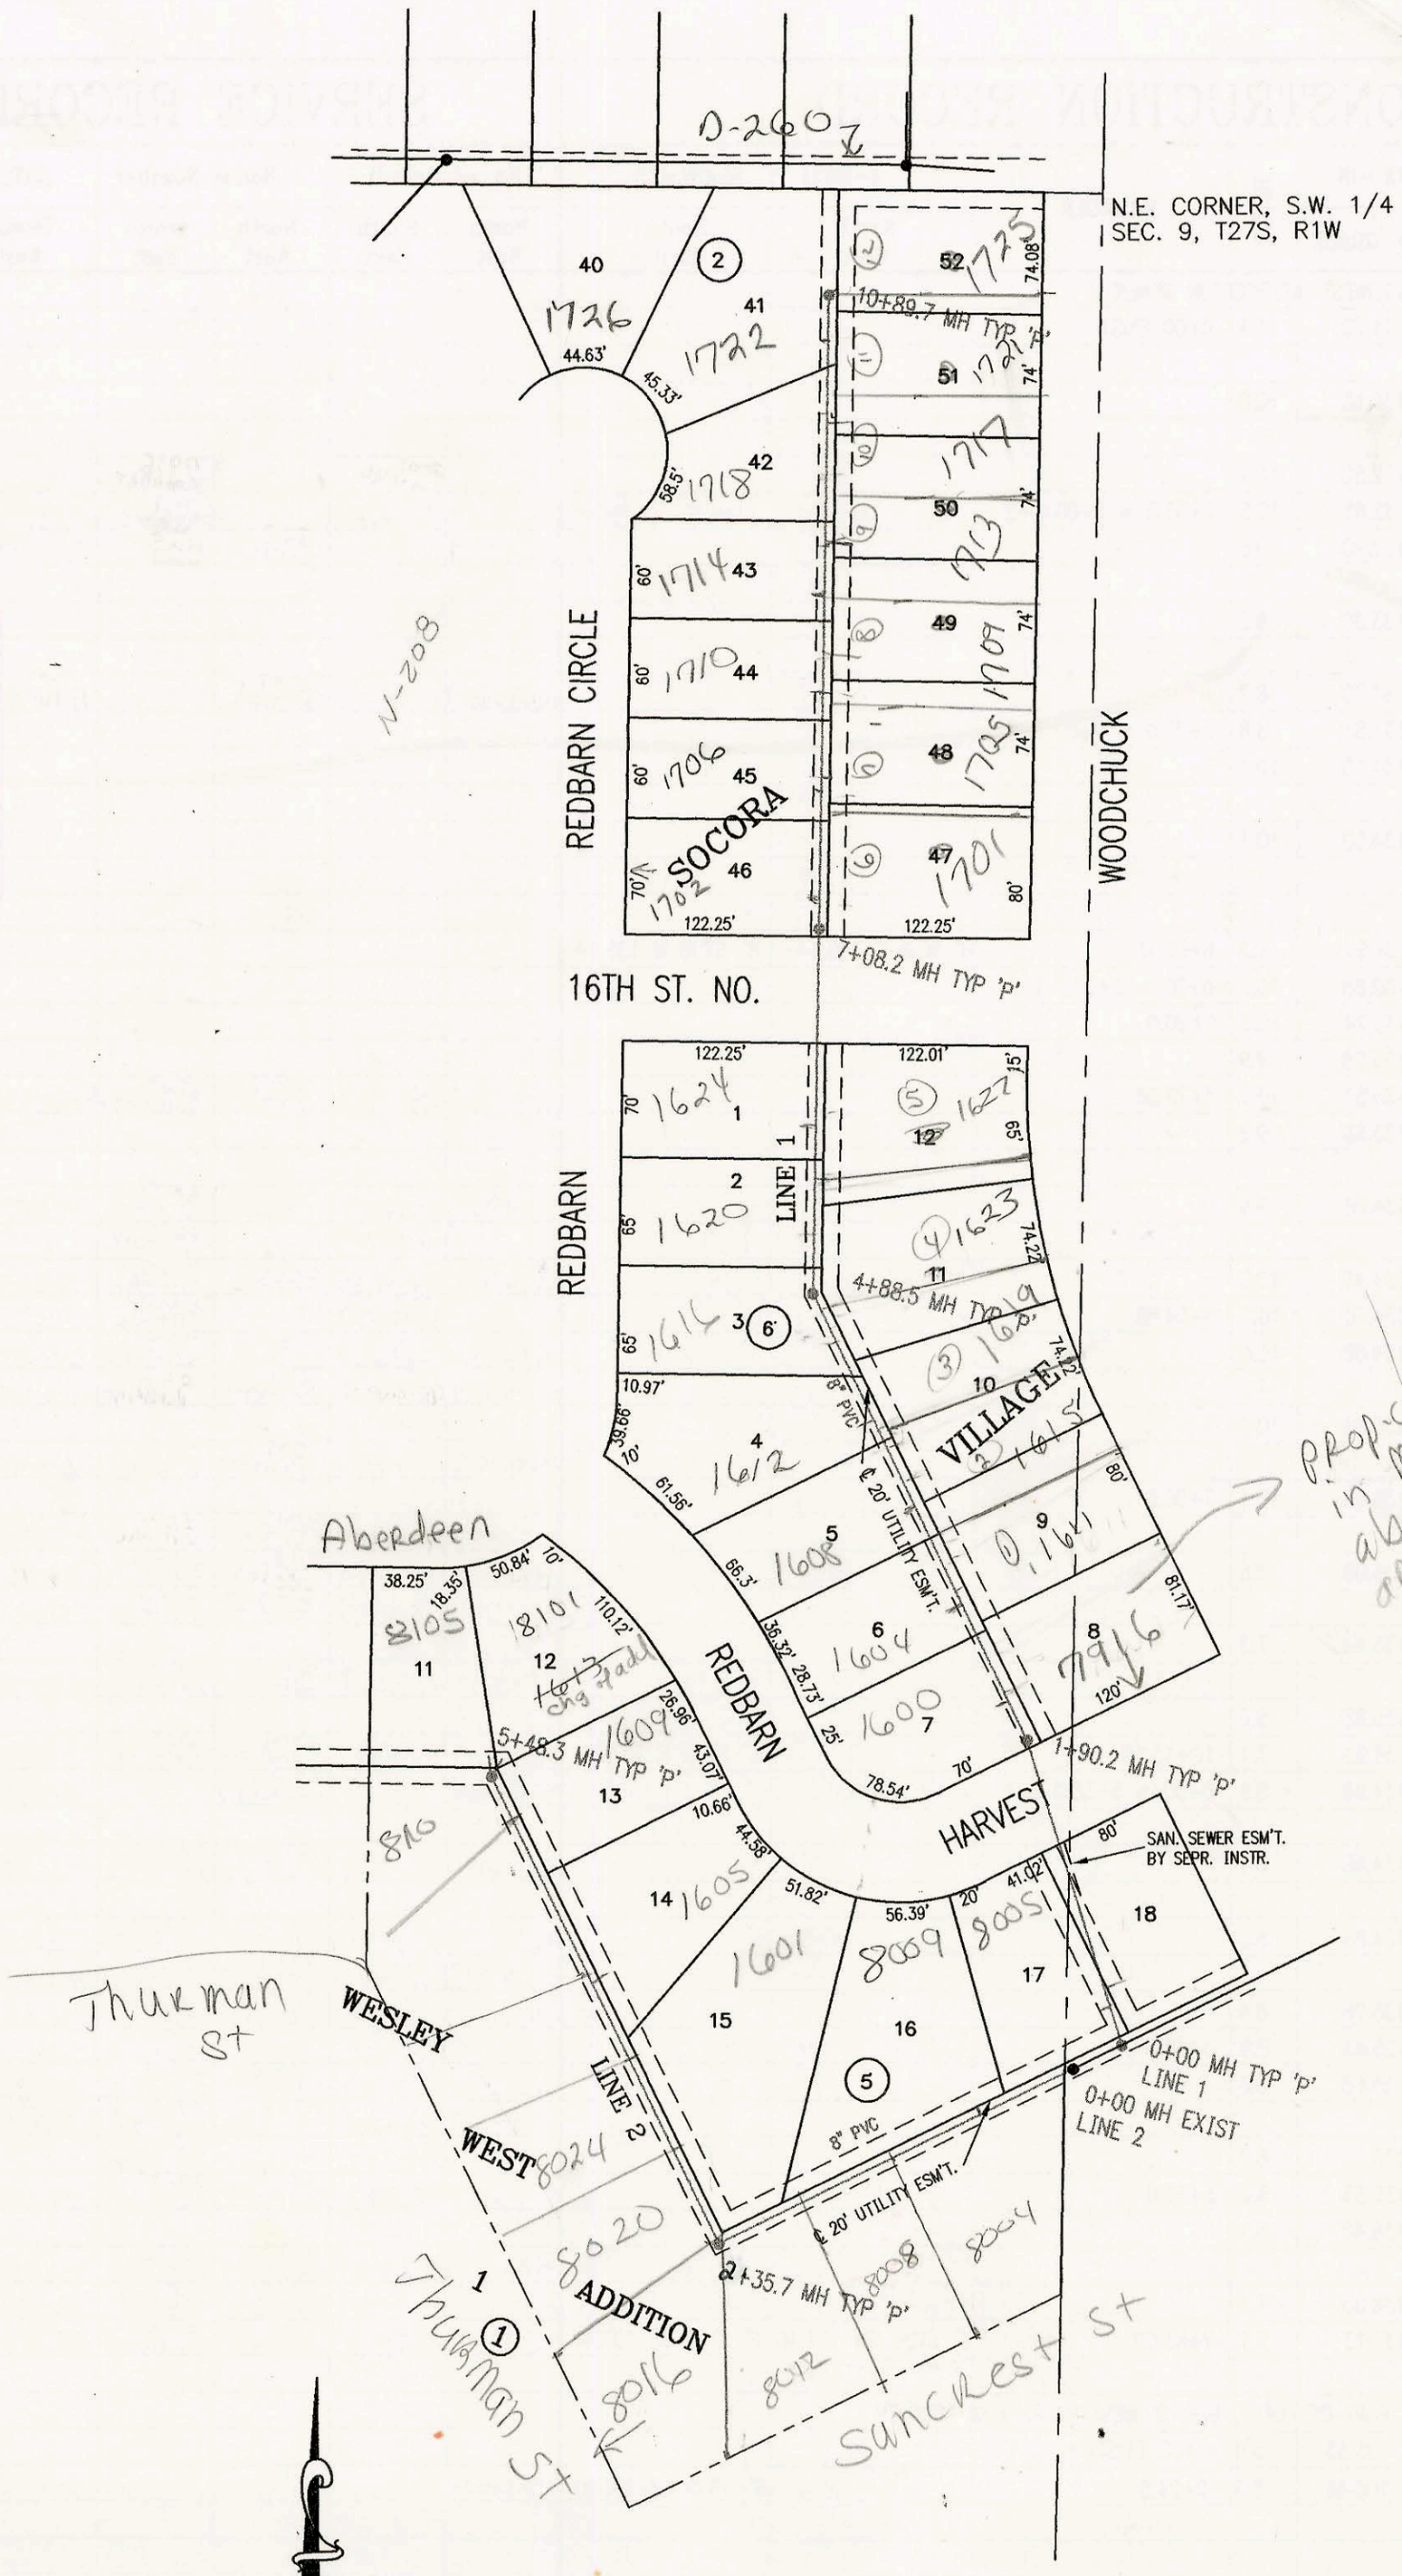

SCALE: 1" = 100'

LATERAL 30, MAIN 15, SOUTHWEST INTERCEPTOR SEWER
PROJECT NO. 468-82253 (743146)
BUILT BY DITCH DIGGERS
BOOKED 12/29/97 PER AS BUILT PLAN

N-286

	CONSTRUCTION RECORD							SERVICE RECORD					
	STATION	ELEVATION GROUND	ELEVATION GRADE	DEPTH	MANHOLE	4-INCH "Y" BRANCHES North West	4-INCH "Y" BRANCHES South East	No. of Permit North West	No. of Permit South East	House Number North West	House Number South East	DATE OF PERMITS North West	DATE OF PERMITS South East
	LAT 30, MAIN 15, SOUTHWEST INTERCEPTOR SEWER												
LINE 1	0+00 L-1	161.70	145.71		0+00								
						0+25 4" W 12V11H	0+35 4" E 12V6H	98-14725-7		8005 Harvest		8-10-98	
	1+00	161.20	146.01	15.2									
		161.10	146.28	14.8	1+90.2		Per insp Young 2+15.2 4" SCH40						
	2+00	161.00	146.31	14.7		2+15 4" W 11V2H	~~2+20~~ 4" E 12V15H	98-12179-7	2001 01140	1610 Redbarn	7916 Harvest	7-8-98	5-10-01
						2+80 4" W 12V3H	2+90 4" E 12V15H	98-12178-7	98-17150-7	1604 Redbarn	1611 Woodchuck	7-8-98	9-9-98
	3+00	162.10	146.61	15.5		3+45 4" W 12V3H	3+65 4" E 13V15H		98-17183-7		1615 Woodchuck		9-4-98
						4+05 4" W 13V3H		98-8162-7		1612 Redbarn		5-15-98	
	4+00	163.00	146.91	16.1		4+55 4" W 12V4H	4+65 4" E 12V14H		98-8336-7		1619 Woodchuck		5-15-98
		162.60	147.18	15.4	4+88.5								
	5+00	162.00	147.21	14.8		5+25 4" W 11V4H	5+55 4" E 11V14H	98-6185-7		1620 N Redbarn		4-16-98	
						5+90 4" W 10V4H		98-10037-7		1624 Redbarn		6-10-98	
	6+00	161.10	147.51	13.6									
	7+00	160.50	147.81	12.7									
		160.90	147.84	13.1	7+08.2	7+25 4" W 10V4H	7+30 4" E 10V14H	98-4136-7	98-12557-7	1702 Redbarn	1701 Woodchuck	3-17-98	7-8-98
	8+00	161.60	148.11	13.5		7+90 4" W 10V4H	8+00 4" E 10V 14H	98-4138-7	98-17172-7	1706 CR Redbarn	1705 Woodchuck	3-9-98	9-4-98
						8+50 4" W 10V4H		98-8173-7		1710 Redbarn CR		5-15-98	
	9+00	162.20	148.41	13.8		9+10 4" W 10V4H	8+75 4" E 11V14H	98-12506-7	98-17169-7	1714 Redbarn	1709 Woodchuck	7-8-98	9-4-98
						9+80 4" W 9V4H	9+40 4" E 10V14H	98-8349-7	99-1577-7	1718 Redbarn CR	1713 Woodchuck	5-15-98	1-25-99
	10+00	161.10	148.71	12.4		10+65 4" W 8V4H	10+20 4" E 9V14H		98-21457-7		1717 N Woodchuck		11-9-98
		160.60	148.98	11.6	10+89.7	~~4" NE 8V16H~~	4" STUB NE 8V 16H		98-29697		1725 Woodchuck		11-16-98
LINE 2	0+00 L-2	161.22	145.87	15.4	0+00 EXIST								
						0+65 4" N 12V12H		98-12578-7	2004 02485	8009 Harvest	8004 Sunset	7-8-98	9-10-04
	1+00	162.00	146.77	15.2									
									2004 02444		8008 Sunset		9-10-04
	2+00	162.70	147.67	15.0									
		162.40	147.99 out	14.4	2+35.7				2004 02447		8012 Sunset		9-10-04
		162.40	148.19 in	14.2									
	3+00	163.20	148.58	14.6			2+80 4" E 11V14H	2004 02886	98-4139-7	8024 Thurman	1601 Redbarn	10-27-04	3-9-98
	4+00	163.50	149.18	14.3			4+10 4" E 11V14H	2004 02887	98-12177-7	8020 Thurman	1695 Redbarn	10-27-04	7-8-98
	5+00	163.70	149.78	13.9			5+05 4" E 10V14H		98-3058-7		1609 N Redbarn		2-25-98
		164.30	150.07	14.2	5+48.3	4" NW 10V16H	4" NNE 10V15H	98-4142-7	98-14733-7	8105 Aberdeen	8101 Aberdeen	3-9-98	7-8-98

99-1264-7 1-22-99 1721 N Woodchuck - NC

98-12493-7 7-8-98 1627 N Woodchuck - Pulsey

98-10041-7 6-4-98 1623 N Woodchuck - Pulsey