N-297A

LIFT STATION AND FORCE MAIN
LAT 136, WAR INDUSTRIES SEWER
PROJECT NO. 468-82694 (743112)
BUILT BY J. J. WESTHOFF CONSTRUCTION CO.
BOOKED 2/18/98 PER AS BUILT PLAN

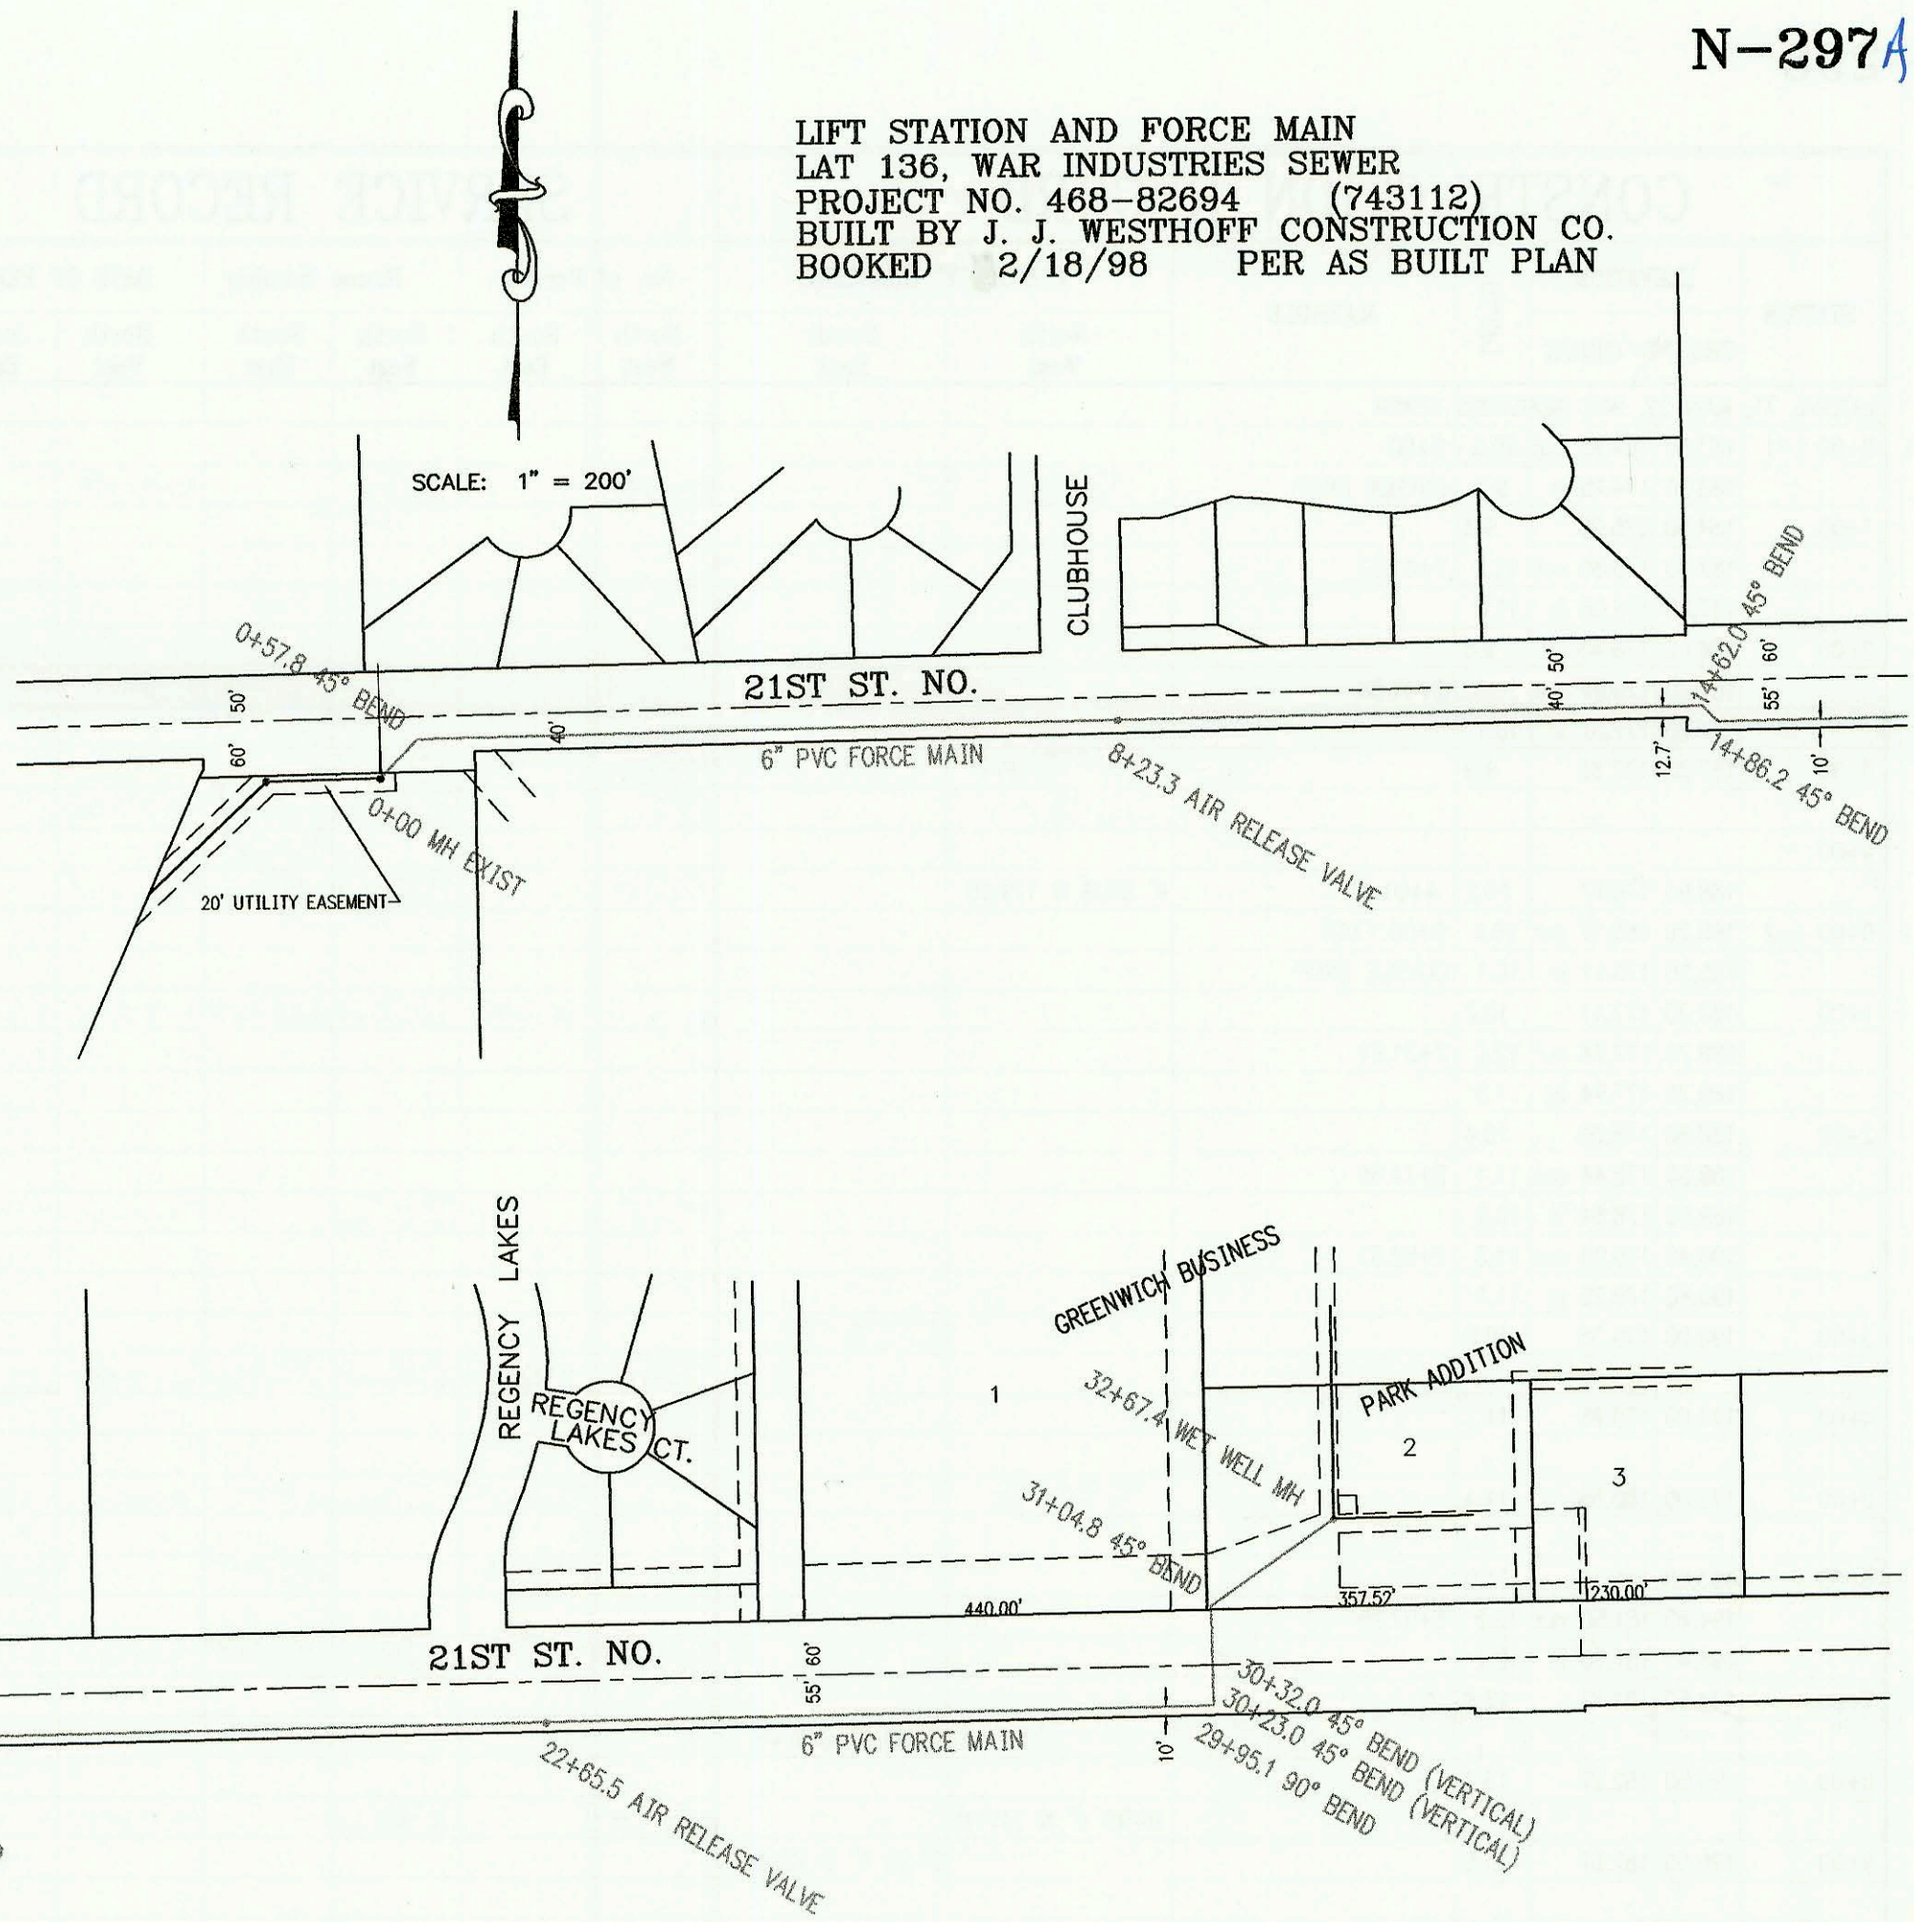

N-297

CONSTRUCTION RECORD							SERVICE RECORD					
STATION	ELEVATION		DEPTH	MANHOLE	4-INCH "Y" BRANCHES		No. of Permit		House Number		DATE OF PERMITS	
	GROUND	GRADE			North West	South East	North West	South East	North West	South East	North West	South East
LIFT STATION AND FORCE MAIN FOR LAT 136, WAR INDUSTRIES SEWER												
0+00	203.10	186.56 out	16.5	0+00 EXIST								
	203.10	in										
1+00	203.50	198.80	4.7									
2+00	205.00	199.78	5.2									
3+00	205.60	200.76	4.8									
4+00	206.60	201.74	4.9									
5+00	208.00	202.72	5.3									
6+00	208.80	203.70	5.1									
7+00	210.00	204.68	5.3									
8+00	210.50	205.66	4.8									
	210.80	205.90	4.9	8+23.3 AIR REL. MH								
9+00	207.70	203.56	4.1									
10+00	205.20	200.44	4.8									
11+00	202.30	197.31	5.0									
12+00	194.80	194.19	0.6									
13+00	196.00	191.07	4.9									
14+00	195.20	187.95	7.3									
15+00	194.00	187.56	6.4									
16+00	192.50	187.56	4.9									
17+00	191.00	186.98	4.0									
18+00	189.50	185.47	4.0									
19+00	188.00	183.96	4.0									
20+00	186.50	182.45	4.1									
21+00	185.20	180.94	4.3									
21+50	184.20	180.06	4.1									
22+10	183.00	174.87	8.1									
	183.80	179.21	4.6	22+65.5 AIR REL. MH								
23+00	183.20	178.98	4.2									
24+00	183.00	178.10	4.9									
25+00	182.70	177.22	5.5									
26+00	181.20	176.34	4.9									
27+00	180.30	175.46	4.8									
28+00	178.80	174.58	4.2									
29+00	178.20	173.70	4.5									
30+00	177.50	172.82	4.7									
30+23.0	177.10	172.57	4.5									
30+32.0	177.30	163.74	13.6									
31+00	179.00	163.74	15.3									
32+00	169.60	163.74	5.9									
32+47	169.60	163.74	5.9									
	176.80	170.50	6.3	32+67.4 WET WELL MH								