P-2 A

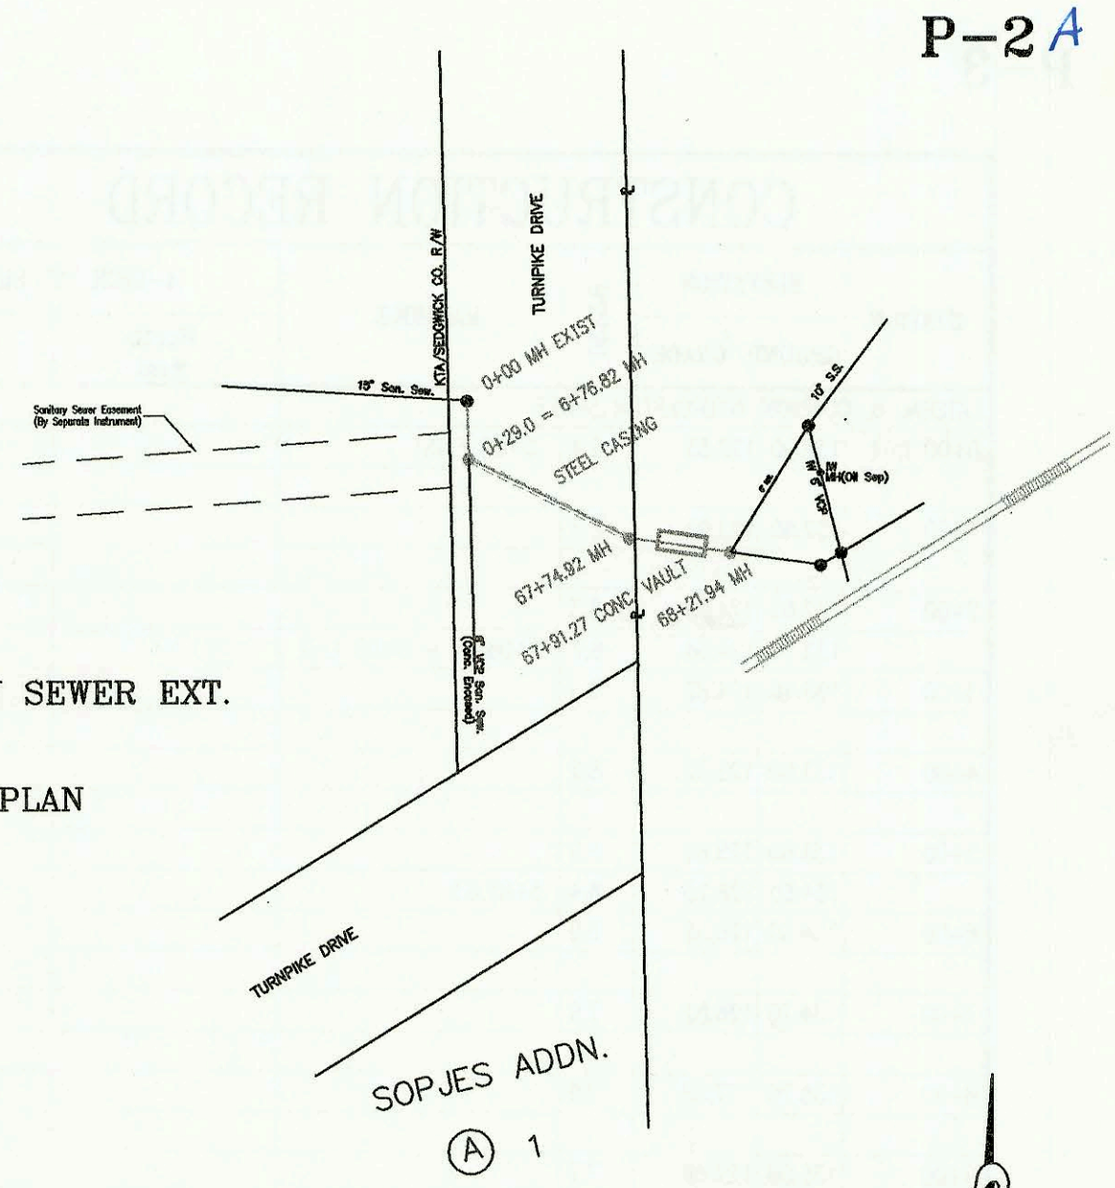

SCALE: 1" = 100'

BOEING NORTHWEST CAMPUS SANITARY SEWER EXT.
PROJECT NO. 703PPS
BUILT BY DEAN E. NORRIS, INC.
BOOKED 4/14/98 PER AS BUILT PLAN

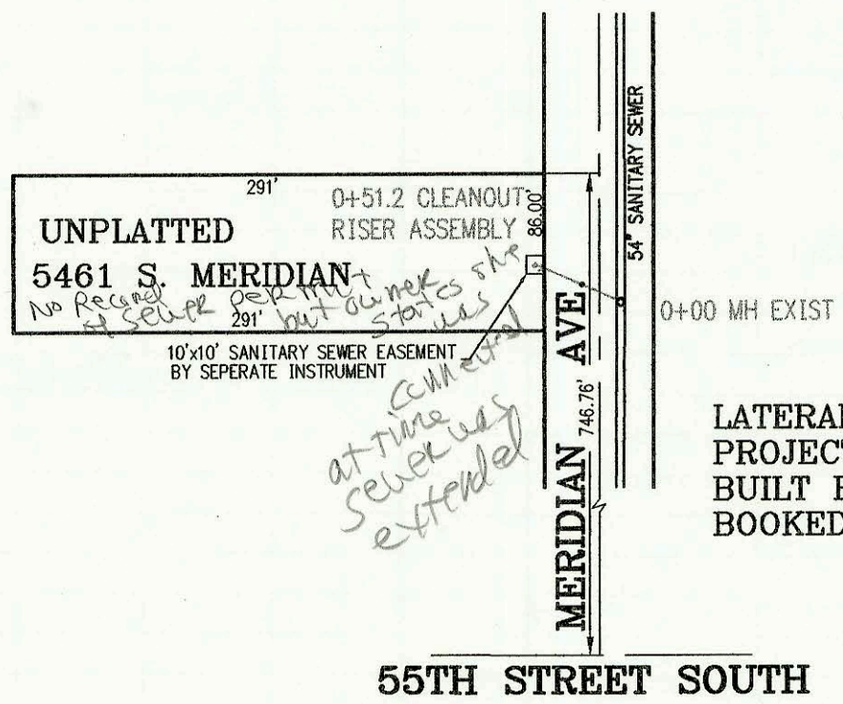

LATERAL 388, SOUTHWEST INTERCEPTOR SEWER
PROJECT NO. 468-82790 (743344)
BUILT BY W. B. CARTER CONSTRUCTION CO.
BOOKED 4/15/98 PER PLAN

SCALE: 1" = 100'

LATERAL 129, WESTLINK SEWER
PROJECT NO. 468-82792 (743369)
BUILT BY MIES CONSTRUCTION CO.
BOOKED 4/15/98 PER PLAN

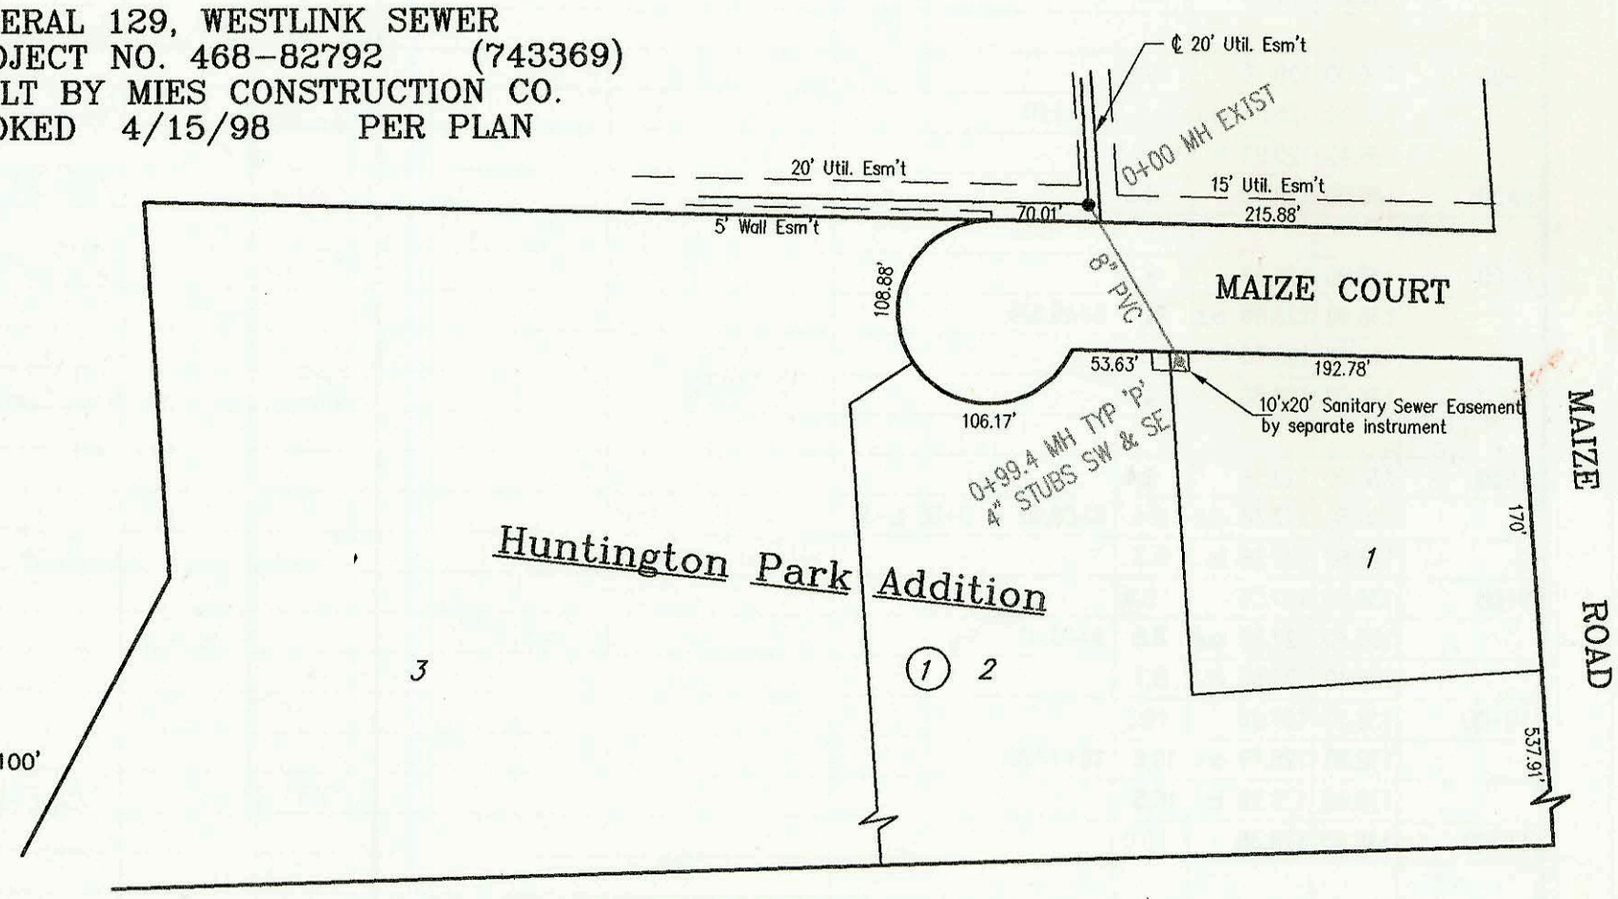

SCALE: 1" = 100'

229, 231 and 233 S. Maple Dunes Ct
(Riser only to be installed under these permit Nos.

P-2

CONSTRUCTION RECORD							SERVICE RECORD					
STATION	ELEVATION		DEPTH	MANHOLE	4-INCH "Y" BRANCHES		No. of Permit		House Number		DATE OF PERMITS	
	GROUND	GRADE			North West	South East	North West	South East	North West	South East	North West	South East
Sanitary Sewer for Boeing Northwest Campus												
0+00	128.58	121.04	7.5	0+00 EXIST								
	132.00	121.80 out	10.2	0+29 = 66+76.82								
	132.00	117.17 out	14.8	24" Stub W								
	132.00	117.27 in	14.7	24" E								
	132.00	122.05 in	10.0	8" S								
67+00												
	134.87	120.47 out	14.4	67+74.92								
	134.87	120.57 in	14.3									
68+00				67+91.27 Concrete Vault								
	137.96	123.59 out	14.4	68+21.94								
LATERAL 388, SOUTHWEST INTERCEPTOR SEWER												
0+00	86.66	71.35 out	15.3	0+00 EXIST								
	86.66	76.53 in	10.1									
0+51.2	86.00	78.00	8.0	CLEANOUT RISER								
LATERAL 129, WESTLINK SEWER												
0+00	159.50	150.30	9.2	0+00 EXIST								
	158.30	150.70	7.6	0+99.4	4" STUB SW 151.03	4" STUB SE 151.03						
LATERAL 6, COWSKIN INTERCEPTOR SEWER (CONT. FROM P-3)												
18+00	142.70	130.85	11.8									
							2004 00142		233 Maple Dunes		1-15-04	
19+00	142.30	131.25	11.1									
	142.30	131.38 out	10.9	19+31.11 = 0+00 L-4				2002 02458		231 Maple Dunes		9-6-02
	142.30	131.48	10.8		4" SCH40 DL TAP 20+39.3		2000 01603	2002 02459	209 MAPLE DUNES	229 Maple Dunes	7-12-00	9-6-02
20+00	140.30	131.75	8.6									
						4" SCH40 DL TAP 20+84.11	98-18277	2000-01752	213 S. Maple Dunes	225 Maple Dunes	9-23-98	7-16-01
21+00	139.00	132.15	6.9			4" SCH40 21+42.3		2000 02732		221 Maple Dunes		12-18-00
	138.70	132.39	6.3	21+59.38	4" STUB NE 132.49							
0+00 L-3	136.60	127.28	9.3	0+00 = 8+08.01 L-2		4" SCH40 0+11		2000-00463		290 S Maple Dunes		2-18-00
1+00	139.00	127.68	11.3			4" SCH40 1+14.72		2005-03009		292 S Maple Dunes		1-9-05
	139.70	127.72 out	12.0	1+10.72								
	139.70	127.82 in	11.9									
	140.00	128.12 out	11.9	1+86.00		4" STUB SW 128.55		2002 02550		294 Maple Dunes		9-17-02
	140.00	128.22 in	11.8									
2+00	139.60	128.28	11.3									
								2001 02964		226 Maple Dunes		11-2001
3+00	138.70	128.68	10.0									
	138.60	128.79 out	9.8	3+29.51				2002 00575		227 Maple Dunes		3-4-02
	138.60	128.89 in	9.7									
4+00	138.50	129.17	9.3					99-90847		218 S Maple Dunes		4-29-99
								2003 00263		2 Maple Dunes		1-30-04
5+00	138.90	129.57	9.3					2002-02287		210 S. Maple Dunes		8-21-02
6+00	139.30	129.97	9.3					2001-01077		206 S Maple Dunes		5-2-01
7+00	139.60	130.37	9.2									
	140.10	130.41	9.7	7+09.23		4" STUB SW 130.74		98-16557		202 S Maple Dunes		8-26-98
0+00 L-4	142.30	131.48	10.8	0+00 = 19+31.11 L-2								
							2000-00464		201 S Maple Dunes		2-18-00	
1+00	142.80	131.88	10.9				2003 02776	2001-03146	205 Maple Dunes	237 S Maple Dunes	12-27-03	12-11-01
	143.40	131.96	11.4	1+20.86		4" STUB SW 132.30		2001-02969		241 S Maple Dunes		11-20-01