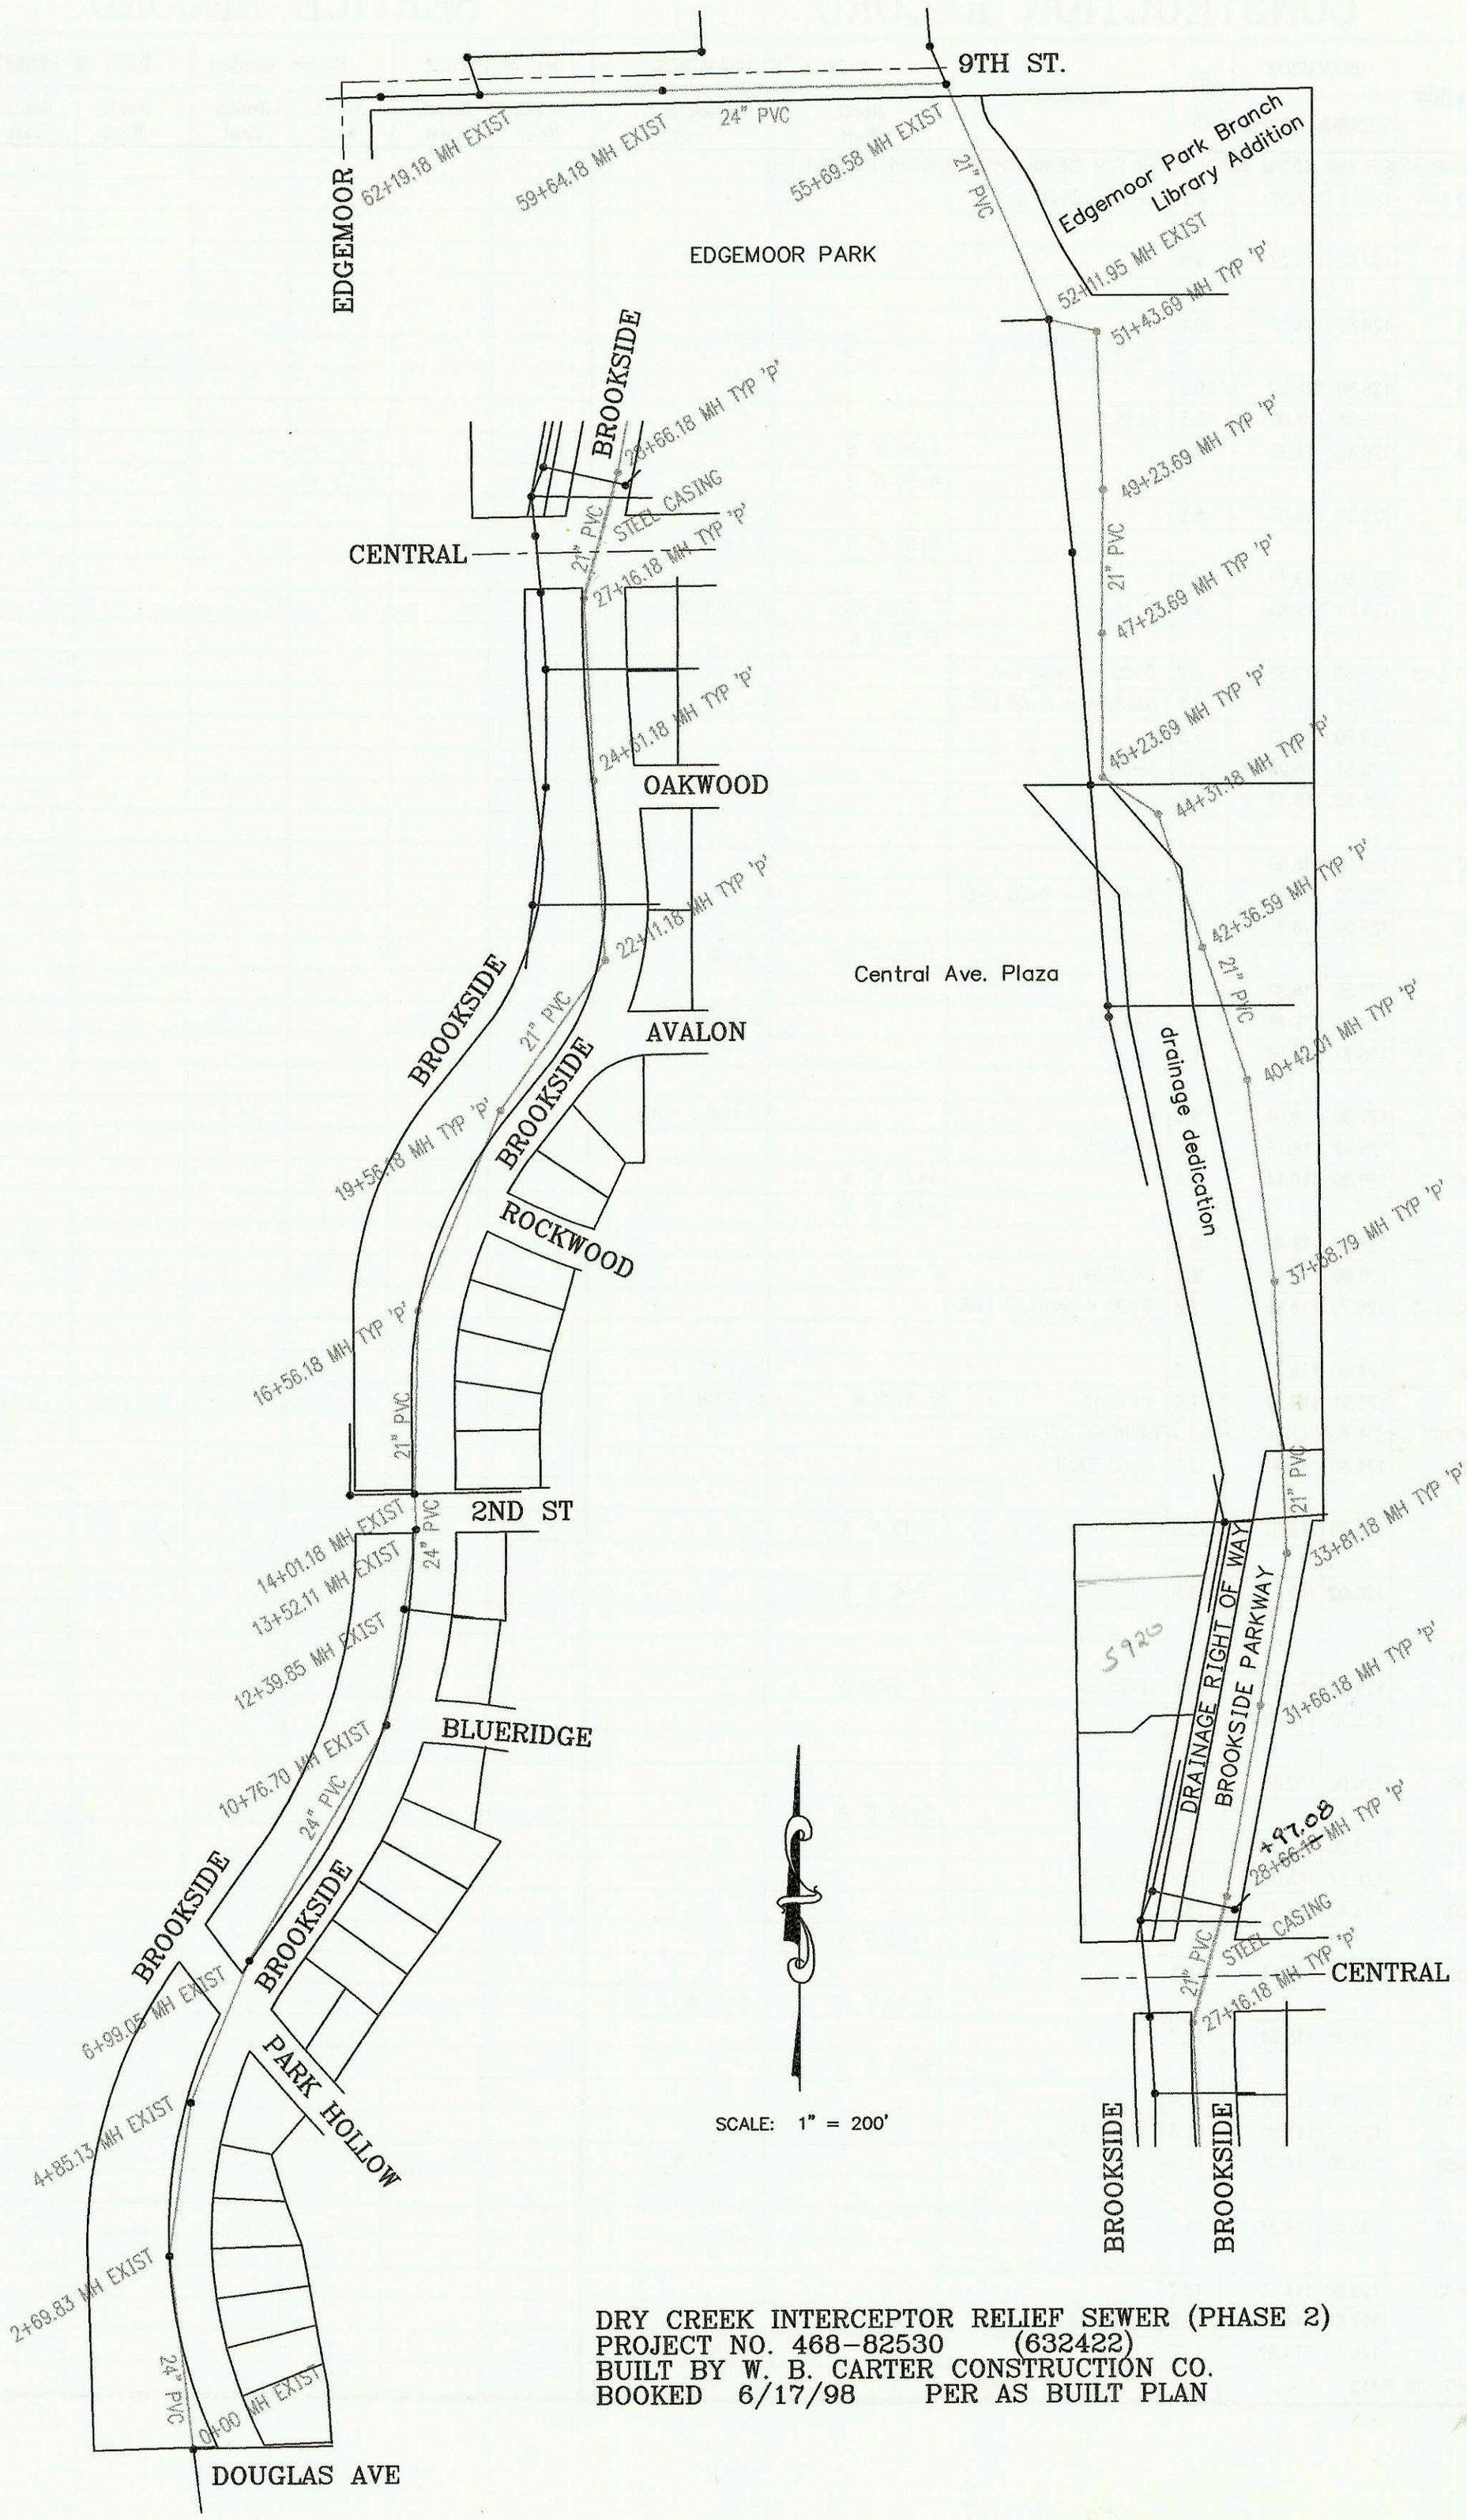

DRY CREEK INTERCEPTOR RELIEF SEWER (PHASE 2)
PROJECT NO. 468-82530 (632422)
BUILT BY W. B. CARTER CONSTRUCTION CO.
BOOKED 6/17/98 PER AS BUILT PLAN

CONSTRUCTION RECORD							SERVICE RECORD					
STATION	ELEVATION		DEPTH	MANHOLE	4-INCH "Y" BRANCHES		No. of Permit		House Number		DATE OF PERMITS	
	GROUND	GRADE			North West	South East	North West	South East	North West	South East	North West	South East
DRY CREEK	INTERCEPTOR RELIEF SEWER (PHASE 2)											
0+00	165.79	155.14	10.6	0+00 EXIST								
1+00	165.40	155.39	10.0									
2+00	166.10	155.64	10.5									
	165.59	155.81	9.8	2+69.83								
3+00	166.00	155.85	10.2									
4+00	166.90	155.98	10.9									
	167.01	156.09	10.9	4+85.13								
5+00	167.10	156.11	11.0									
6+00	167.60	156.24	11.4									
	167.30	156.37	10.9	6+99.05								
8+00	166.60	156.50	10.1									
9+00	167.00	156.63	10.4									
10+00	168.00	156.76	11.2									
11+00	168.50	156.89	11.6									
12+00	169.20	157.02	12.2									
	169.49	157.07	12.4	12+39.85								
13+00	169.10	157.15	11.9									
	169.82	157.22	12.6	13+52.11								
	170.09	157.29 out	12.8	14+01.18								
	170.09	157.41 in	12.7									
15+00	170.50	157.56	12.9									
16+00	171.10	157.71	13.4									
	171.50	157.79 out	13.7	16+56.18								
	171.50	157.84 in	13.7									
17+00	171.50	157.91	13.6									
18+00	172.00	158.06	13.9									
19+00	172.20	158.21	14.0									
	172.90	158.29 out	14.6	19+56.18								
	172.90	158.34 in	14.6									
20+00	172.70	158.41	14.3									
21+00	173.30	158.56	14.7									
22+00	173.60	158.70	14.9									
	173.78	158.72 out	15.1	22+11.18								
	173.78	158.82 in	15.0									
23+00	172.70	158.94	13.8									
24+00	173.90	159.07	14.8									
	174.30	159.15 out	15.1	24+61.18								
	174.30	159.20 in	15.1									
25+00	174.10	159.26	14.8									
26+00	175.10	159.41	15.7									
27+00	176.90	159.56	17.3									
	176.90	159.59 out	17.3	27~~+37.18~~ +16.18								
	176.90	159.64 in	17.3									
28+00	177.40	159.76	17.6									
	179.30	159.91 out	19.4	28+97.08								
	179.30	159.96 in	19.3									
30+00	178.90	160.11	18.8									
31+00	178.10	160.26	17.8									
	178.70	160.36 out	18.3	31+66.18								
	178.70	160.41 in	18.3									
32+00	178.40	160.55	17.9									
33+00	178.40	160.96	17.4									
	179.40	161.30 out	18.1	33+81.18								
	179.40	161.35 in	18.1									
34+00	179.60	161.43	18.2									
35+00	180.30	161.83	18.5									
36+00	180.70	162.23	18.5									
37+00	181.30	162.62	18.7									
	181.60	162.86 out	18.7	37+58.79								
	181.60	162.91 in	18.7									
38+00	181.40	163.07	18.3									
39+00	183.60	163.47	20.1									
40+00	184.80	163.87	20.9									
	185.30	164.04 out	21.3	40+42.01								
	185.30	164.09 in	21.2									
41+00	184.10	164.31	19.8									
42+00	182.80	164.70	18.1									
	184.20	164.84 out	19.4	42+36.59								
	184.20	164.89 in	19.3									
43+00	183.20	165.14	18.1									

CONT. ON P-13