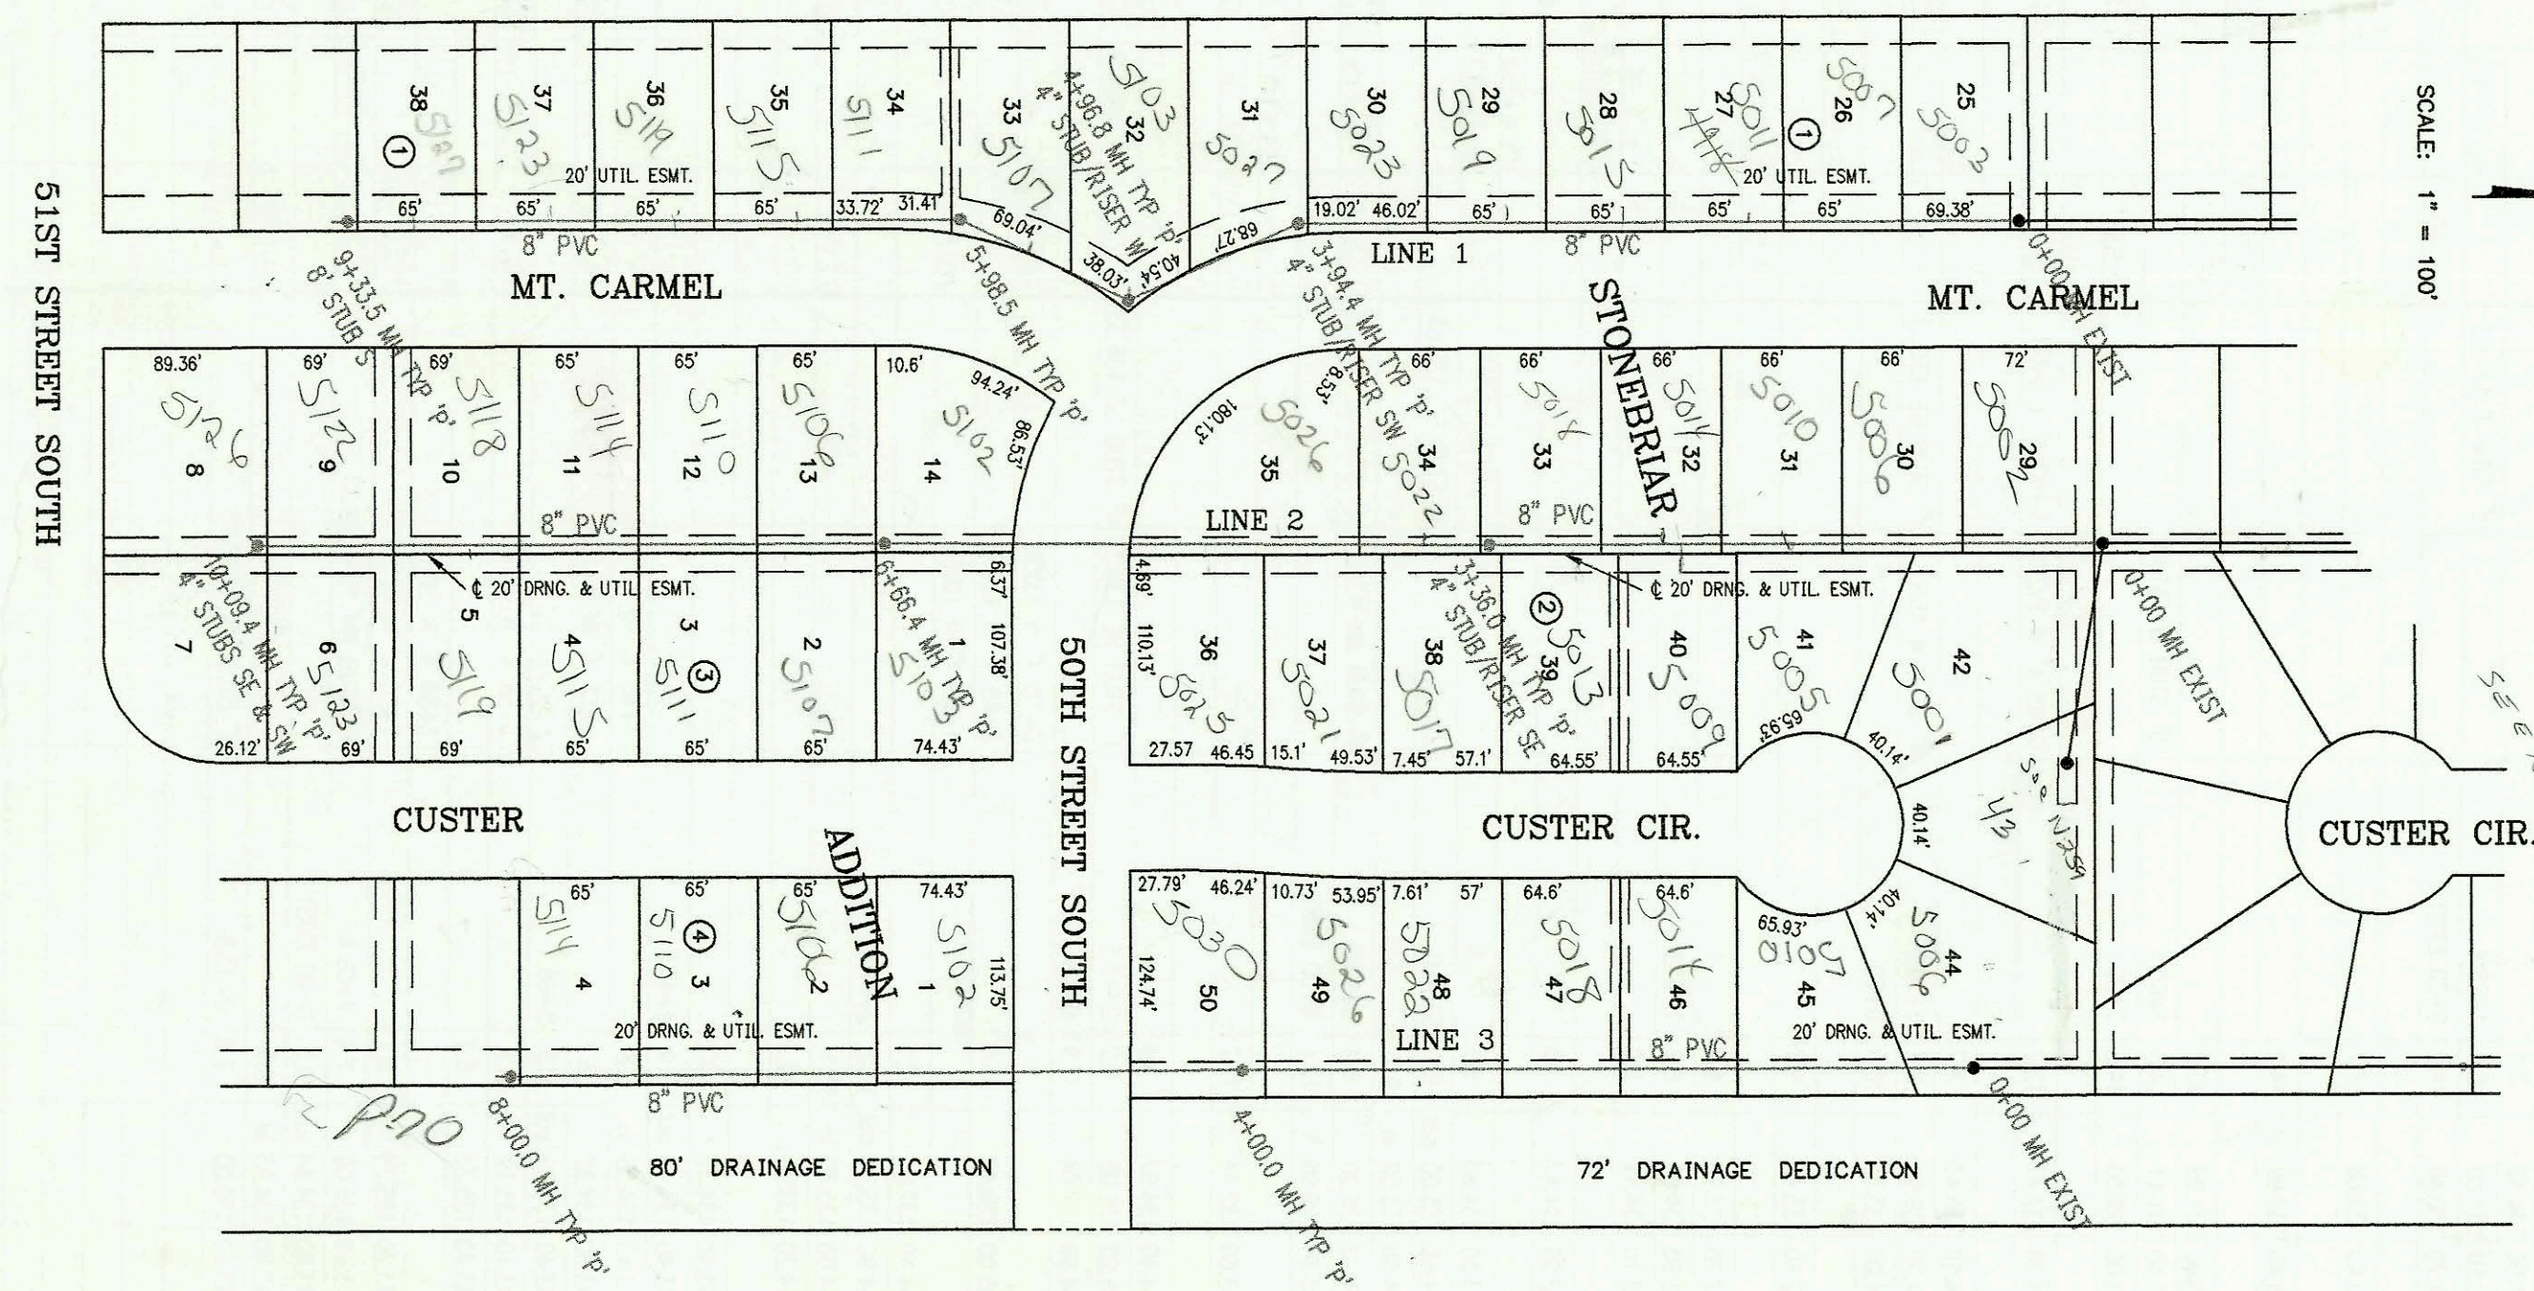

SCALE: 1" = 100'

LATERAL 372, SOUTHWEST INTERCEPTOR SEWER
PROJECT NO. 468-82640 (743435)
BUILT BY MIES CONSTRUCTION CO.
BOOKED 8/3/98 PER PLAN

P-25A

P-25

CONSTRUCTION RECORD							SERVICE RECORD					
STATION	ELEVATION		DEPTH	MANHOLE	4-INCH "Y" BRANCHES		No. of Permit		House Number		DATE OF PERMITS	
	GROUND	GRADE			North West	South East	North West	South East	North West	South East	North West	South East
LATERAL 372, SOUTHWEST INTERCEPTOR SEWER												
0+00 L-1	89.20	73.61	15.6	0+00 EXIST								
					0+18 4" W 12V15H		98-21463-7		5003 Mt Carmel		11-9-98	
1+00	89.30	73.91	15.4		0+86 4" W 12V15H		98-21466-7		5007 Mt Carmel		11-9-98	
					1+51 4" W 12V15H							
2+00	89.90	74.21	15.7		2+16 4" W 12V15H		99-11889-7		5015 Mt Carmel		6-3-99	
					2+81 4" W 12V15H		98-19442-7		5019 Mt Carmel		10-12-98	
3+00	90.50	74.52	16.0		3+46 4" W 12V15H		99-461-7		5023 Mt Carmel		1-6-99	
	90.80	74.80 out	16.0	3+94.4	4" SW 12V15H		98-21467-7		5027 Mt Carmel		11-9-98	
	90.80	74.90 in	15.9									
4+00	90.60	74.92	15.7									
	90.50	75.21 out	15.3	4+96.8	4" W 11V18H		99-3993-7		5133 Mt Carmel		3-3-99	
	90.50	75.31 in	15.2									
5+00					5+56 4" NW 11V19H		99-1068-7		5107 Mt Carmel		1-18-99	
	90.80	75.62 out	15.2	5+985								
	90.80	75.72 in	15.1									
6+00					6+25 4" W 11V15H		99-6034-7		5111 Mt Carmel		4-1-99	
					6+90 4" SCH40 4" W 10V15H		99-00780		5115 Mt Carmel		9-28-99	
7+00	90.00	76.03	14.0									
					4" SCH40 7+55 4" W 9V15H		98-		5119 Mt Carmel		12-7-98	
8+00	88.50	76.33	12.2		4" SCH40 8+20 4" W 8V15H		1999-00474		5123 Mt Carmel		8-23-99	
9+00	87.20	76.63	10.6		4" SCH 40 9+65.5		1999-00406		5127 Mt Carmel		8-24-99	
	86.90	76.73	10.2	9+33.5		8" STUB S 76.83						
0+00 L-2	86.20	75.01	11.2	0+00 EXIST								
							98-19439-7	98-19434-7	5002 Mt Carmel	5001 Custer Ck	10-12-98	10-12-98
1+00	87.20	75.31	11.9				98-19440-7		5006 Mt Carmel		10-12-98	
					1+70 4" W 9V5H		98-	98-	5010 Mt Carmel	5005 Custer	12-7-98	12-7-98
2+00	88.50	75.61	12.9			2+30 4" E 10V15H		99-1059-7		5009 Custer		1-18-99
					2+40 4" W 10V5H	2+87 4" E 10V15H	99-6033-7	99-451-7	5017 Mt Carmel	5013 Custer	4-1-99	1-6-99
3+00	89.80	75.91	13.9		2+97 4" W 10V5H							
	90.60	76.02	14.6	3+36.0		4" SE 11V15H		99-2310-7		5017 Custer		2-4-99
4+00	90.90	76.21	14.7		3+70 4" W 10V5H	4+16 4" E 10V15H	99-3990-7	98-19435-7	5022 Mt Carmel	5021 Custer Ck	3-3-99	10-12-98
					4+49 4" W 11V5H		98-19443-7		5026 Mt Carmel		10-12-98	
5+00	90.00	76.52	13.5			4+91 4" E 10V15H		98-21459-7		5025 Custer Ck		11-9-98
6+00	89.60	76.82	12.8		6+25 4' W 9V5H	6+30 4" E 9V15H	98-21464-7	98-21468-7	5102 Mt Carmel	5103 Custer	11-9-98	11-9-98
	89.30	77.02	12.3	6+66.4								
7+00	88.50	77.12	11.4				99-6038-7	99-448-7	5106 Mt Carmel	5107 Custer	4-1-99	1-6-99
8+00	87.50	77.42	10.1				SWK 1999-00061	99-459-7	5110 Mt Carmel	5111 Custer	6-25-99	1-6-99
9+00	86.40	77.72	8.7		4" SCH 40 8+42.4	4" SCH40 8+29.4	1999-00504	PA00510	5114 Mt Carmel	5115 Custer	8-25-99	8-25-99
						4" SCH40 8+94.4 DL TAP	1999-00345	2000 01297	5118 Mt Carmel	5119 Custer	8-6-99	5-26-00
10+00	86.90	78.02	8.9			4" SCH40 9+76.9	1999-00397	2000 00410	5122 Mt Carmel	5123 Custer	8-6-99	
	87.40	78.05	9.4	10+09.4	4" STUB SW 78.38	4" SCH40 4" STUB SE 78.38	99-11886-7	1999-00558	5126 Mt Carmel	5127 Custer	6-3-99	8-31-99
0+00 L-3	87.10	75.08	12.0	0+00 EXIST			99-3992-7		5006 Custer Ck		3-3-99	
1+00	85.20	75.38	9.8		4" SCH40 DL 0+92 TAP		2000-01784		5010 Custer		8-4-00	
							SWK 1999-00062		5014 Custer		6-29-99	
2+00	84.80	75.68	9.1									
							99-9348-7		5018 Custer Ck		5-5-99	
3+00	84.40	75.98	8.4		4" SCH40 DL 3+00 TAP		2000 01428		5022 Custer		6-14-00	
							99-9355-7		5026 Custer		5-5-99	
4+00	84.10	76.28	7.8	4+00.0			99-6037-7		5030 Custer		4-1-99	
5+00	86.50	76.58	9.9				99-452-7		5102 Custer		1-6-99	
6+00	85.00	76.88	8.1				99-9345-7		5106 Custer		5-5-99	
7+00	84.70	77.18	7.5		4" SCH40 DL 7+06 TAP		2000-012191		5110 Custer		5-25-00	
					4" SCH40 DL 7+68 TAP		2000 1842		5114 Custer		8-16-00	
8+00	85.50	77.48	8.0	8+00.0		8" STUB S 77.58						