


SCALE: 1" = 100'

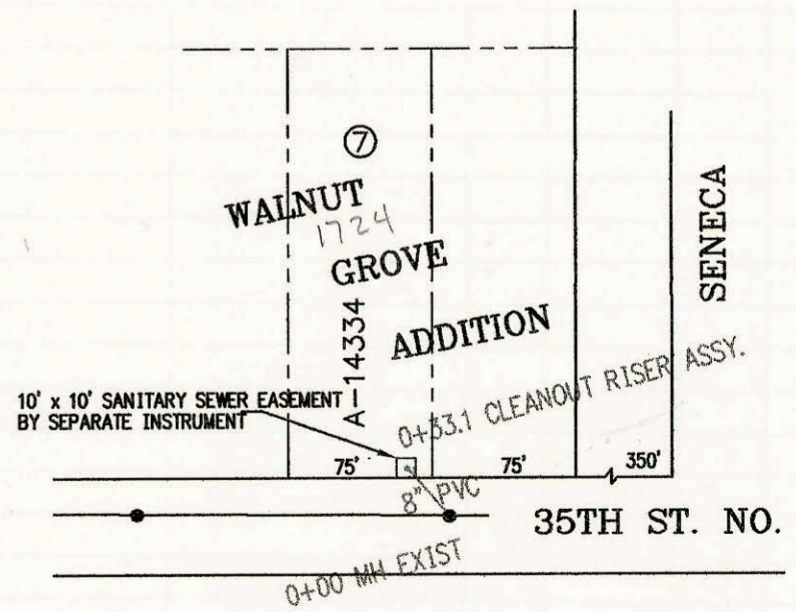

SCALE: 1" = 100'



LATERAL 136, MAIN 4, SANITARY SEWER NO. 23
 PROJECT NO. 468-82826 (743468)
 BUILT BY K. C. EXCAVATING, INC.
 BOOKED 10/1/98 PER PLAN

