SANITARY SEWER IMPROVEMENTS FOR CENTRAL RIVERSIDE PARK
PROJECT NO. 468-82399 (623124)
BOOKED 1/5/99 PER PLAN

SCALE: 1" = 200'

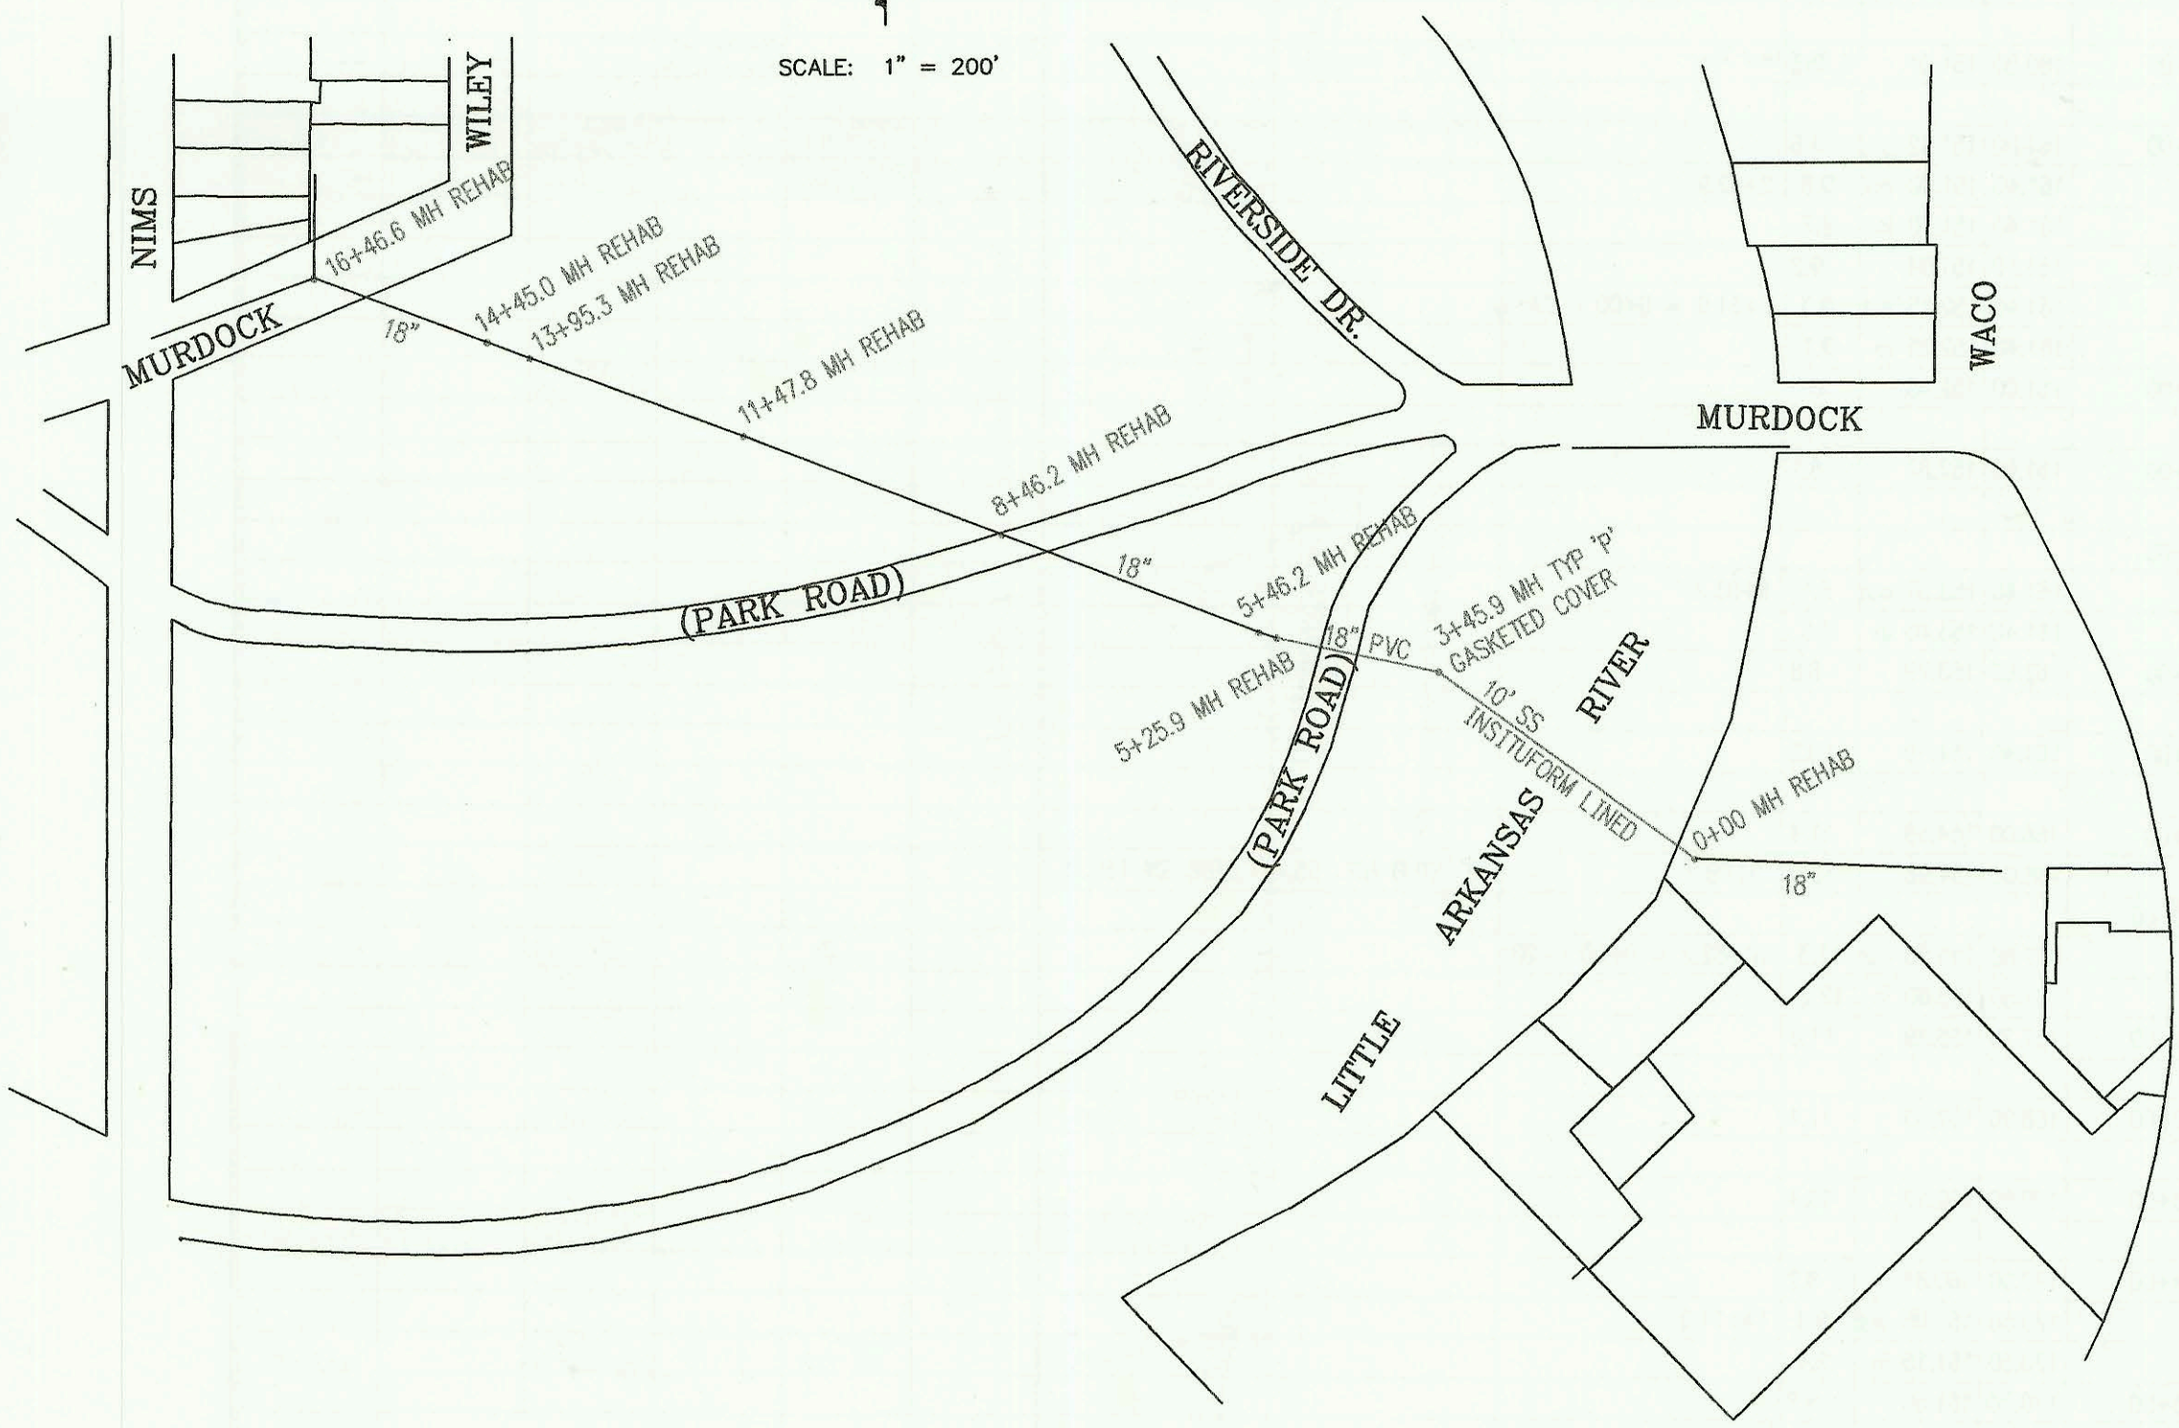

CONSTRUCTION RECORD							SERVICE RECORD					
STATION	ELEVATION		DEPTH	MANHOLE	4-INCH "Y" BRANCHES		No. of Permit		House Number		DATE OF PERMITS	
	GROUND	GRADE			North West	South East	North West	South East	North West	South East	North West	South East
SANITARY SEWER IMPROVEMENTS FOR CENTRAL RIVERSIDE PARK												
0+00	117.41	101.06	16.4	0+00								
	111.50	???		3+45.9								
	114.95	104.24 out	10.7	5+25.9								
	114.95	104.39 in	10.6									
	115.05	104.50	10.5	5+46.2								
	112.77	103.77 out	9.0	8+46.2								
	112.77	104.87 in	7.9									
	114.51	104.92 out	9.6	11+47.8								
	114.51	105.02 in	9.5									
	112.60	105.41	7.2	13+95.3								
	112.07	105.02 out	7.0	14+45.0								
	112.07	105.07 in	7.0									
	111.18	105.54 out	5.6	16+46.6								
	111.18	105.99 in	5.2									