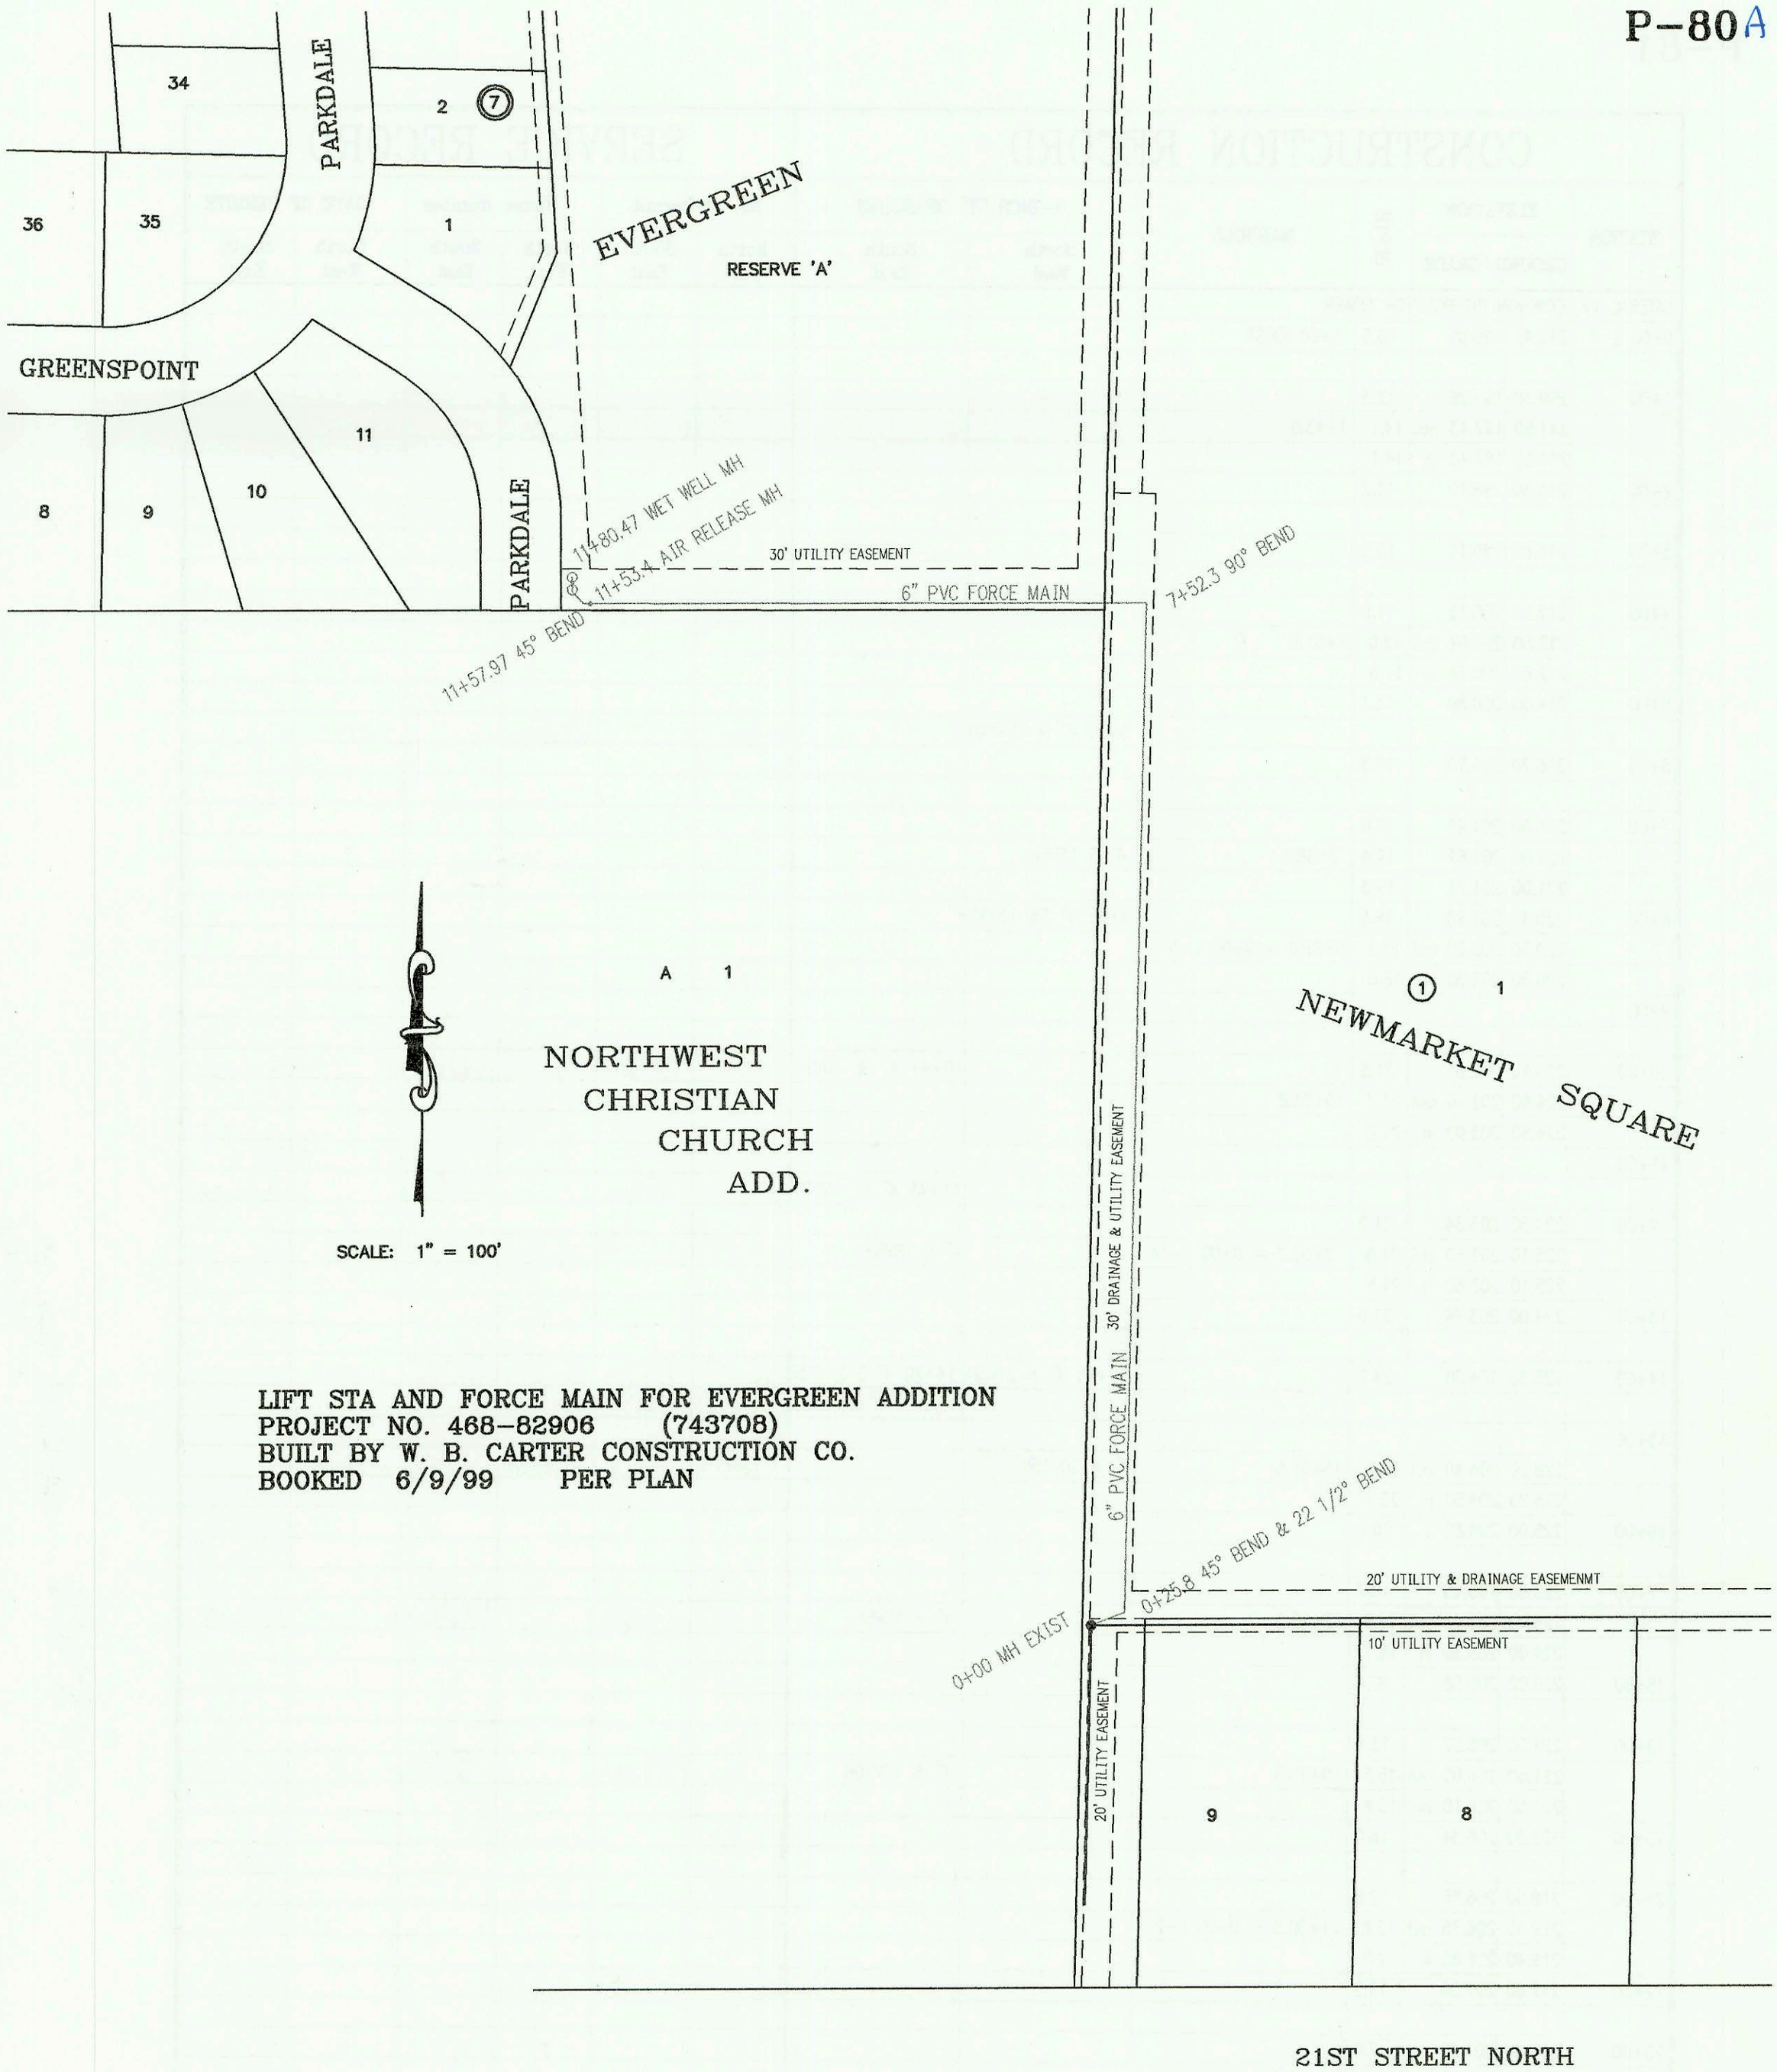

LIFT STA AND FORCE MAIN FOR EVERGREEN ADDITION
PROJECT NO. 468-82906 (743708)
BUILT BY W. B. CARTER CONSTRUCTION CO.
BOOKED 6/9/99 PER PLAN

CONSTRUCTION RECORD							SERVICE RECORD					
STATION	ELEVATION GROUND	ELEVATION GRADE	DEPTH	MANHOLE	4-INCH "Y" BRANCHES North West	4-INCH "Y" BRANCHES South East	No. of Permit North West	No. of Permit South East	House Number North West	House Number South East	DATE OF PERMITS North West	DATE OF PERMITS South East
Lift Station and Force Main for Evergreen Addition												
0+00	162.90	150.48 out	12.4	0+00 EXIST								
	162.90	157.50 in	5.4									
	163.00	157.49	5.5	0+25.8 45d BEND & 22	1/2d BEND							
1+00	163.30	157.47	5.8									
2+00	163.50	157.45	6.1									
3+00	163.50	157.42	6.1									
4+00	163.50	157.40	6.1									
5+00	163.60	157.37	6.2									
6+00	163.60	157.35	6.3									
7+00	163.60	157.32	6.3									
	163.60	157.30	6.3	7+52.3 90d BEND								
8+00	162.10	157.29	4.8									
9+00	162.20	157.27	4.9									
10+00	162.50	157.24	5.3	PVI								
11+00	163.20	159.04	4.2									
	164.00	160.00	4.0	11+53.4 AIR RELEASE								
	164.00	160.00	4.0	11+57.97 45d BEND								
	165.00	160.00	5.0	11+77 WET WELL MH								
LATERAL 17, COWSKIN INTERCEPTOR SEWER (CONT. FROM P-82)												
10+00	232.60	222.12	10.5									
	233.40	222.30	11.1	10+29.5	8" STUB W 222.40							
0+00 L-3A	231.00	219.95	11.1	0+00 = 5+93.2 L-3								
	231.00	221.45	9.6	0+96.0	4" STUB W 221.80 4"SCH40	4" STUB N 221.80 4"SCH40	2001 00665	2006-01322	15504 McCormick	15412 W McCormick	3-27-01	6-21-06
0+00 L-3B	231.70	220.95	10.8	0+00 = 8+08.8 L-3								
1+00	231.40	221.38	10.0									
	231.70	221.40 out	10.3	1+05.1	4" STUB NE 221.75		2002 02173		15508 McCormick		10-10-02	
	231.70	221.50 in	10.2				2002 00238		15602 McCormick		12-5-03	
2+00	232.20	221.88	10.3									
2+32.2	232.50	222.01	10.5	~~CAP~~ 8" Cleanout Riser Assy. installed with Lat 1B C15								