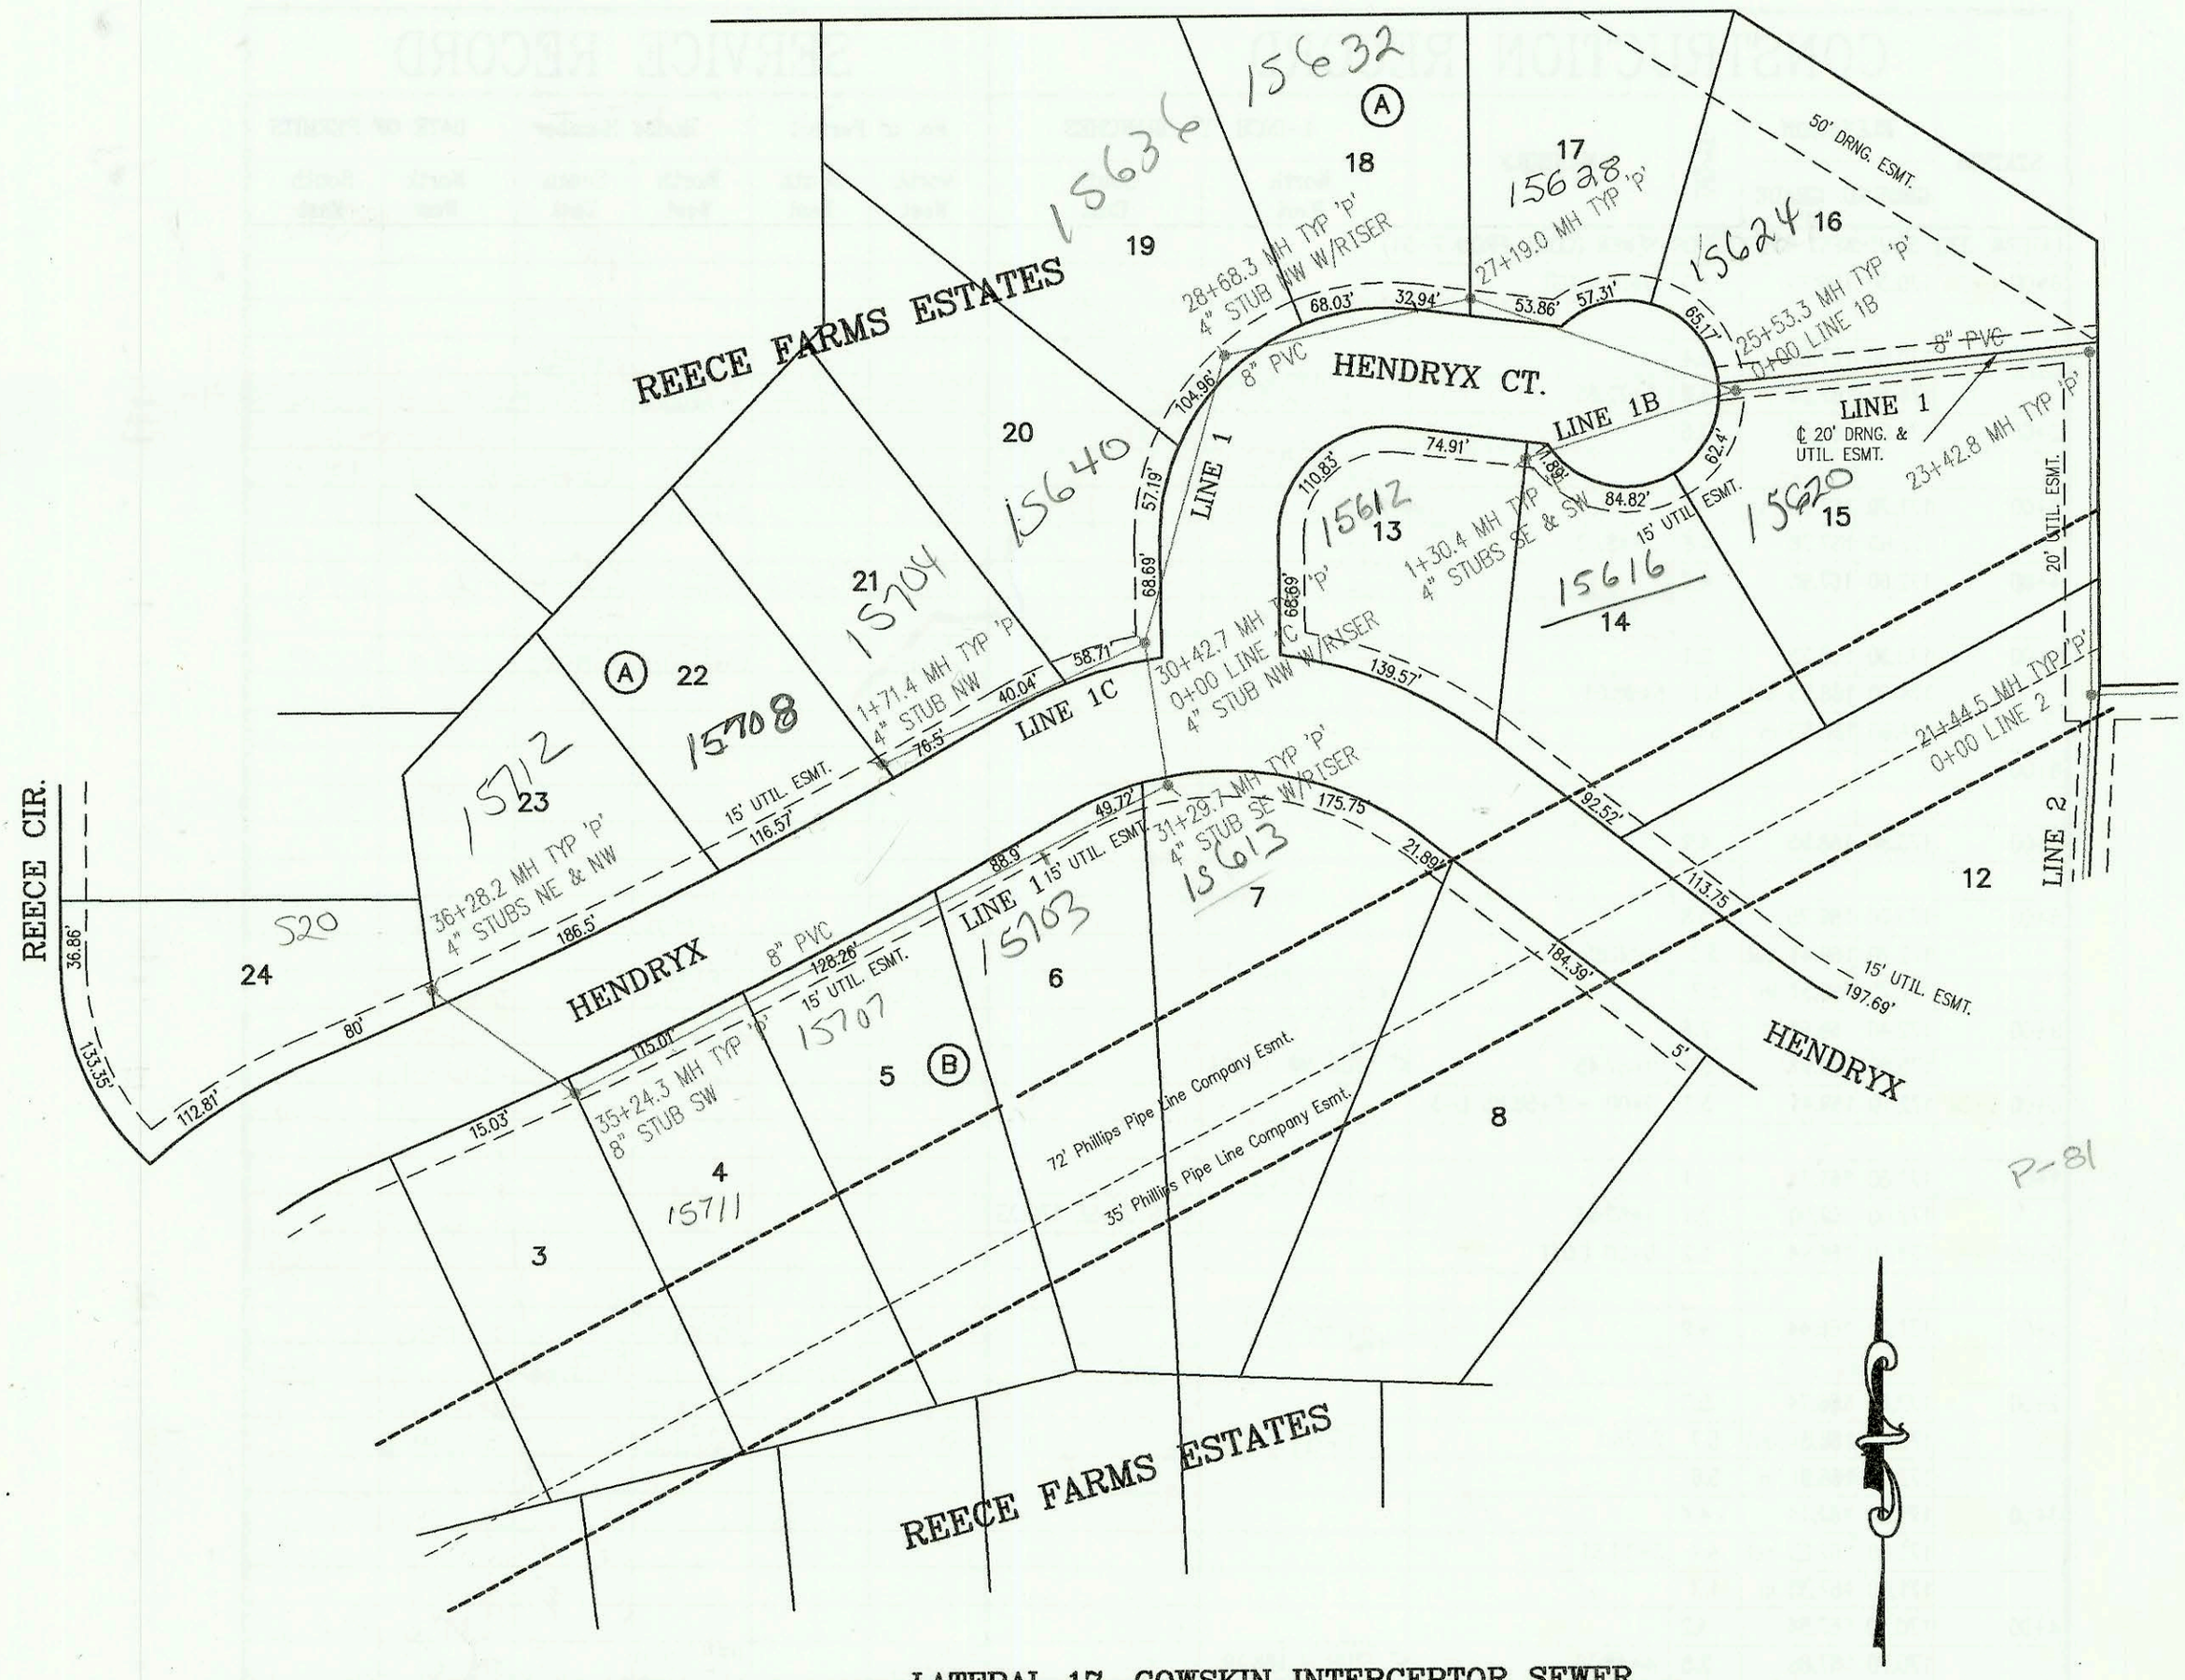

LATERAL 17, COWSKIN INTERCEPTOR SEWER
PROJECT NO. 468-82830 (743484)
BUILT BY MIES CONSTRUCTION CO.
BOOKED 6/14/99 PER AS BUILT PLAN

SCALE: 1" = 100'

	CONSTRUCTION RECORD							SERVICE RECORD					
	STATION	ELEVATION GROUND	ELEVATION GRADE	DEPTH	MANHOLE	4-INCH "Y" BRANCHES North West	4-INCH "Y" BRANCHES South East	No. of Permit North West	No. of Permit South East	House Number North West	House Number South East	DATE OF PERMITS North West	DATE OF PERMITS South East
	LATERAL 17, COWSKIN INTERCEPTOR SEWER (CONT. FROM P-81)												
L-1 CONT.	28+00	225.00	209.68	15.3									
		228.00	209.95 out	18.1	28+68.3	4" NW 14V5H		2001 02760		15636 Hendryx		11-9-9	
		228.00	210.05 in	18.0									
	29+00	227.80	210.18	17.6									
	30+00	229.10	210.58	18.5									
		230.00	210.75 out	19.3	30+42.7 = 0+00 L-1C	4" NW 15V5H							
		230.00	210.85 in	19.1									
	31+00	231.20	211.08	20.1									
		232.40	211.20 out	21.2	31+29.7		4" SE 17V5H		2003 00396		15613 Hendryx		3-26-03
		232.40	211.30 in	21.1									
	32+00	231.40	211.58	19.8									
							32+12 4" S 16V4H		2003 01904		15703 Hendryx		9-22-03
	33+00	230.30	211.98	18.3									
							33+44 4" S 13V8H		2005-00779		15207 Hendryx		4-7-05
	34+00	229.40	212.38	17.0			4" sch 40 PVC						
							34+66 4" S 12V7H		2006-00339		15711 W Hendryx		2-7-06
	35+00	228.40	212.78	15.6									
		228.50	212.88 out	15.6	35+24.3								
		228.50	212.98 in	15.5									
	36+00	226.60	215.54	11.1									
		224.90	216.50	8.4	36+28.2	4" STUB NW 216.85	4" STUB NE 216.85	2005-01593	2004 00	5205 Reece	15713 Hendryx	6-29-05	3-19-04
	0+00 L-1A	225.10	203.60	21.5	0+00 = 12+50.2 L-1		4" SCH40 DL 0+20.6 TAP		2000-01751		15322 W Hendryx		9-11-00
		225.10	215.75	9.4	OUTSIDE DROP								
		224.80	216.00	8.8	0+58.1	4" STUB NE 216.35		2004		15324 Hendryx		7-8-04	
	0+00 L-1B	218.00	209.55	8.4	0+00 = 25+57.0 L-1								
		221.50	212.96	8.5									
		224.30	214.00	10.3	1+30.4	4" STUB SW 214.35	4" STUB SE 214.35	2004-00684	2001-01247	15612 Hendryx	15616 W Hendryx	3-15-04	5-21-01
	0+00 L-1C	230.00	210.85	19.1	0+00 = 30+46.4 L-1								
	1+00	230.70	214.73	16.0		1+21 4" N 9V8H		2004 00683		15704 Hendryx		3-15-04	
		231.90	217.50	14.4	1+71.4	4" STUB NW 217.85		2004 01204		15708 Hendryx		4-28-04	
	0+00 L-2	219.40	206.85	12.5	0+00 = 21+44.5 L-1								
	1+00	225.20	210.49	14.7									
							4" SCH40 1+11 4" E 12V15H	2003 02705	2001 01230	15600 Hendryx	15510 Hendryx	10-7-03	5-18-01
	2+00	229.80	214.13	15.7									
		231.30	217.90 out	13.4	2+93.6		4" SE 9V4H		2003				
		231.30	218.00 in	13.3									
	3+00	231.00	218.03	13.0									
	4+00	230.50	218.44	12.1					2001 03253		15601 Hendryx		12-21-01
	5+00	230.00	218.86	11.1									
		230.00	219.00	11.0	5+33.7	4" STUB W 219.35			2003 01739		15609 Hendryx		7-2-03
	0+00 L-3	220.30	202.20 out	18.1	0+00 = 8+99.1 L-1		4" SCH40 0+83.5	2000-00981		15413 W McCormick		4-20-00	
		220.30	212.00 in	8.3	OUTSIDE DROP								
	1+00	218.50	213.08	5.4				2001-01739		15409 W McCormick		7-13-01	
	2+00	219.50	214.77	4.7									
	3+00	220.50	215.25	5.3									
		221.00	215.60 out	5.4	3+32.1			2002-02233		15501 W McCormick		8-15-02	
		221.00	215.70 in	5.3									
	4+00	224.20	216.78	7.4									
	5+00	229.20	218.37	10.8			4" SCH40 5+67.2		2000-00515		15417 McCORMICK		2-25-00
		231.00	219.85 out	11.1	5+93.2 = 0+00 L-3A								
		231.00	219.95 in	11.1									
	6+00												
	7+00	230.40	220.40	10.0									
									2000-00088		15509 W McCormick		11-2-2000
	8+00	231.20	220.81	10.4			4" SCH40 7+30.3		2000-01141		15505 W McCormick		5-8-00
		231.70	220.85 in	10.8	8+08.8 = 0+00 L-3B								
		231.70	220.95 out	10.8									
	9+00	231.60	221.51	10.1									
	CONT. ON P-80												