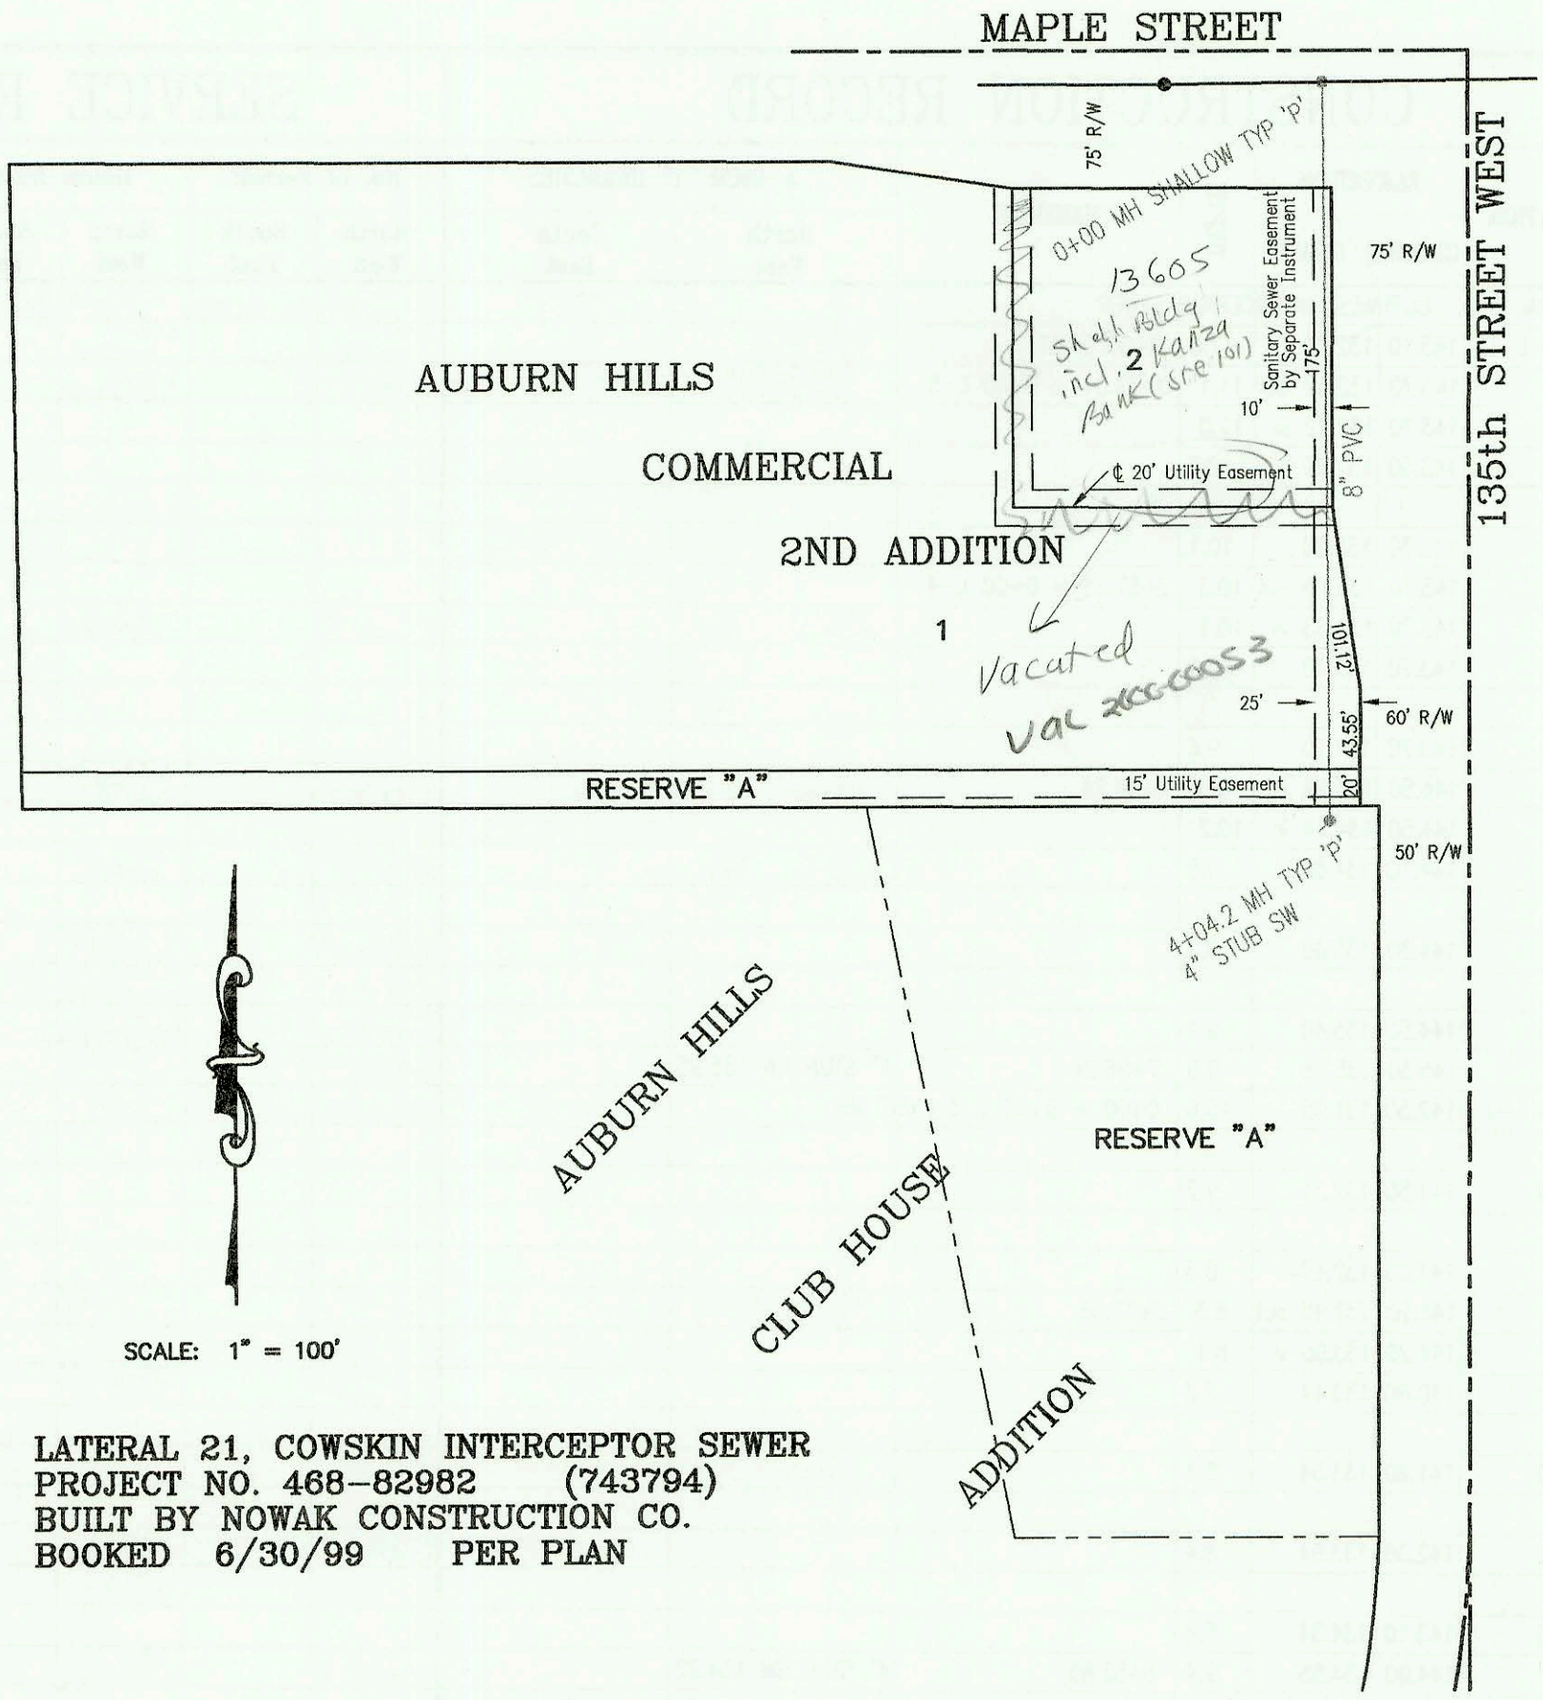

LATERAL 21, COWSKIN INTERCEPTOR SEWER
PROJECT NO. 468-82982 (743794)
BUILT BY NOWAK CONSTRUCTION CO.
BOOKED 6/30/99 PER PLAN

P-85

CONSTRUCTION RECORD							SERVICE RECORD					
STATION	ELEVATION		DEPTH	MANHOLE	4-INCH "Y" BRANCHES		No. of Permit		House Number		DATE OF PERMITS	
	GROUND	GRADE			North West	South East	North West	South East	North West	South East	North West	South East
LATERAL 21,	COWSKIN INTERCEPTOR SEWER											
0+00	151.70	145.46 out	6.2	0+00								
	151.70	146.05 in	5.6									
1+00	151.80	146.70	5.1		4" SCH40 DL 2+03 TAP		2001 010446		13605 W. Maple		4-2001	
2+00	152.40	147.35	5.0									
3+00	153.30	148.00	5.3									
4+00												
	156.95	148.68	8.3	4+04.2	4" STUB SW 149.02							